


DIMS. 400'-0" x 54'-0" MLD. x 28'-8" MLD.

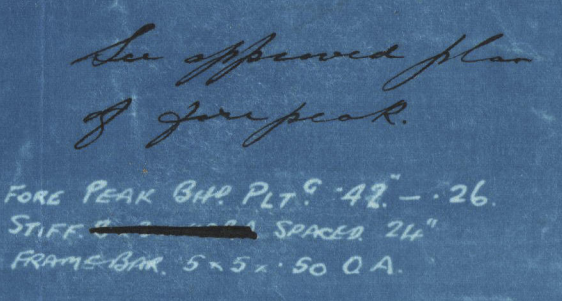

The Greenk. Dock. Co.

J. S. BARRDALE.

N. 408.

Profile & D^r plans

as Built.

Grk. Rep. N. 18479.

W148-0082



© 2021

Lloyd's Register
Foundation