


## MIDSHIP SECTION. (AS FITTED.)

SCALE  $\frac{1}{2}$  INCH = ONE FOOT.

LLOYDS CLASS 100 A1. SHELTER DECK SPECIAL SURVEY.



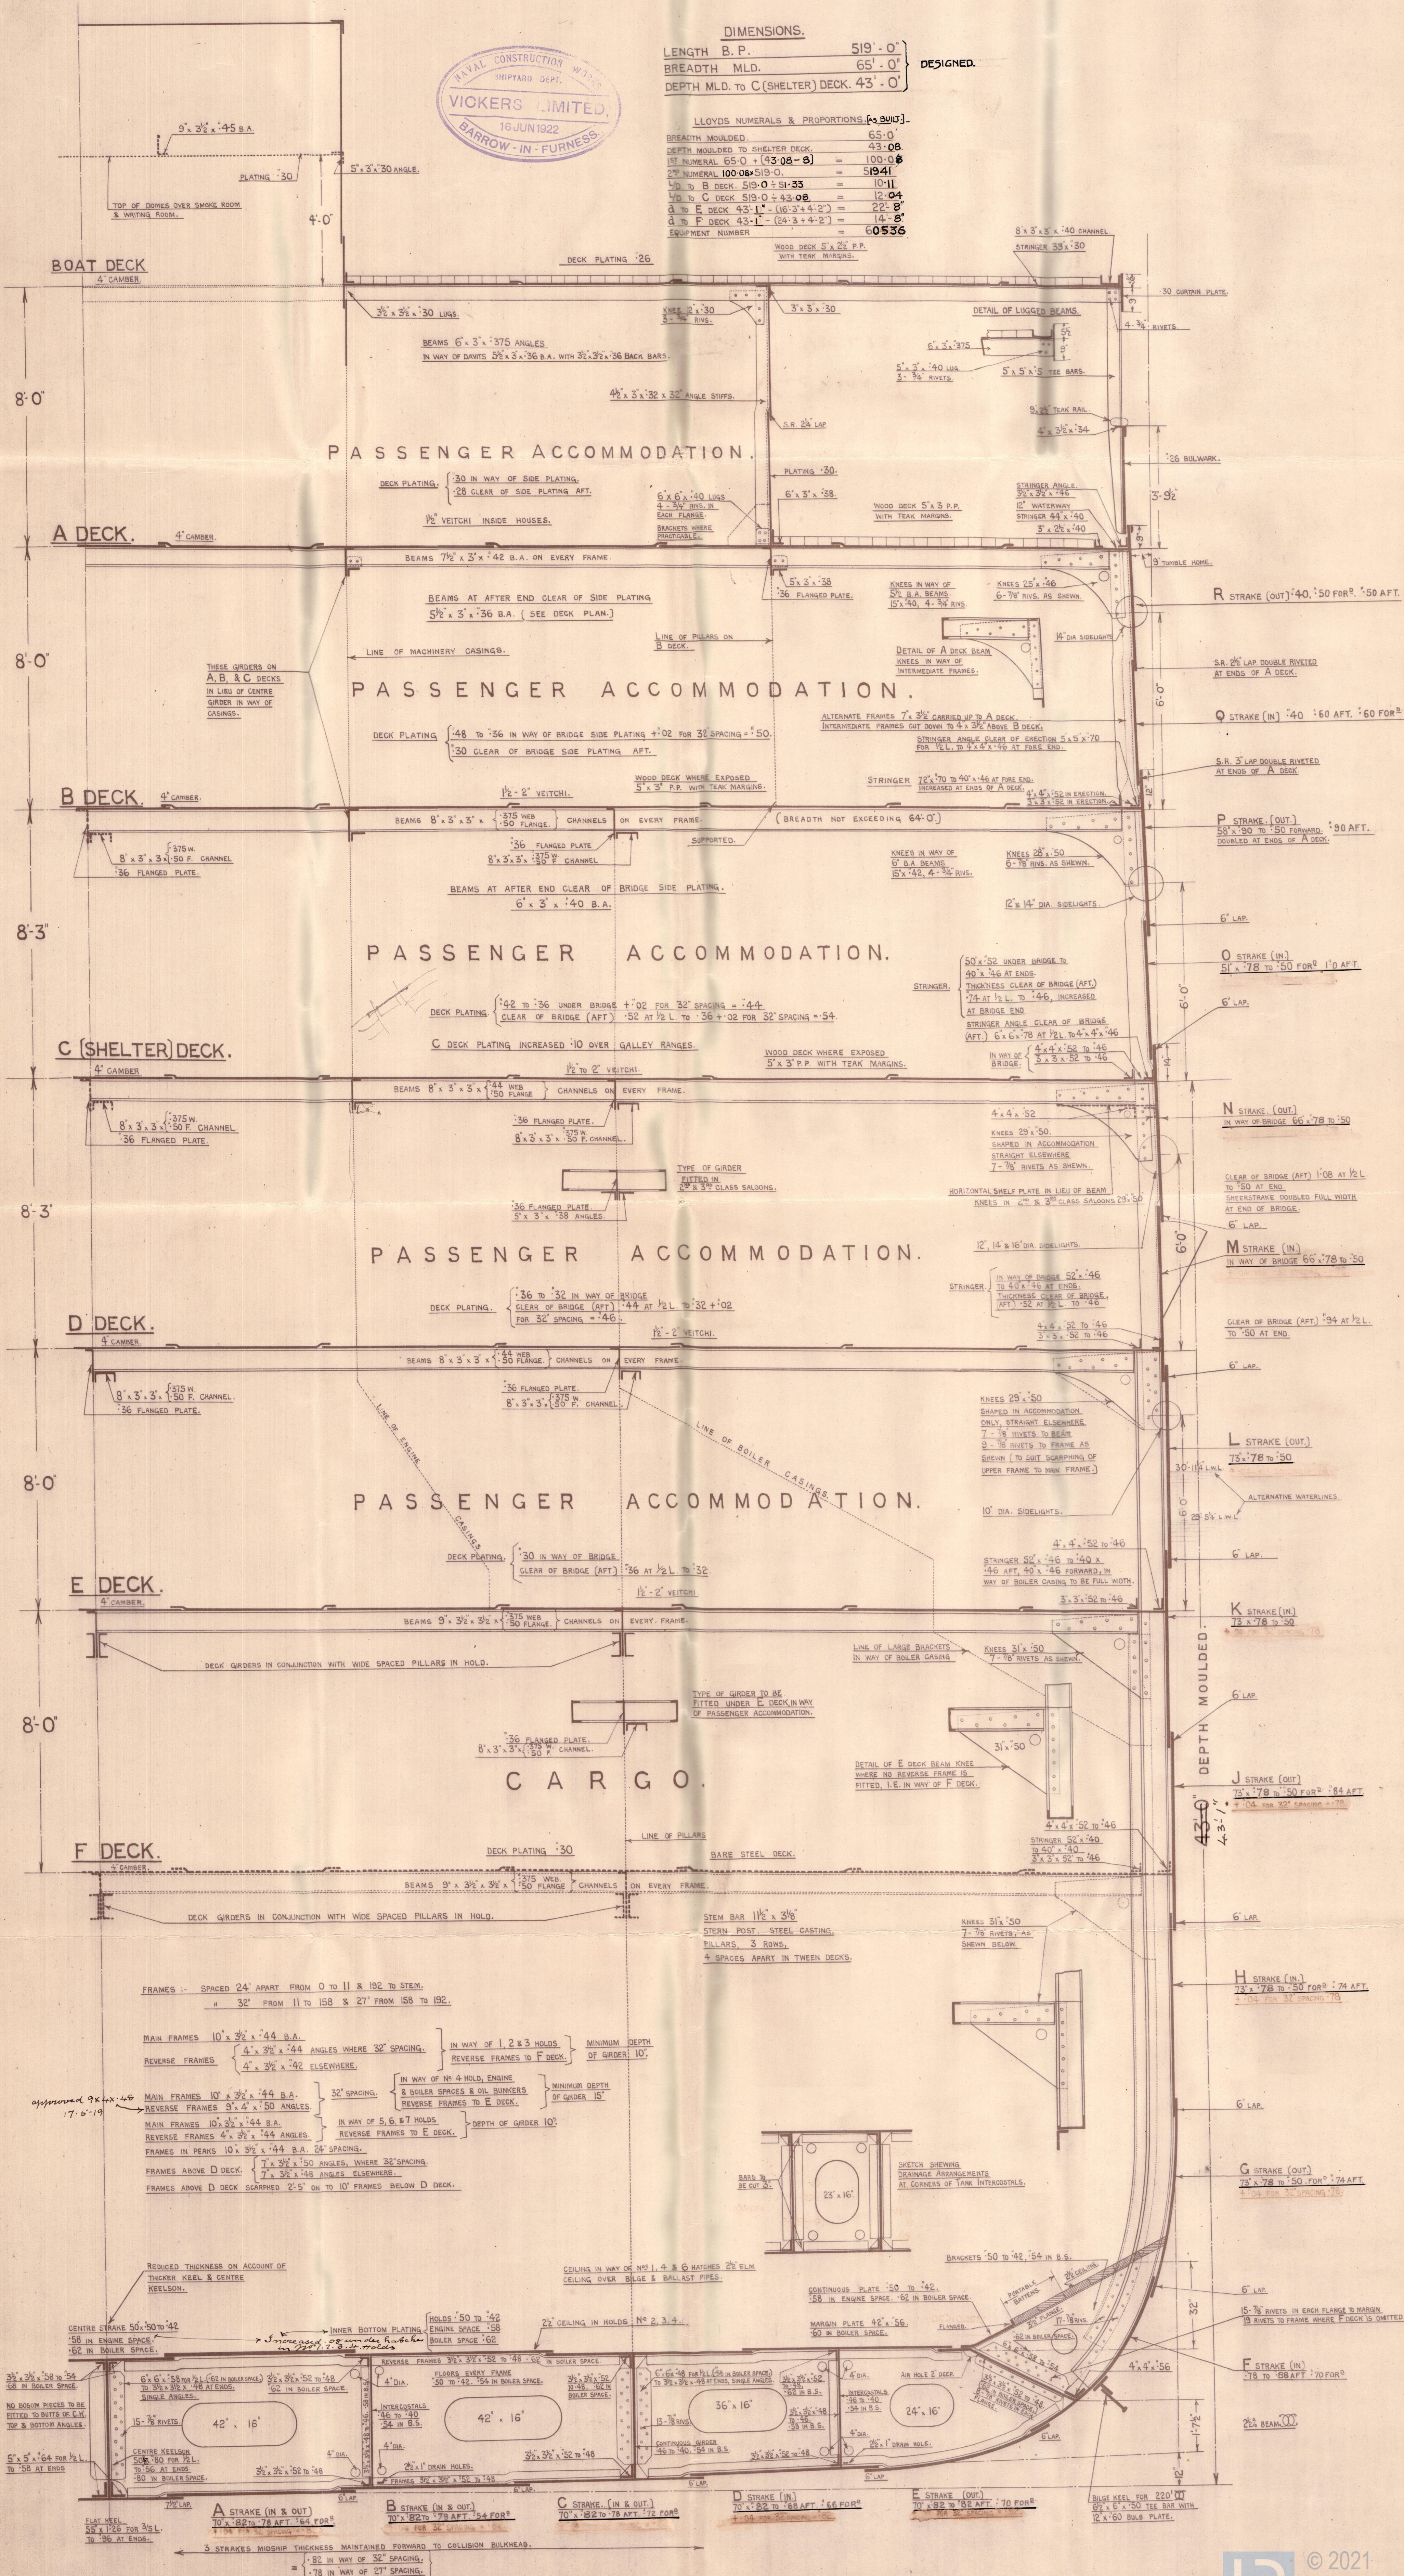

Vickers Ltd.

No. 498.

---

Midship Section.  
(as built).

---

S.S. "Antonia".

---

Embry Report No. 1967.

---



©2021

Lloyd's Register  
Foundation

W293-0017