


MIDSHIP SECTION (AS FITTED)

SCALE 1/2" = 1 FOOT.

LLOYD'S CLASS 100 A.1 SHELTER DECK. SPECIAL SURVEY.

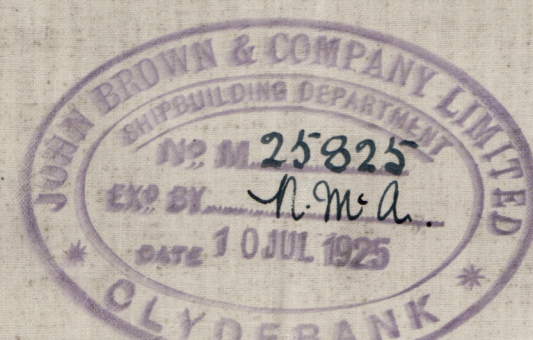


DIMENSIONS.

LENGTH B.P. 519' 0"  
BREADTH M.L.D. 65' 0"  
DEPTH M.L.D. TO 'C' (SHELTER DECK) 43' 0"

LLOYD'S NUMERALS & PROPORTIONS.

BREADTH MOULDED 65' 0"  
DEPTH MOULDED TO SHELTER DECK 43' 0"  
1<sup>ST</sup> NUMERAL 65.0 + (43-8) = 100.0  
2<sup>ND</sup> NUMERAL 100 x 519.0 = 51900  
1/2 TO 'B' DECK 519.0 + 51.25 = 10.12  
1/2 TO 'C' DECK 519.0 + 43.00 = 12.07  
1/2 TO 'E' DECK 43.0 + (16.3 + 4.2) = 22.7  
1/2 TO 'F' DECK 43.0 + (24.3 + 4.2) = 14.7

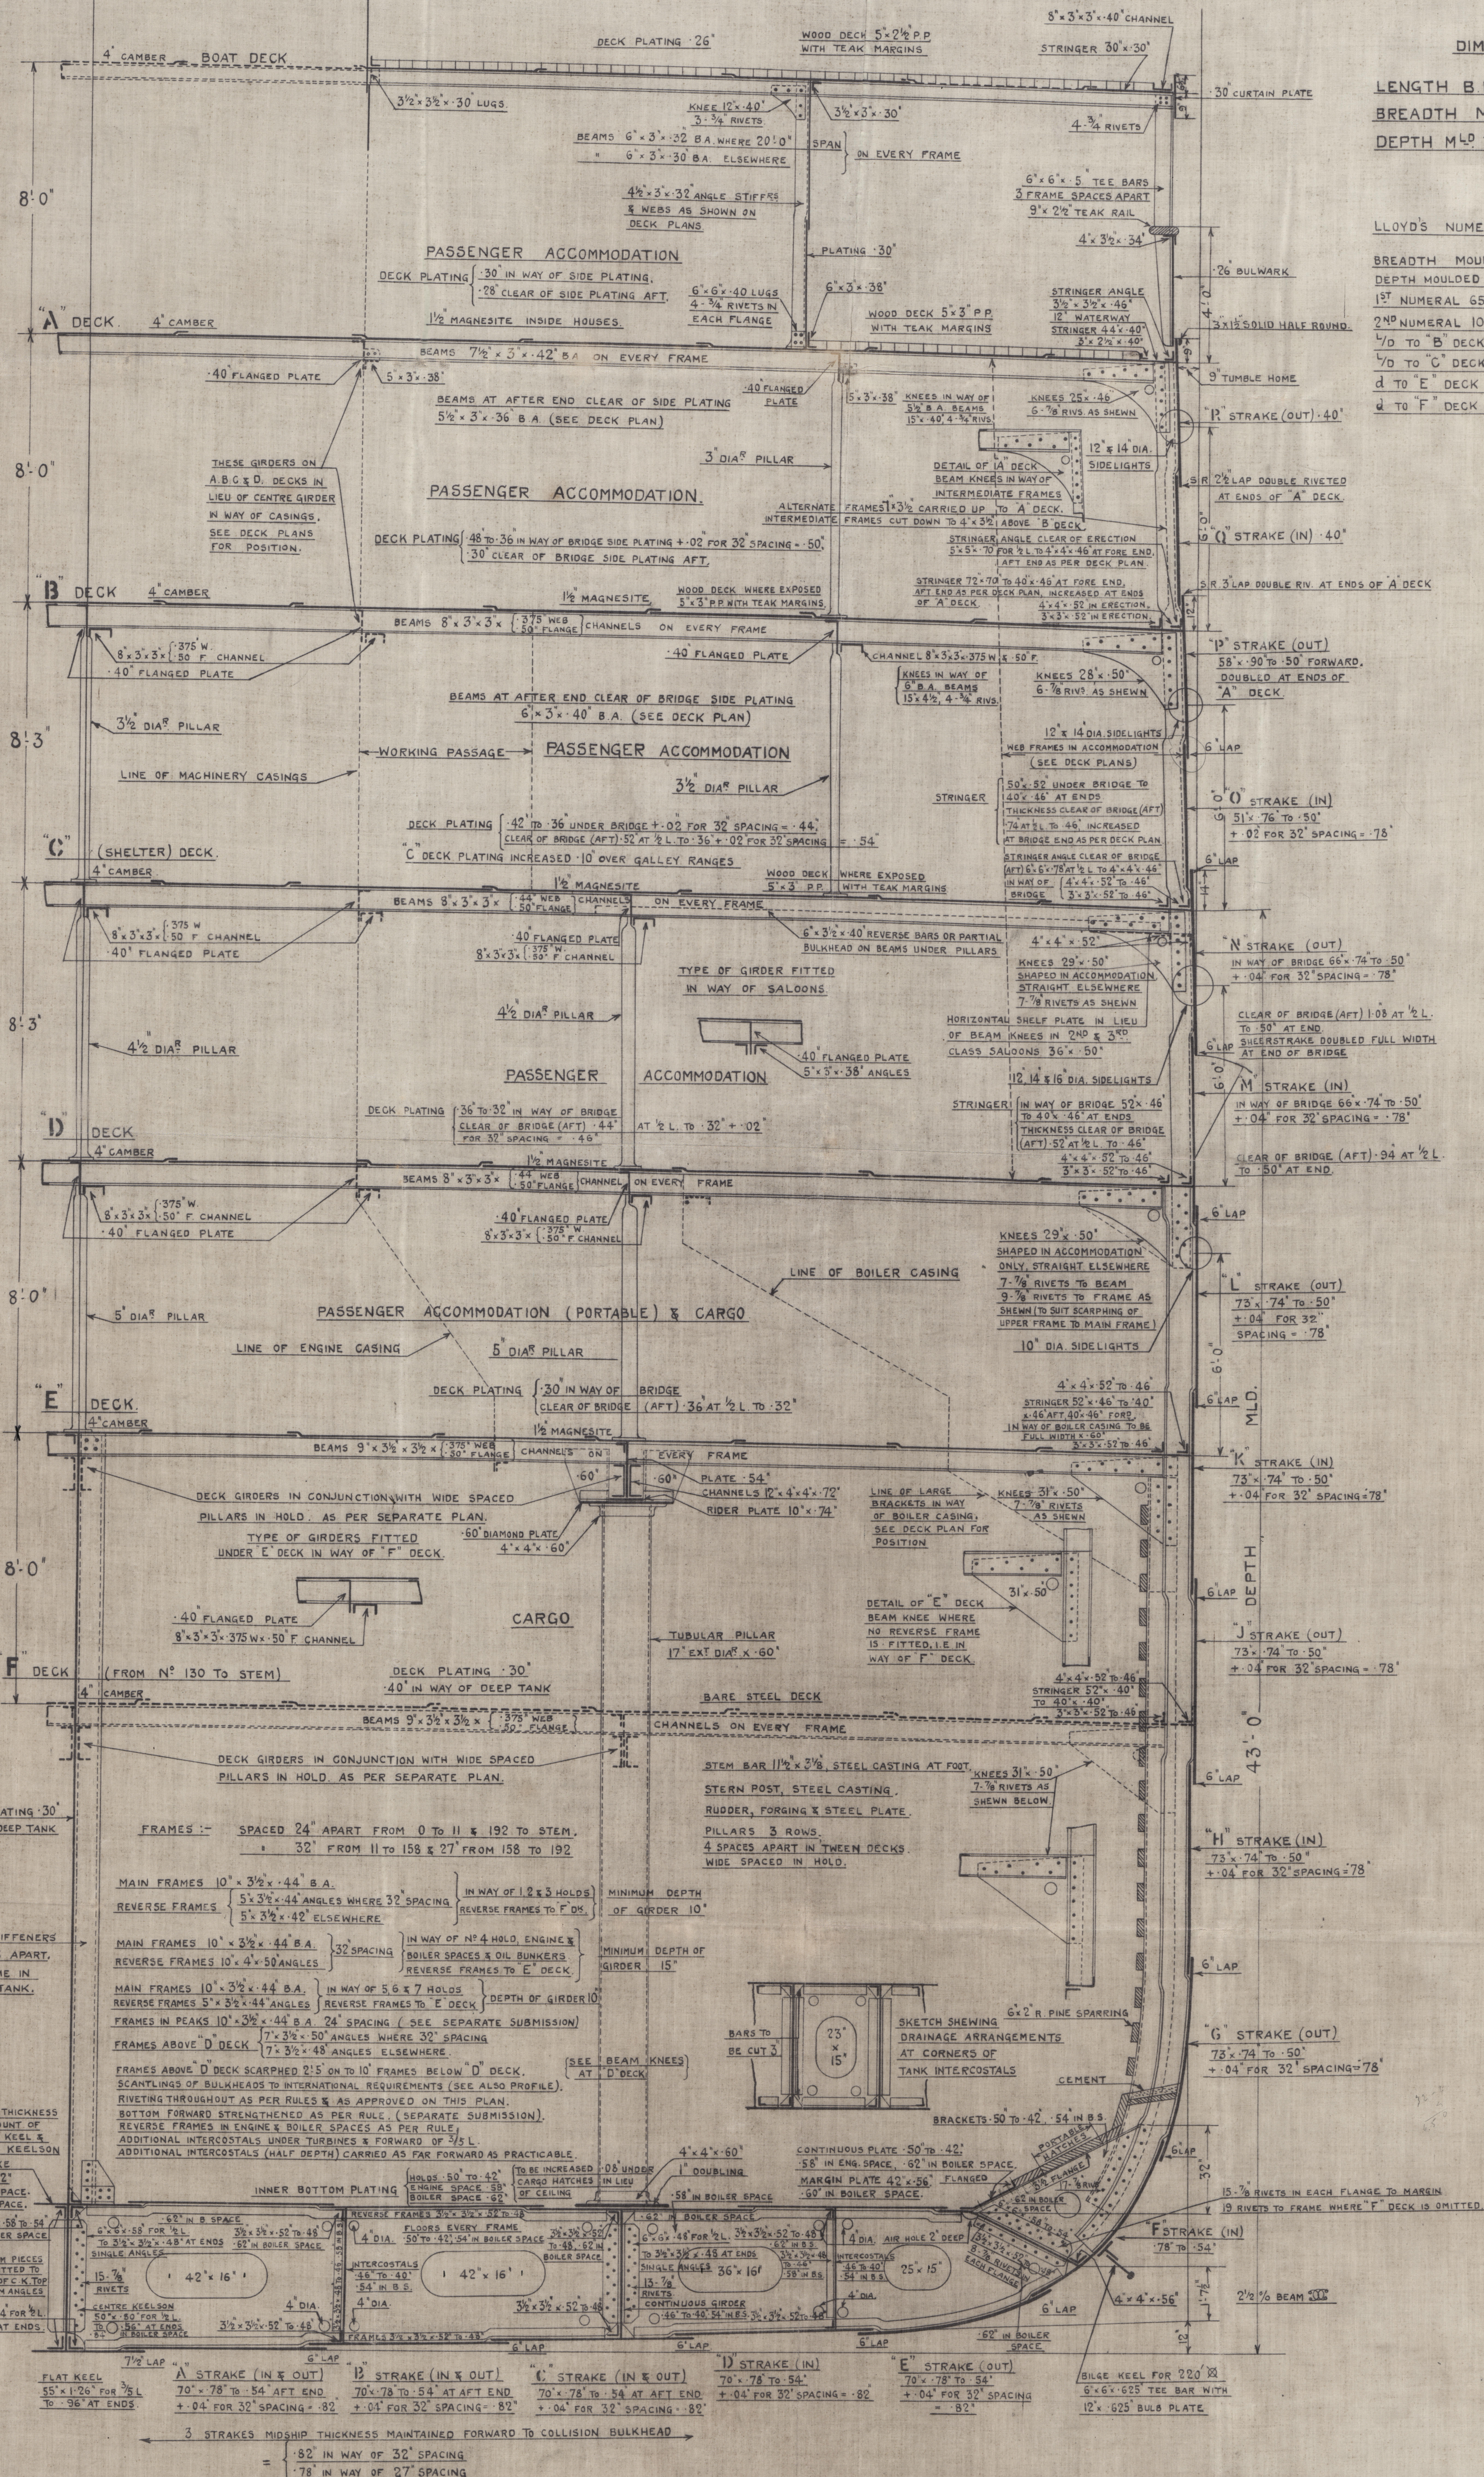



- T.S. S. ALAUNIA -

MISSISSIPPI SECTION  
- AS BUILT -

No 495

Jorge Brown & Co

GLASGOW REPORT No 44840



© 2021

Lloyd's Register  
Foundation

W293-0038