


FREEBOARD PARTICULARS	
LENGTH B.P. TO TIP OF STEM	225.0
LENGTH ON L.W.L.	224.7
BREADTH EXT.	26.0
BREADTH MOULDED	25.75
DEPTH MOULDED	17.25
DEPTH OF HOLD	15.30
UNDER DECK TONNAGE*	968.36
DISPLACEMENT COEF.	.784
RAISED QUARTER DECK TYPE	
NO CEILING ON TANK TOP	
DEEP BULB ANGLE FRAMES	
NO CARGO BATTENS FITTED	
* CORRECTED FOR ENGINE & BOILER SPACE, ABOVE LINE OF UPPER DECK	

# Nº 309 Profile & Decks

Class 100 A1 Special Survey

Scale  $\frac{1}{8}$  = One Foot.

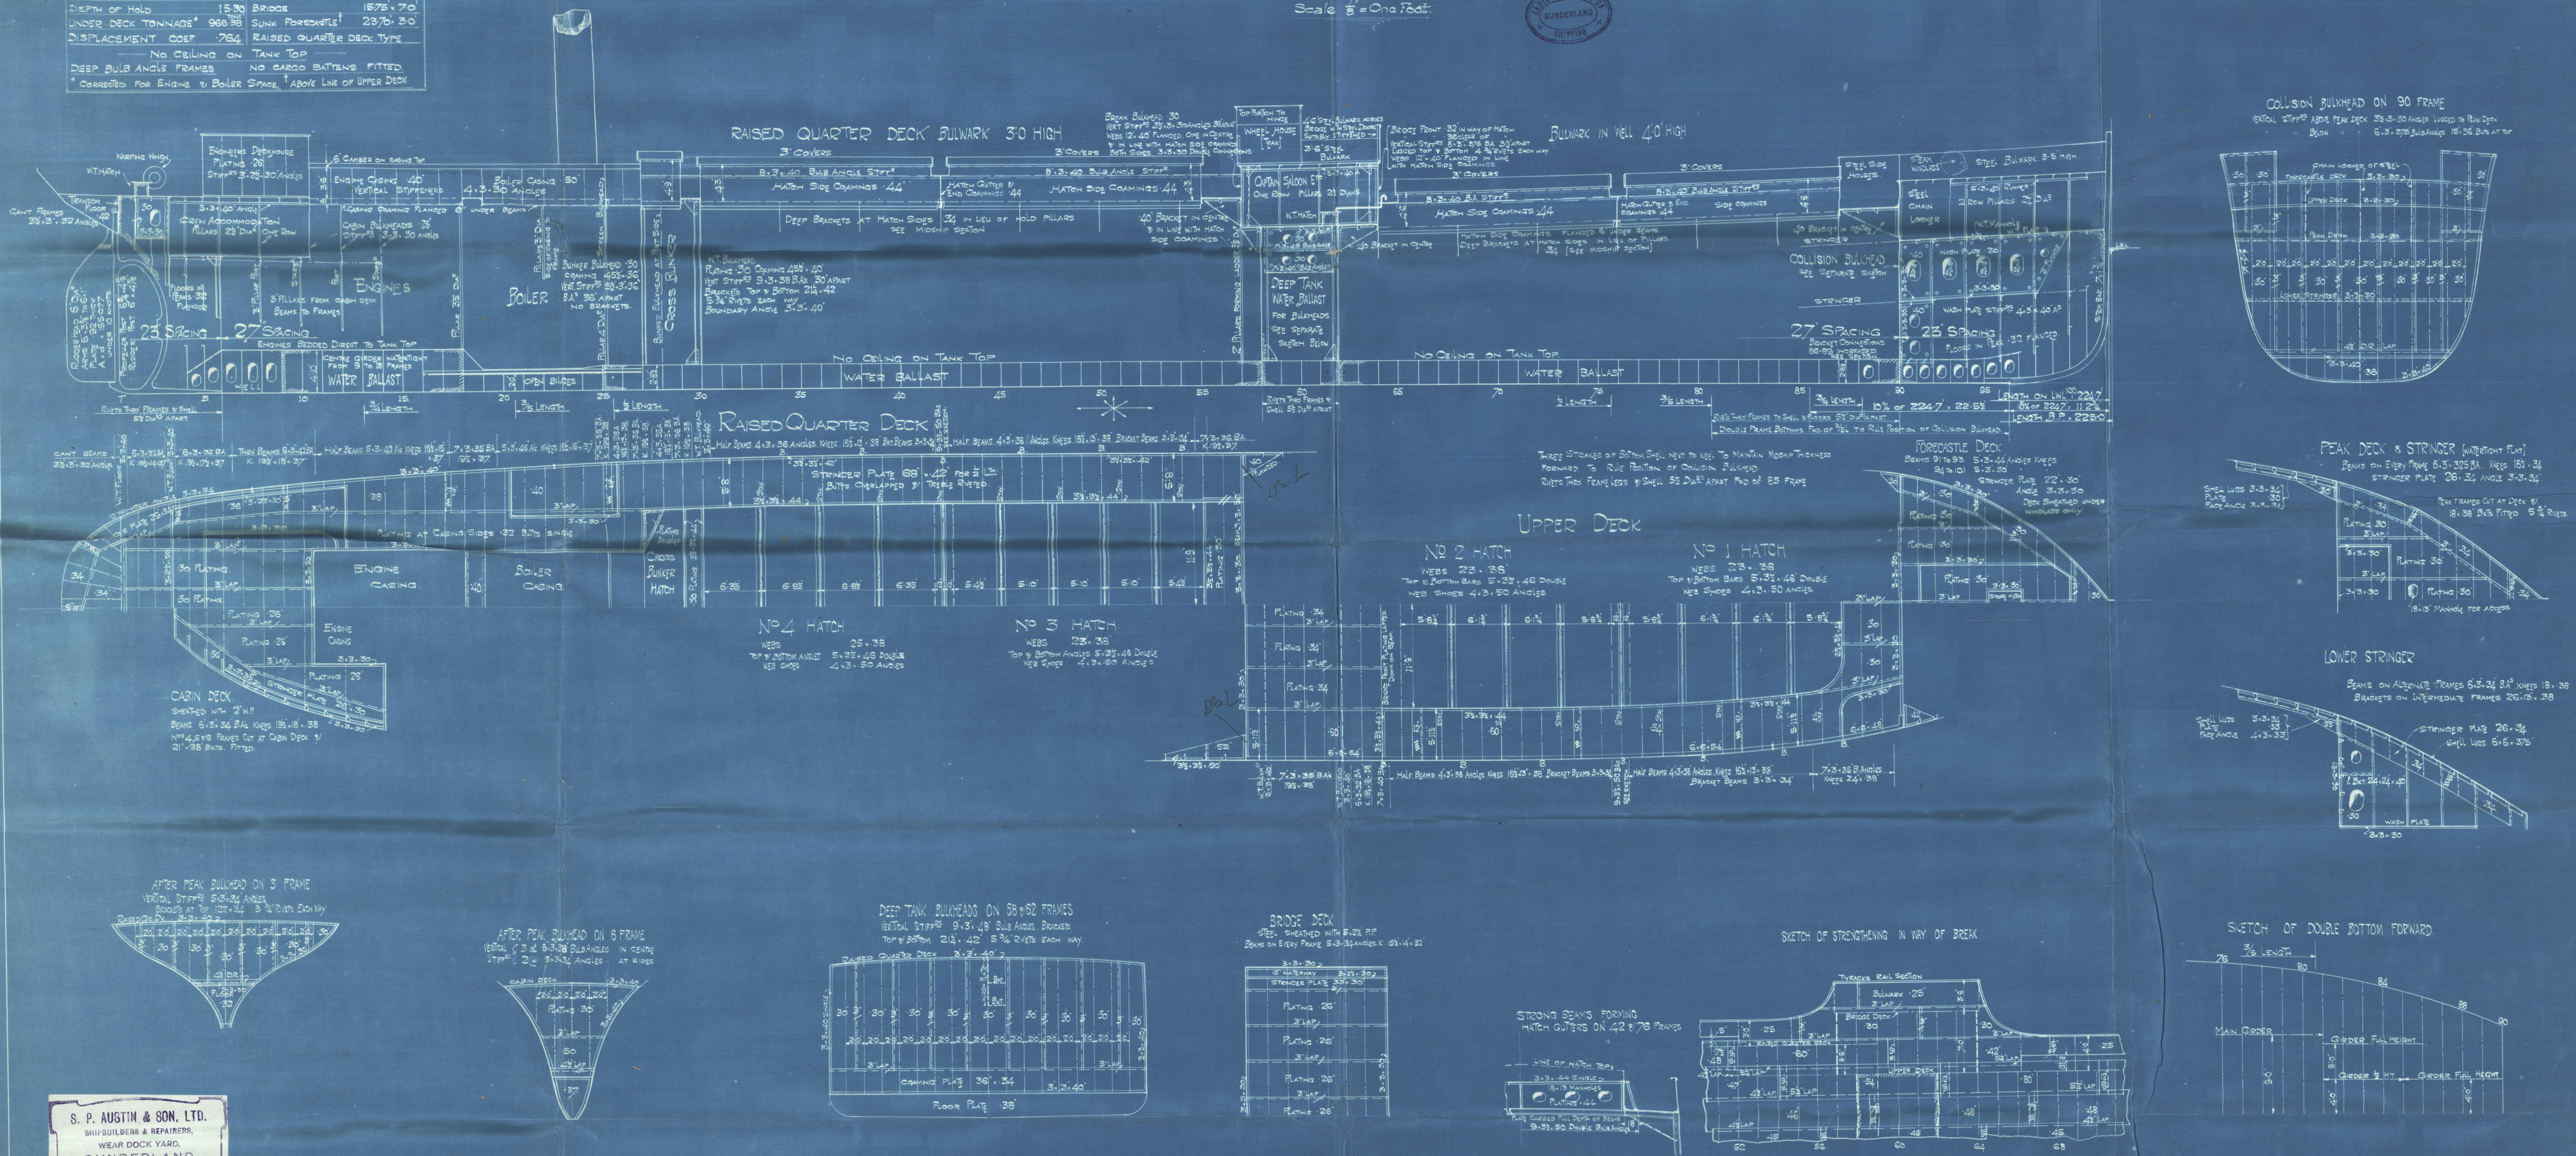

S. P. AUSTIN & SON, LTD.  
SHIPBUILDERS & REPAIRERS,  
WEAR DOCK YARD,  
SUNDERLAND.  
Date 27/7/25  
Reference No. 272/307



Sunderland.

S. P. Austin & Son.

Profile & Decks.

(-as built).

-N<sup>o</sup> 309-

S.S. "FIREGLOW."

Std Rpt No. 29114.



© 2021

Lloyd's Register  
Foundation

W37-0113