


**S.S. N° 258. "HORNCHURCH"**  
 MIDSHIP SECTION  
 Length B.P. = 280'0". Breadth Mid 40'3" Depth Mid 20'9"  
 Scale 1" = 1 Foot  
 Class 100. A.I. LLOYDS.



Dimensions		Equipment	
B = 40.25	Equipment 170	40.25 + 20.75 = 61.00	280
D = 20.75	3 Stockless Bowler Anchors	R.O.D. = 94.0 + 4.0	376
Trans. 170 = 61.00	1. Ordinary Stream	Roof = 22.6 + 7.0 + 7.5	119
Length 280	210 Fairleads	Bridge = 52.0 + 7.0 + 7.5	273
Long 170 = 170.80	75 Stream Chain	Fale = 27.0 + 7.0 + 7.5	142
Decks to Length = 15.49	90 Towline	Ceiling = 20.0 + 7.25 + 5.0	72
11.51 R.O.D.	2 at 90	Equipment 170	18062
	2 at 90		
	3 at 90		


22.7.19  
 339  
 15-7-19.

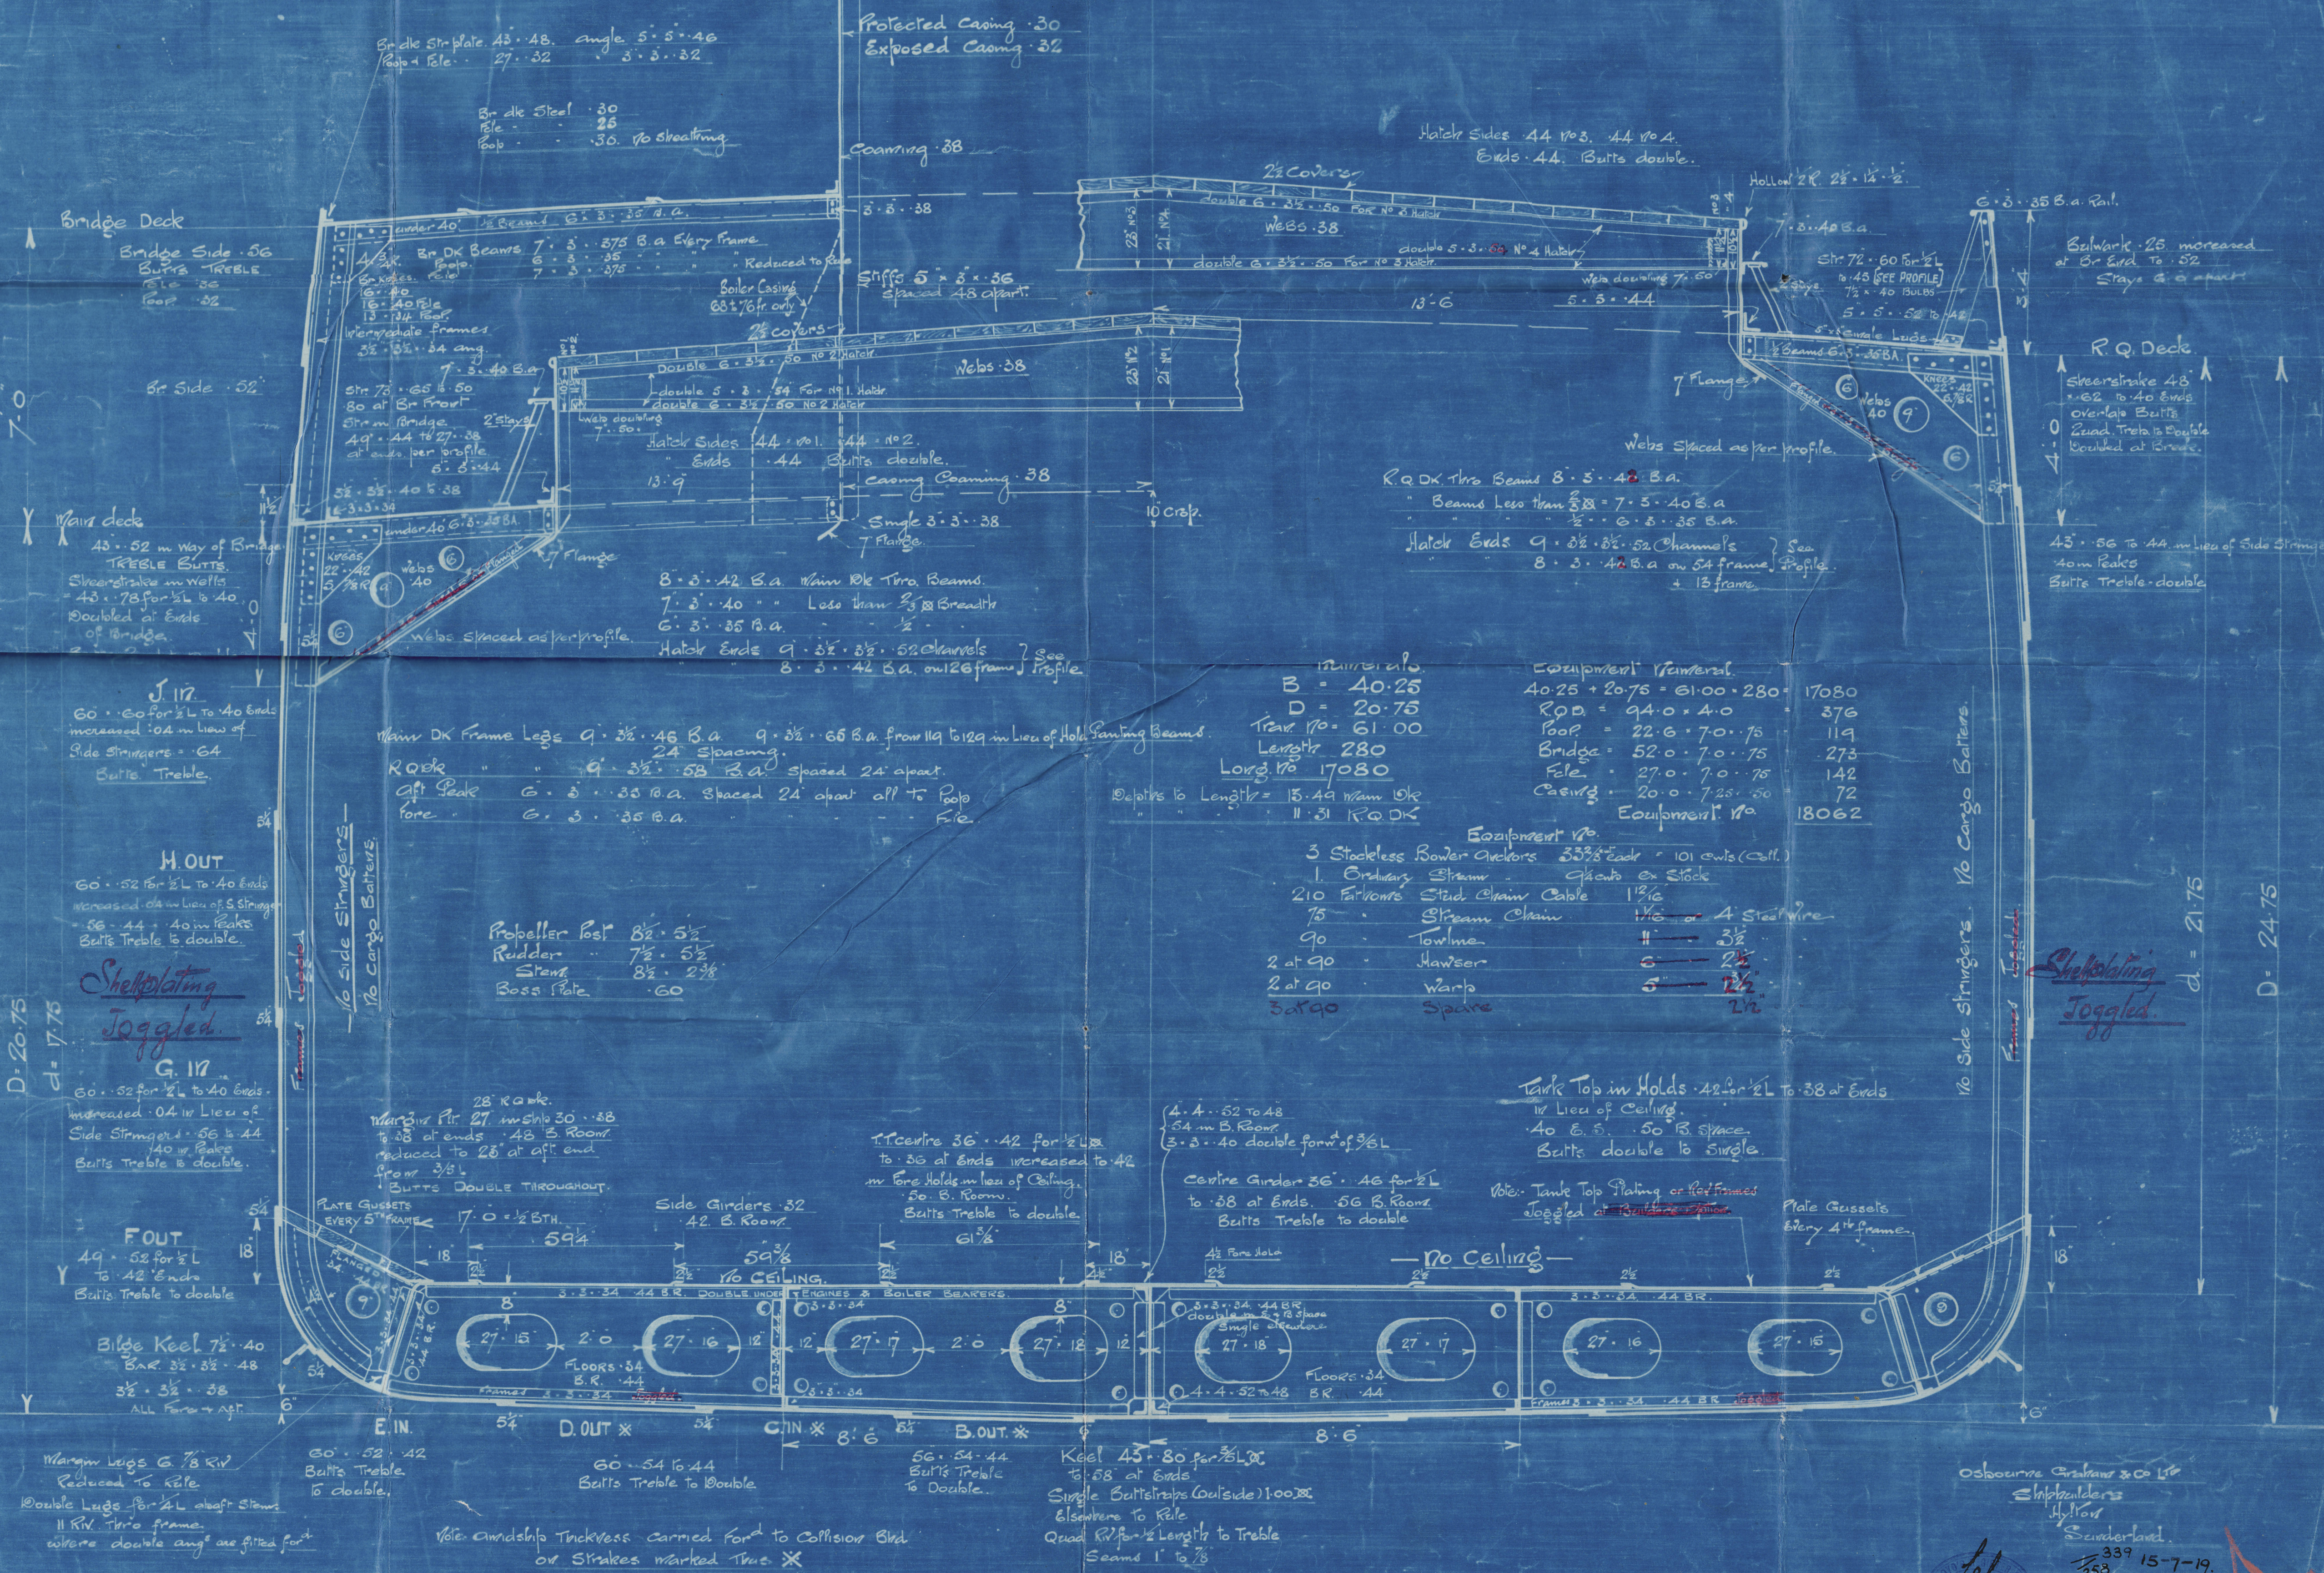

"Hutchinson" 258.

(as built.)

Midship Section.

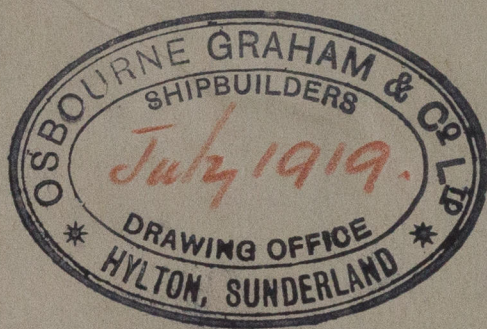

SUNDERLAND RPT. NO. 27567<sup>11</sup>

RETAIN

W403-0137

Lloyd's Register  
Foundation