

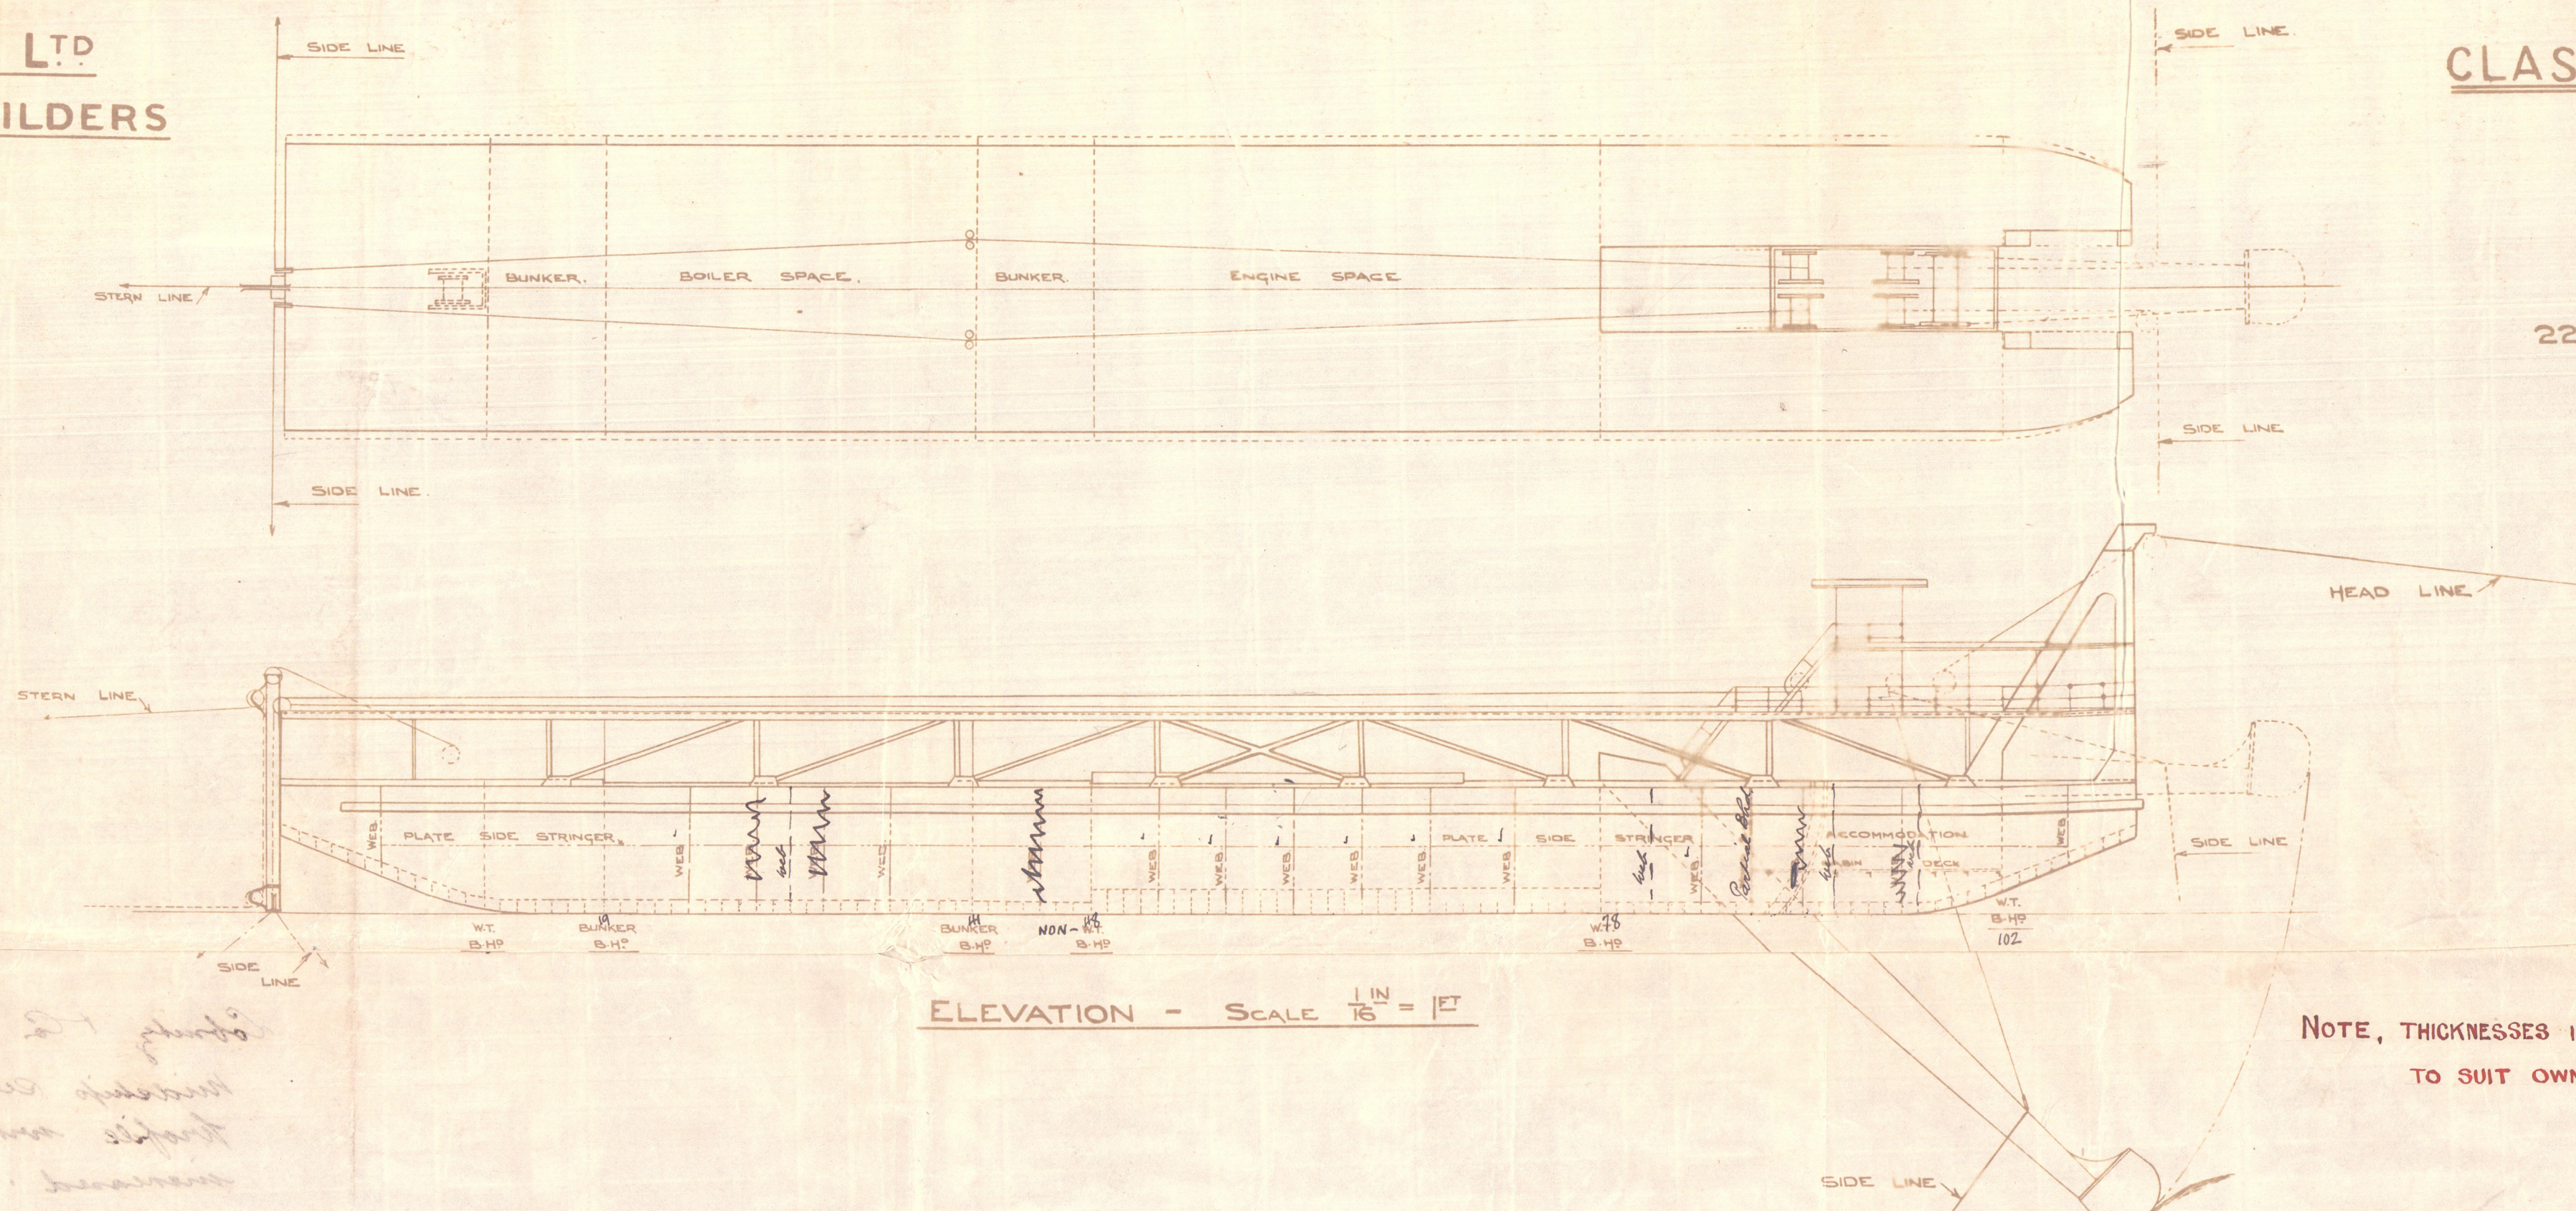


TO BE SHIPPED IN PLATES AND ANGLES.
LLOYDS NUMERALS.
36-15 = 51 TRANSVERSE N°
220 (36-15) = 11,220 LONGITUDINAL N°

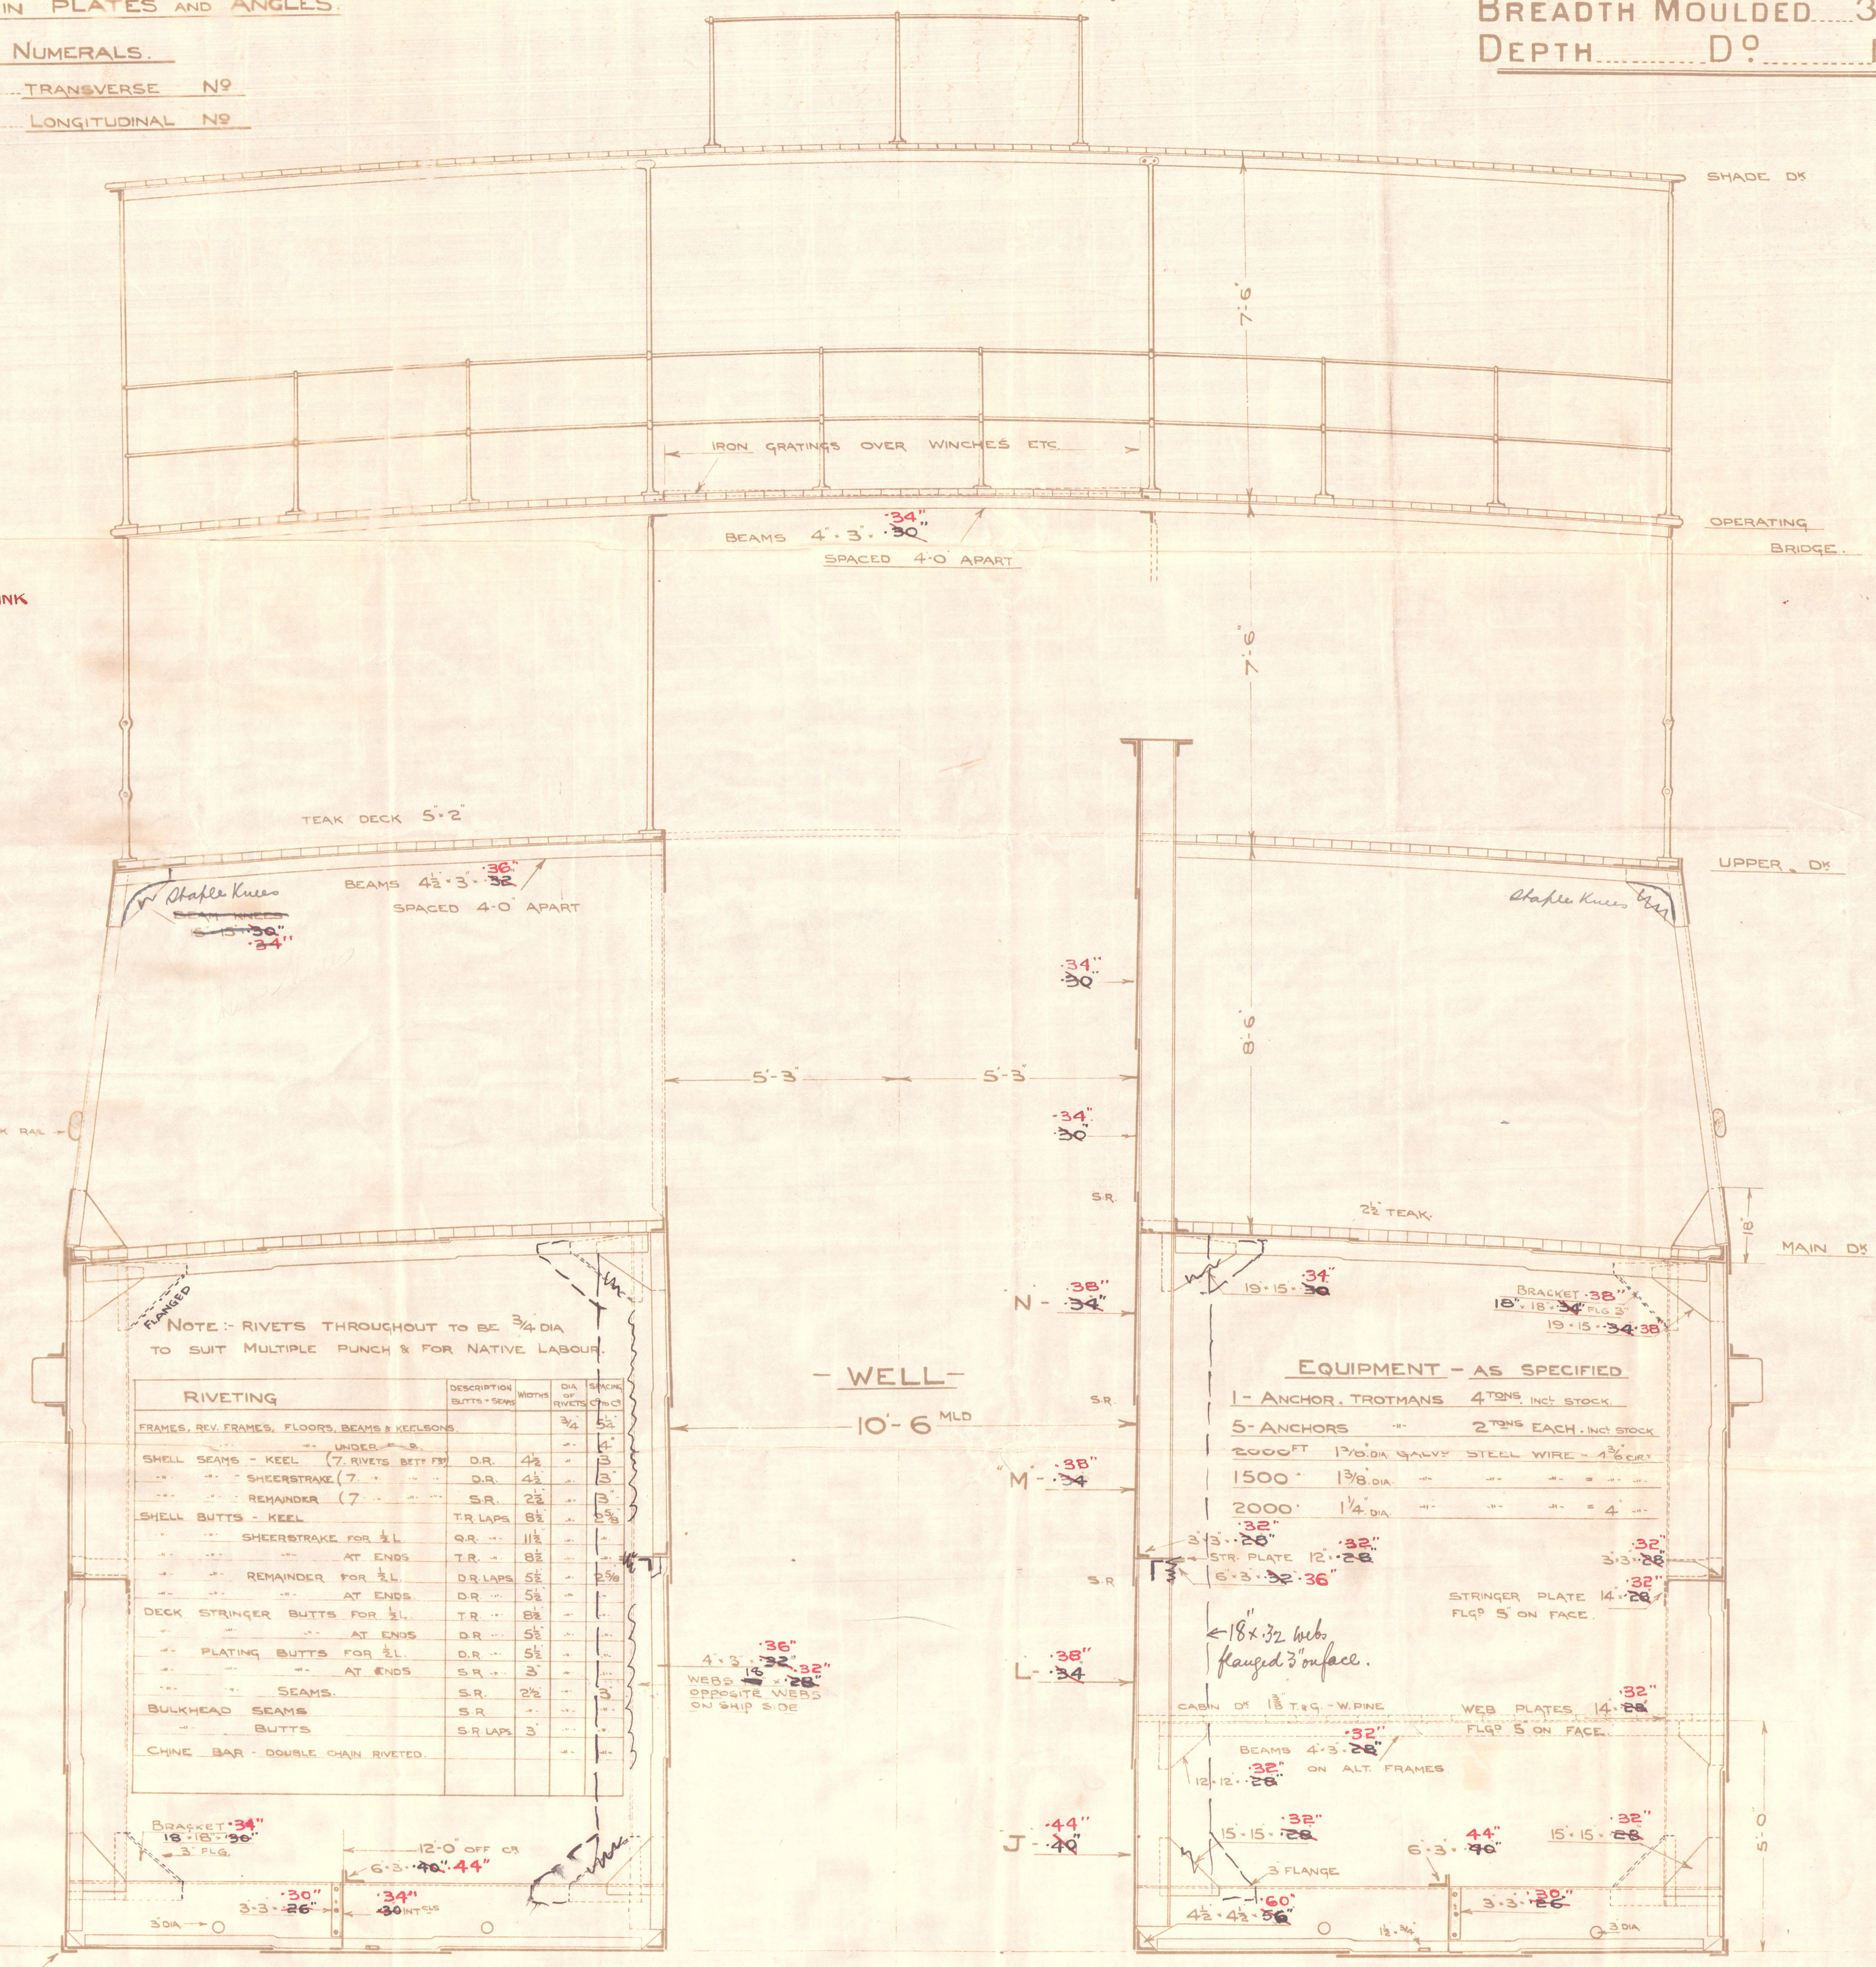

NOTE, THICKNESSES INCREASED AS SHOWN IN RED INK
TO SUIT OWNERS' REQUIREMENTS.

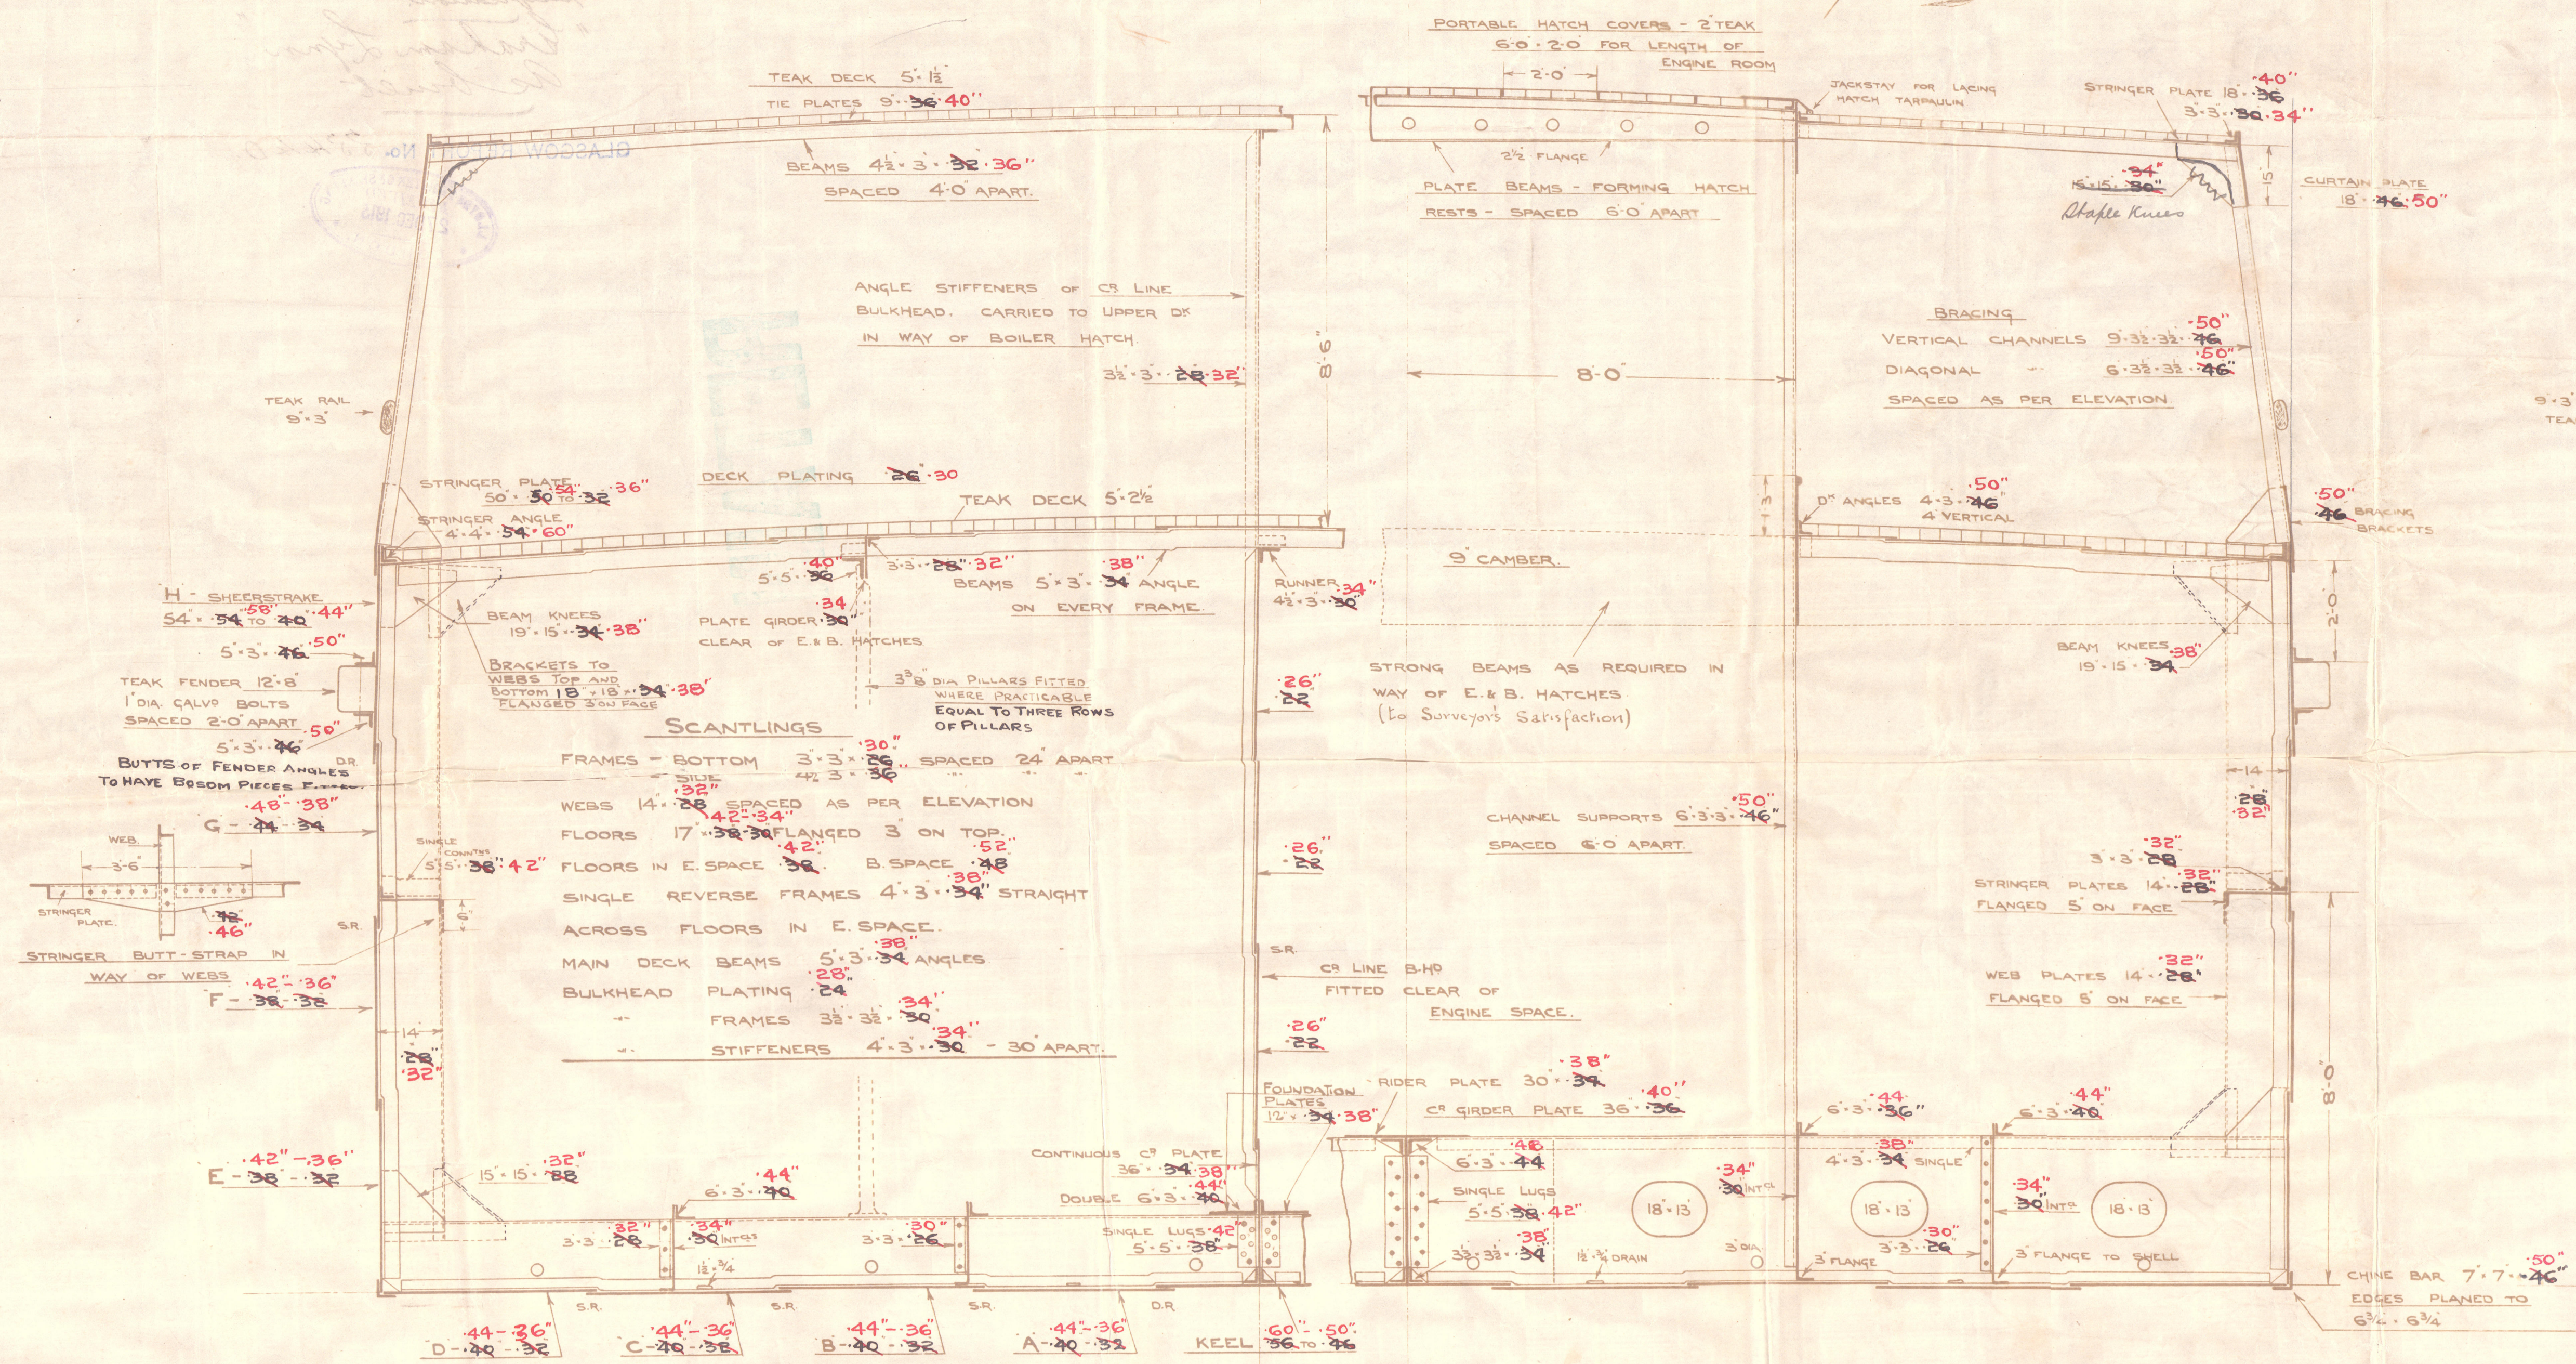

MIDSHIP SECTION N° 773. SCALE 1/2\"/>


LOBNITZ & CO LTD RENFREW.
No. 773.
Drawn by...
Checked by...
DATE 27th Jan. 1913.

Lobnitz & Co. 42773


Midship Section &
Profile with scantlings
increased .04 as per
Specification.

"Graham Lynn"
As built

GLASGOW REPORT No. 55440.

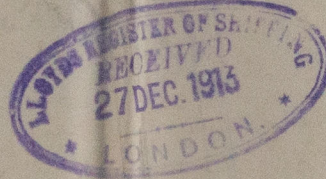

RETAIN

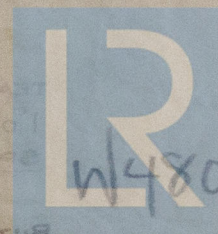

© 2020

Lloyd's Register
Foundation

W480-0038