



— No 255. —
PROFILE & DECK PLANS.

Scale $\frac{1}{8}" = 1 \text{ Foot.}$

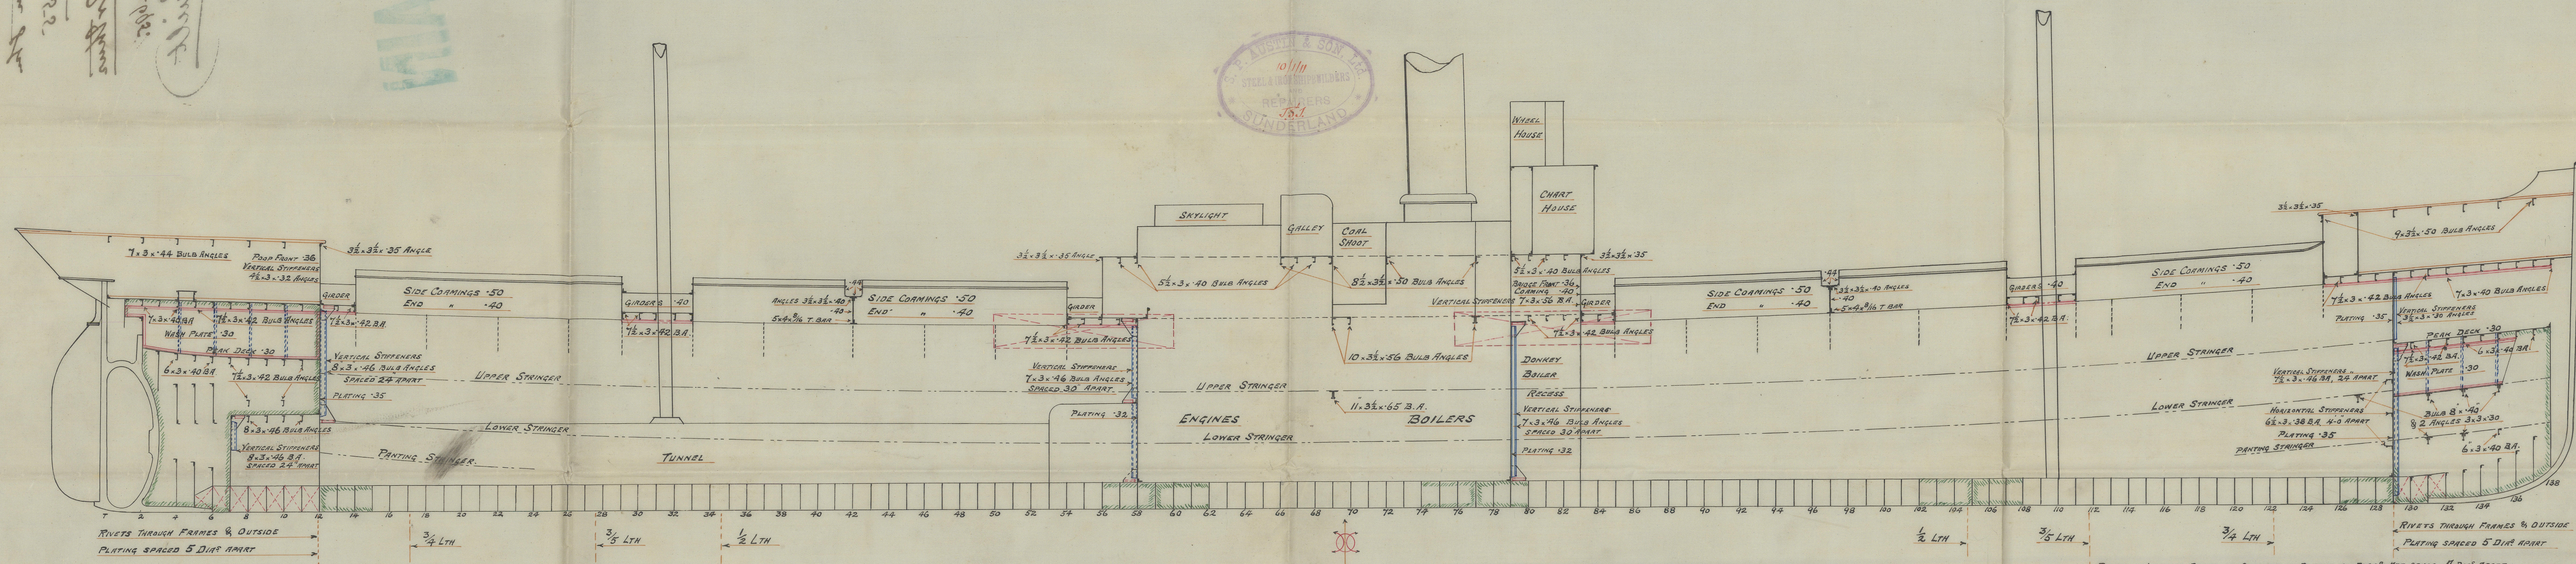


- ✓ RIVETS IN LANDING EDGES OF STRAKES OF PLATING ALL FWD & AFT SPACED 4 DIA^S APART.
- ✓ RIVETS IN PLATING & FRAMES FORWARD OF $\frac{3}{5}$ LTH SPACED $5\frac{1}{2}$ DIA^S APART.
- ✓ DOUBLE FRAMES FROM $\frac{3}{5}$ LTH TO COLLISION BULKHEAD
- ✓ ADDITIONAL INTERCOSTAL GIRDERS FITTED.

BRIDGE DECK.

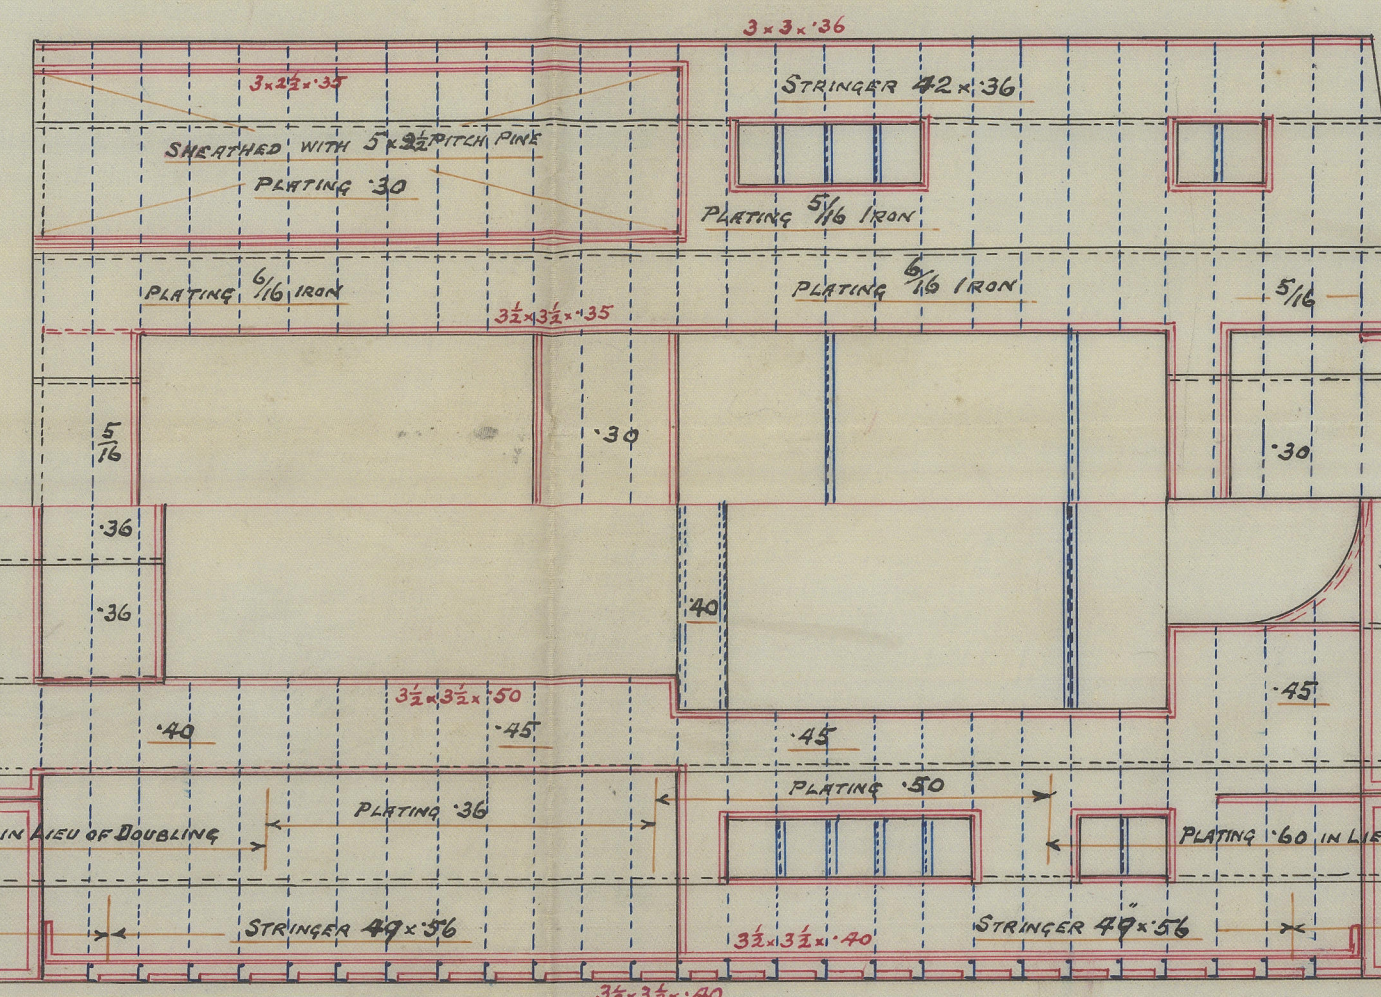

FORECASTLE DECK.

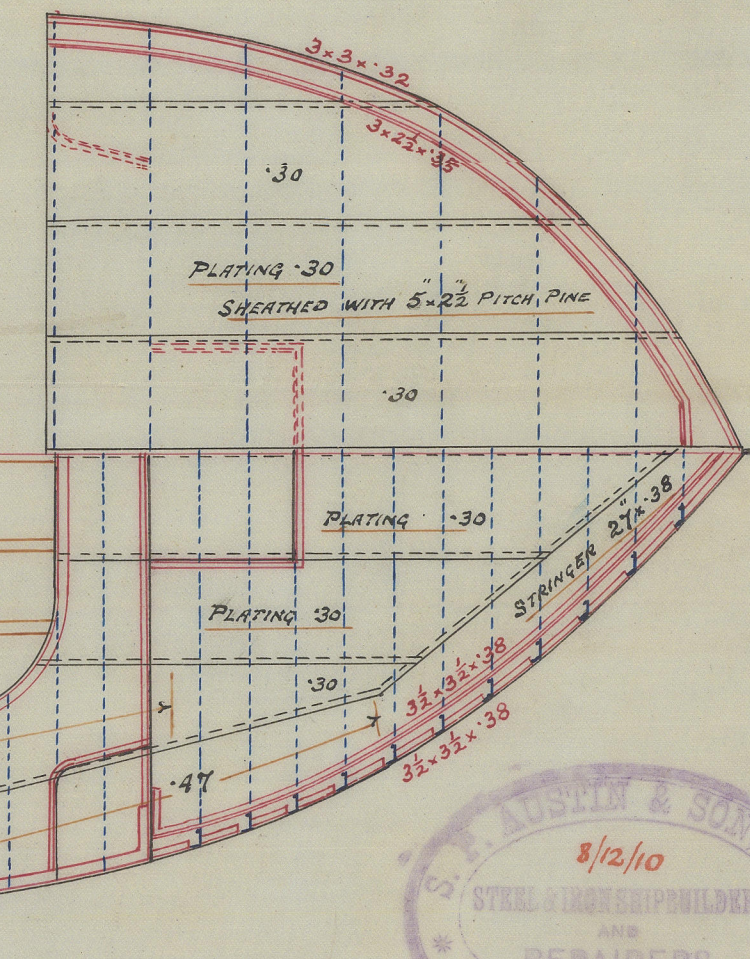

Profile & Deck plan

S.P. Austen & Son

No 255

S.P. Sir Arthur

Std. Rpt no 24695.

(as built)

RETAIN



© 2020

Lloyd's Register
Foundation

W542-0265