

MIDSHIP SECTION N° 256.


CLASS 100 A.I. LLOYDS.

SINGLE DECK TYPE

	POOP	FILE
SIDE PLATING	36"	38"
STRINGER PLATE	32" x 32"	32" x 32"
" ANGLE	3 1/2" x 3 1/2" x 32"	3 1/2" x 3 1/2" x 32"
DECK	TIE PLATES 9" x 32" WOOD. D.K. 5" x 3 R.P.	30"
BEAMS	7 1/2" x 3" x 50 B.A. ALTERNATE P.R.S.	7 1/2" x 3" x 42 TO 40 B.A. EVERY FRAME
BEAM KNEES	20" x 40"	18" x 40"
PILLARS	2 ROWS 2 3/8 DIA	ONE ROW 2 3/8 DIA

LENGTH B.P. 331'-0"
BREADTH EXT. 47'-9"
DEPTH MLD. 24'-3 1/2"

SCALE 1/2" = ONE FOOT

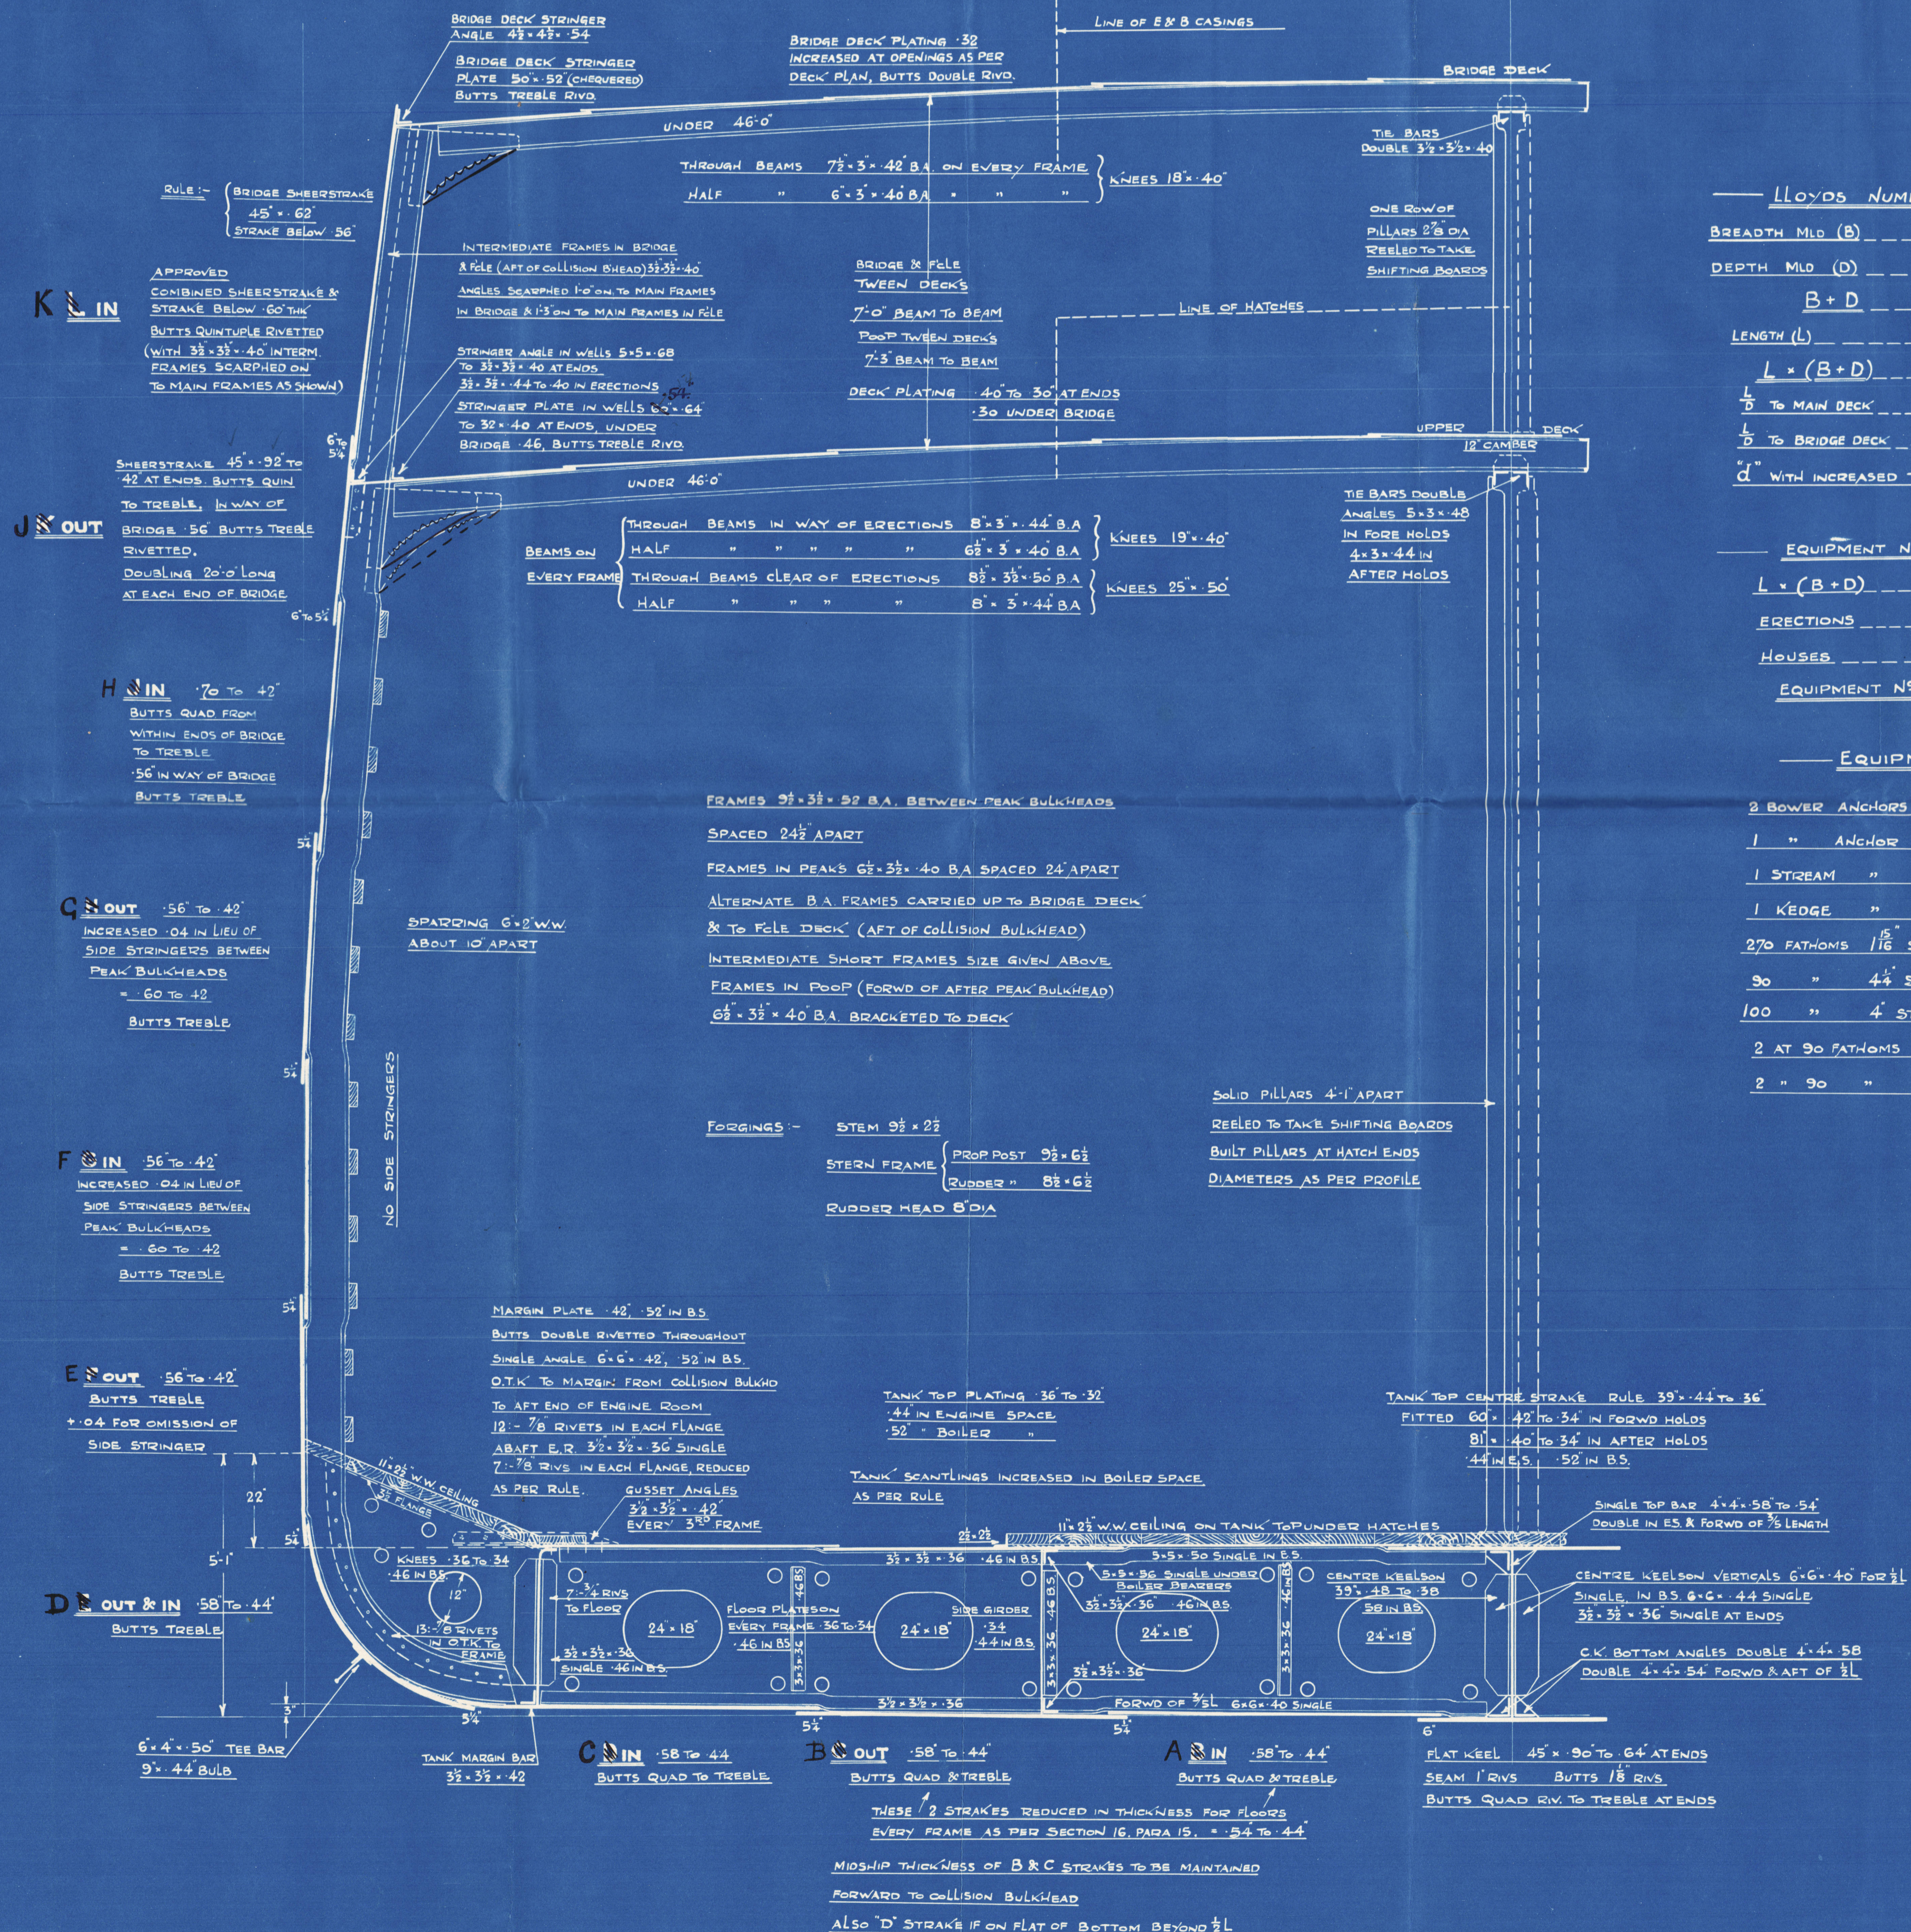

LLOYDS NUMERALS

BREADTH MLD (B)	47.41
DEPTH MLD (D)	24.29
B + D	71.70 = 1 ST N°
LENGTH (L)	330.66
L x (B + D)	23708 = 2 ND N°
L/D TO MAIN DECK	13.61
L/D TO BRIDGE DECK	10.57
" WITH INCREASED TANK BRACKETS	21'-0"

EQUIPMENT NUMERAL

L x (B + D)	23708
ERECTIONS	798
HOUSES	256
EQUIPMENT N°	24762

EQUIPMENT

2 BOWER ANCHORS STOCKLESS	45 cwt
1 " ANCHOR	38 "
1 STREAM "	12 " Ex. Stock
1 KEDGE "	5 1/2 " Ex. Stock
270 FATHOMS 1 1/2" STUD-CHAIN CABLE	
90 " 4 1/4" STEEL WIRE	
100 " 4" STEEL WIRE TOWLINE	
2 AT 90 FATHOMS 7" HAWSERS	
2 " 90 " 6" WARPS	

1667
256
20/7/1922

RETAIN

SUNDERLAND

J. BLUMER & CO LTD

Nº-256

MIDSHIP SECTION

(AS BUILT)

S.S. 'IXIA'

SUNDERLAND. Nº 28385.

RETAIN



© 2021

Lloyd's Register
Foundation

WS 83-0088