


## A circular purple ink stamp. The outer ring contains the text "THE ARDROSSAN DRY DOCK &amp; SHIPBUILDING CO. LTD." at the top and "ARDROSSAN" at the bottom, separated by two small stars. In the center, the number "2203" is handwritten in dark ink. Below the number, the date "21 JUN 1922" is stamped in purple ink. There is also some faint, illegible handwritten text in purple ink below the date.



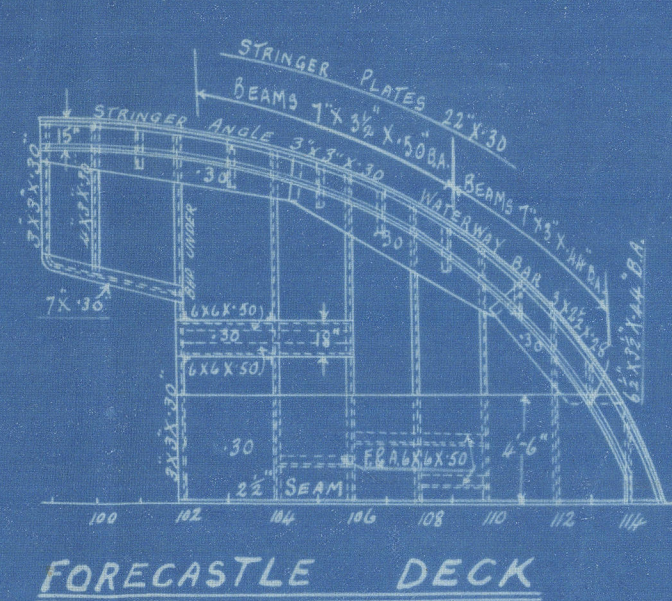

Androssan

W-318

Profile & deck

As Built  
RETAIN

S.S. "Bayeskimo"

GLASGOW REPORT No. 42031



© 2020

Lloyd's Register  
Foundation

W624 - 0073