


PROFILE & DECK PLANS NOS. 228.

SCALE 1/8" = 1 FOOT


LENGTH B.P. 340'-0" BREADTH EXT 47'-9" DEPTH MLD TO MAIN D. 23'-15"

EXTRA PILLARS UNDER MASTS WINCHES & WINDLASS.
PILLARING THROUGHOUT TO SURVEYORS SATISFACTION.


SHUTTER M. BEAMS AT ENDS.
WHERE UNDER 2 1/2 L. 6-3-40 B.A.
2 L. 5 1/2-3-40 ANGLE OR 5 1/2-3-40 B.A.

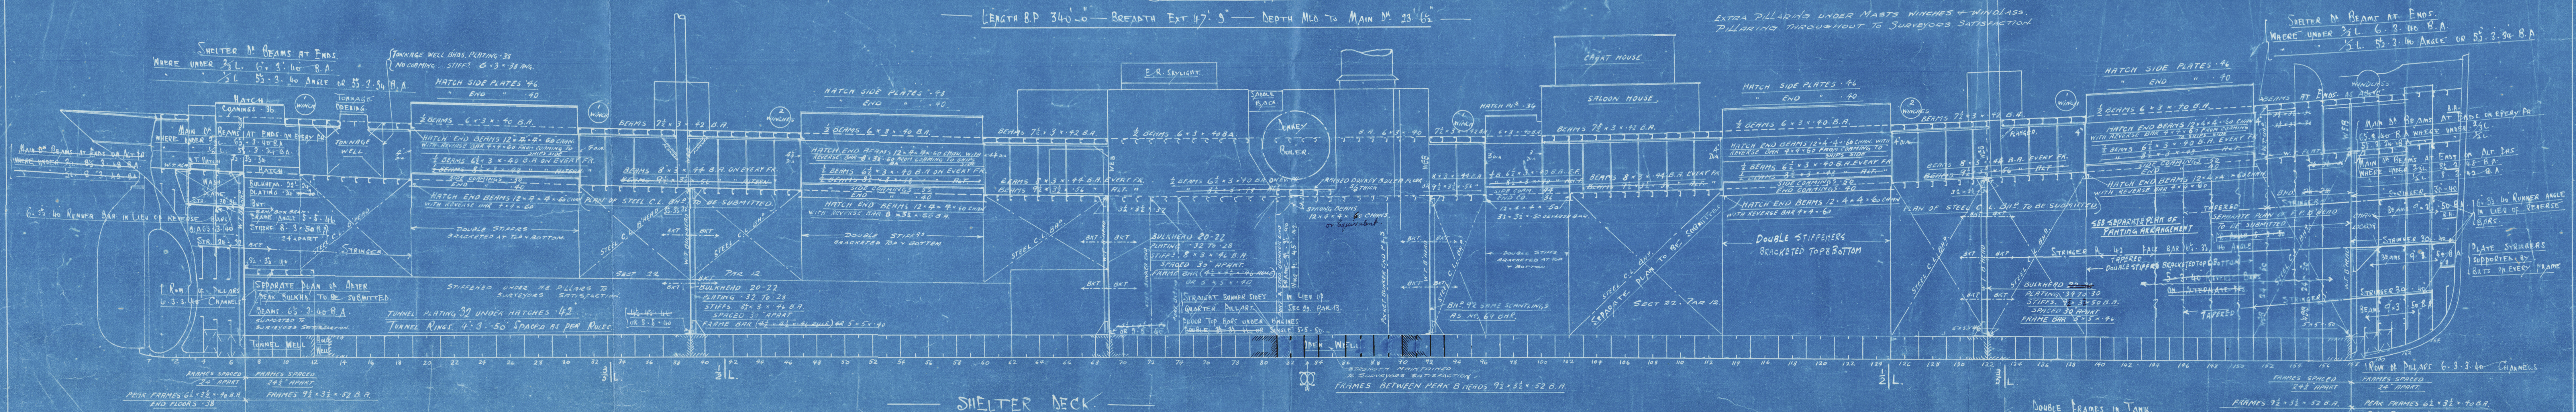

SHELTER DECK

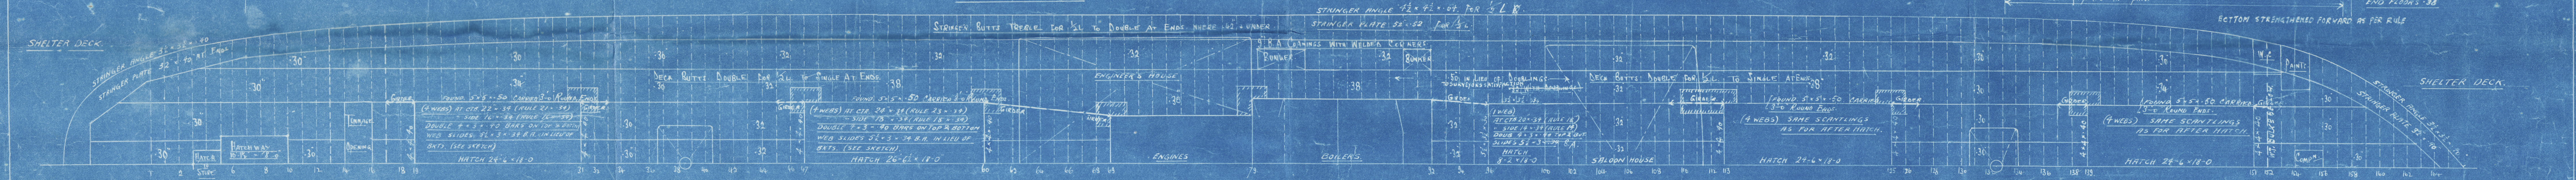


MAIN DECK

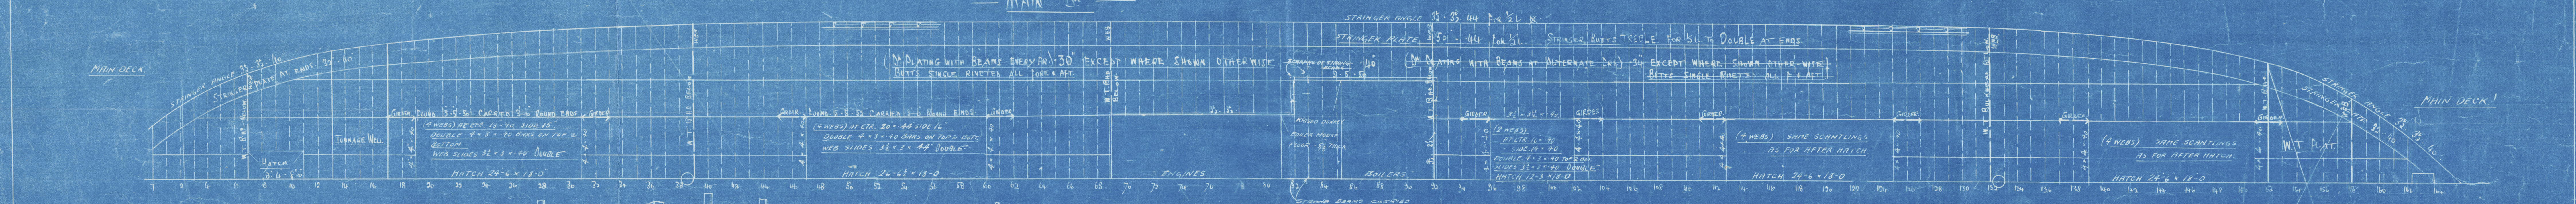

DIAMOND PLATES AT HATCH

CORNERS UNDER BEAMS

(BOTH DECKS)

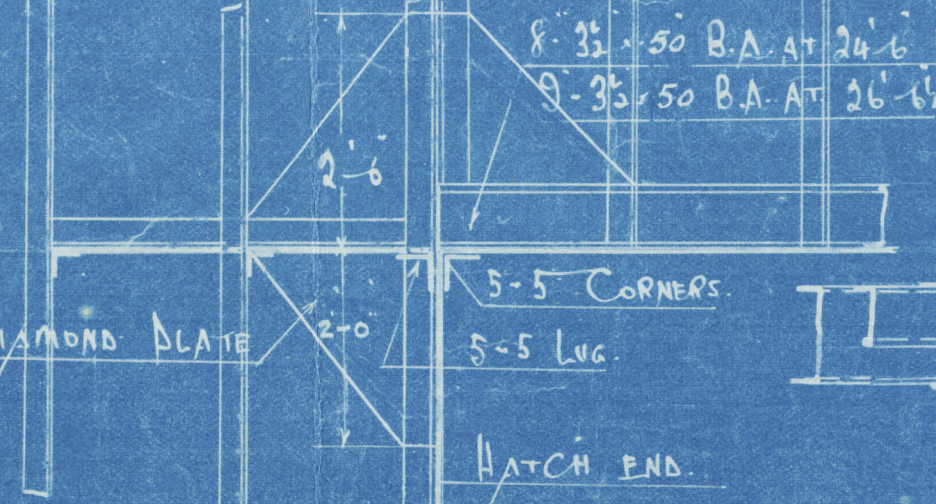

SECTION THRO' HATCH SIDE

(BOTH DECKS)

(BOTH DECKS)

JOHN BLUMER & CO.
SHIPBUILDERS & CO.
No. 2127.
May 28, 1915.
NORTH DOCK
SUNDERLAND

Profile & Deck Plan
(as built)


C/S. Spennymoor

Nº 228

J. Blusner & Co

SUNDERLAND RPT. No. 26459

RETAIN

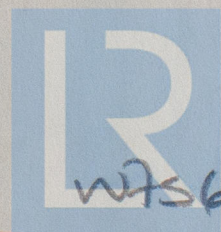

© 2021

Lloyd's Register
Foundation