

PARTICULARS FOR FREEBOARD.

REGISTERED LENGTH	DO	321.2
BREADTH	DO	43.25
DEPTH	DO	19.5
UNDER DECK TONNAGE	DO	2149.32 TONS
SHEER AT STERN	DO	30'
SHEER AT STEM	DO	8 1/4'
SHEER 1/8 FROM STERN	DO	16 1/4'
SHEER 1/8 FROM STEM	DO	46'
RAISED QUARTER DECK	DO	185' x 425' HIGH
BRIDGE ON RAISED QUARTER DECK	DO	63' 0" x 4' 0" ENCLOSED (6 1/2 TOTAL LENGTH ON DECK)
FORECASTLE	DO	32' 0" TOTAL LENGTH ON DECK 7' 0" HIGH

MIDSHIP SECTION

OF THE STEEL SCREW STEAMER.

"WALLSEND."

- CLASSED 100 A1 AT LLOYDS -

PRINCIPAL DIMENSIONS.


LENGTH B.P.	DO	321' 0"
BREADTH MLD	DO	43' 0"
DEPTH MLD	DO	21' 9"

SCALE 1/2" = 1 FOOT.

EQUIPMENT.

LONGITUDINAL NUMBER	DO	20Y84.45
RQDS (TO BRIDGE END)	DO	185' x 4' 25" Y89.22
BRIDGE	DO	63' x 4' 3/4" 330.45
FORECASTLE	DO	32' x 4' 3/4" 168.00
DECKHOUSE	DO	113' x 4' 1/2" 40.25
EQUIPMENT NO	DO	22112.84

2 BOWER ANCHORS	DO	STOCKLESS 42 CWT'S.
1 " "	DO	" " 35 1/2 " }
1 STREAM	DO	EX STOCK 11 " TOTAL 110 1/2 CWT'S.
1 KEDGE	DO	" " 5 1/4 " "
240 FATHOMS	DO	1 1/2" STEEL CHAIN CABLE
45 " "	DO	1 1/2" STREAM " "
100 " "	DO	4" STEEL WIRE HAWSER.
(2 OFF) 90 " "	DO	3 1/4" " " " "
(4 OFF) 90 " "	DO	2 1/2" " " " "
(2 OFF) 90 " "	DO	6" MANILLA HAWSER.

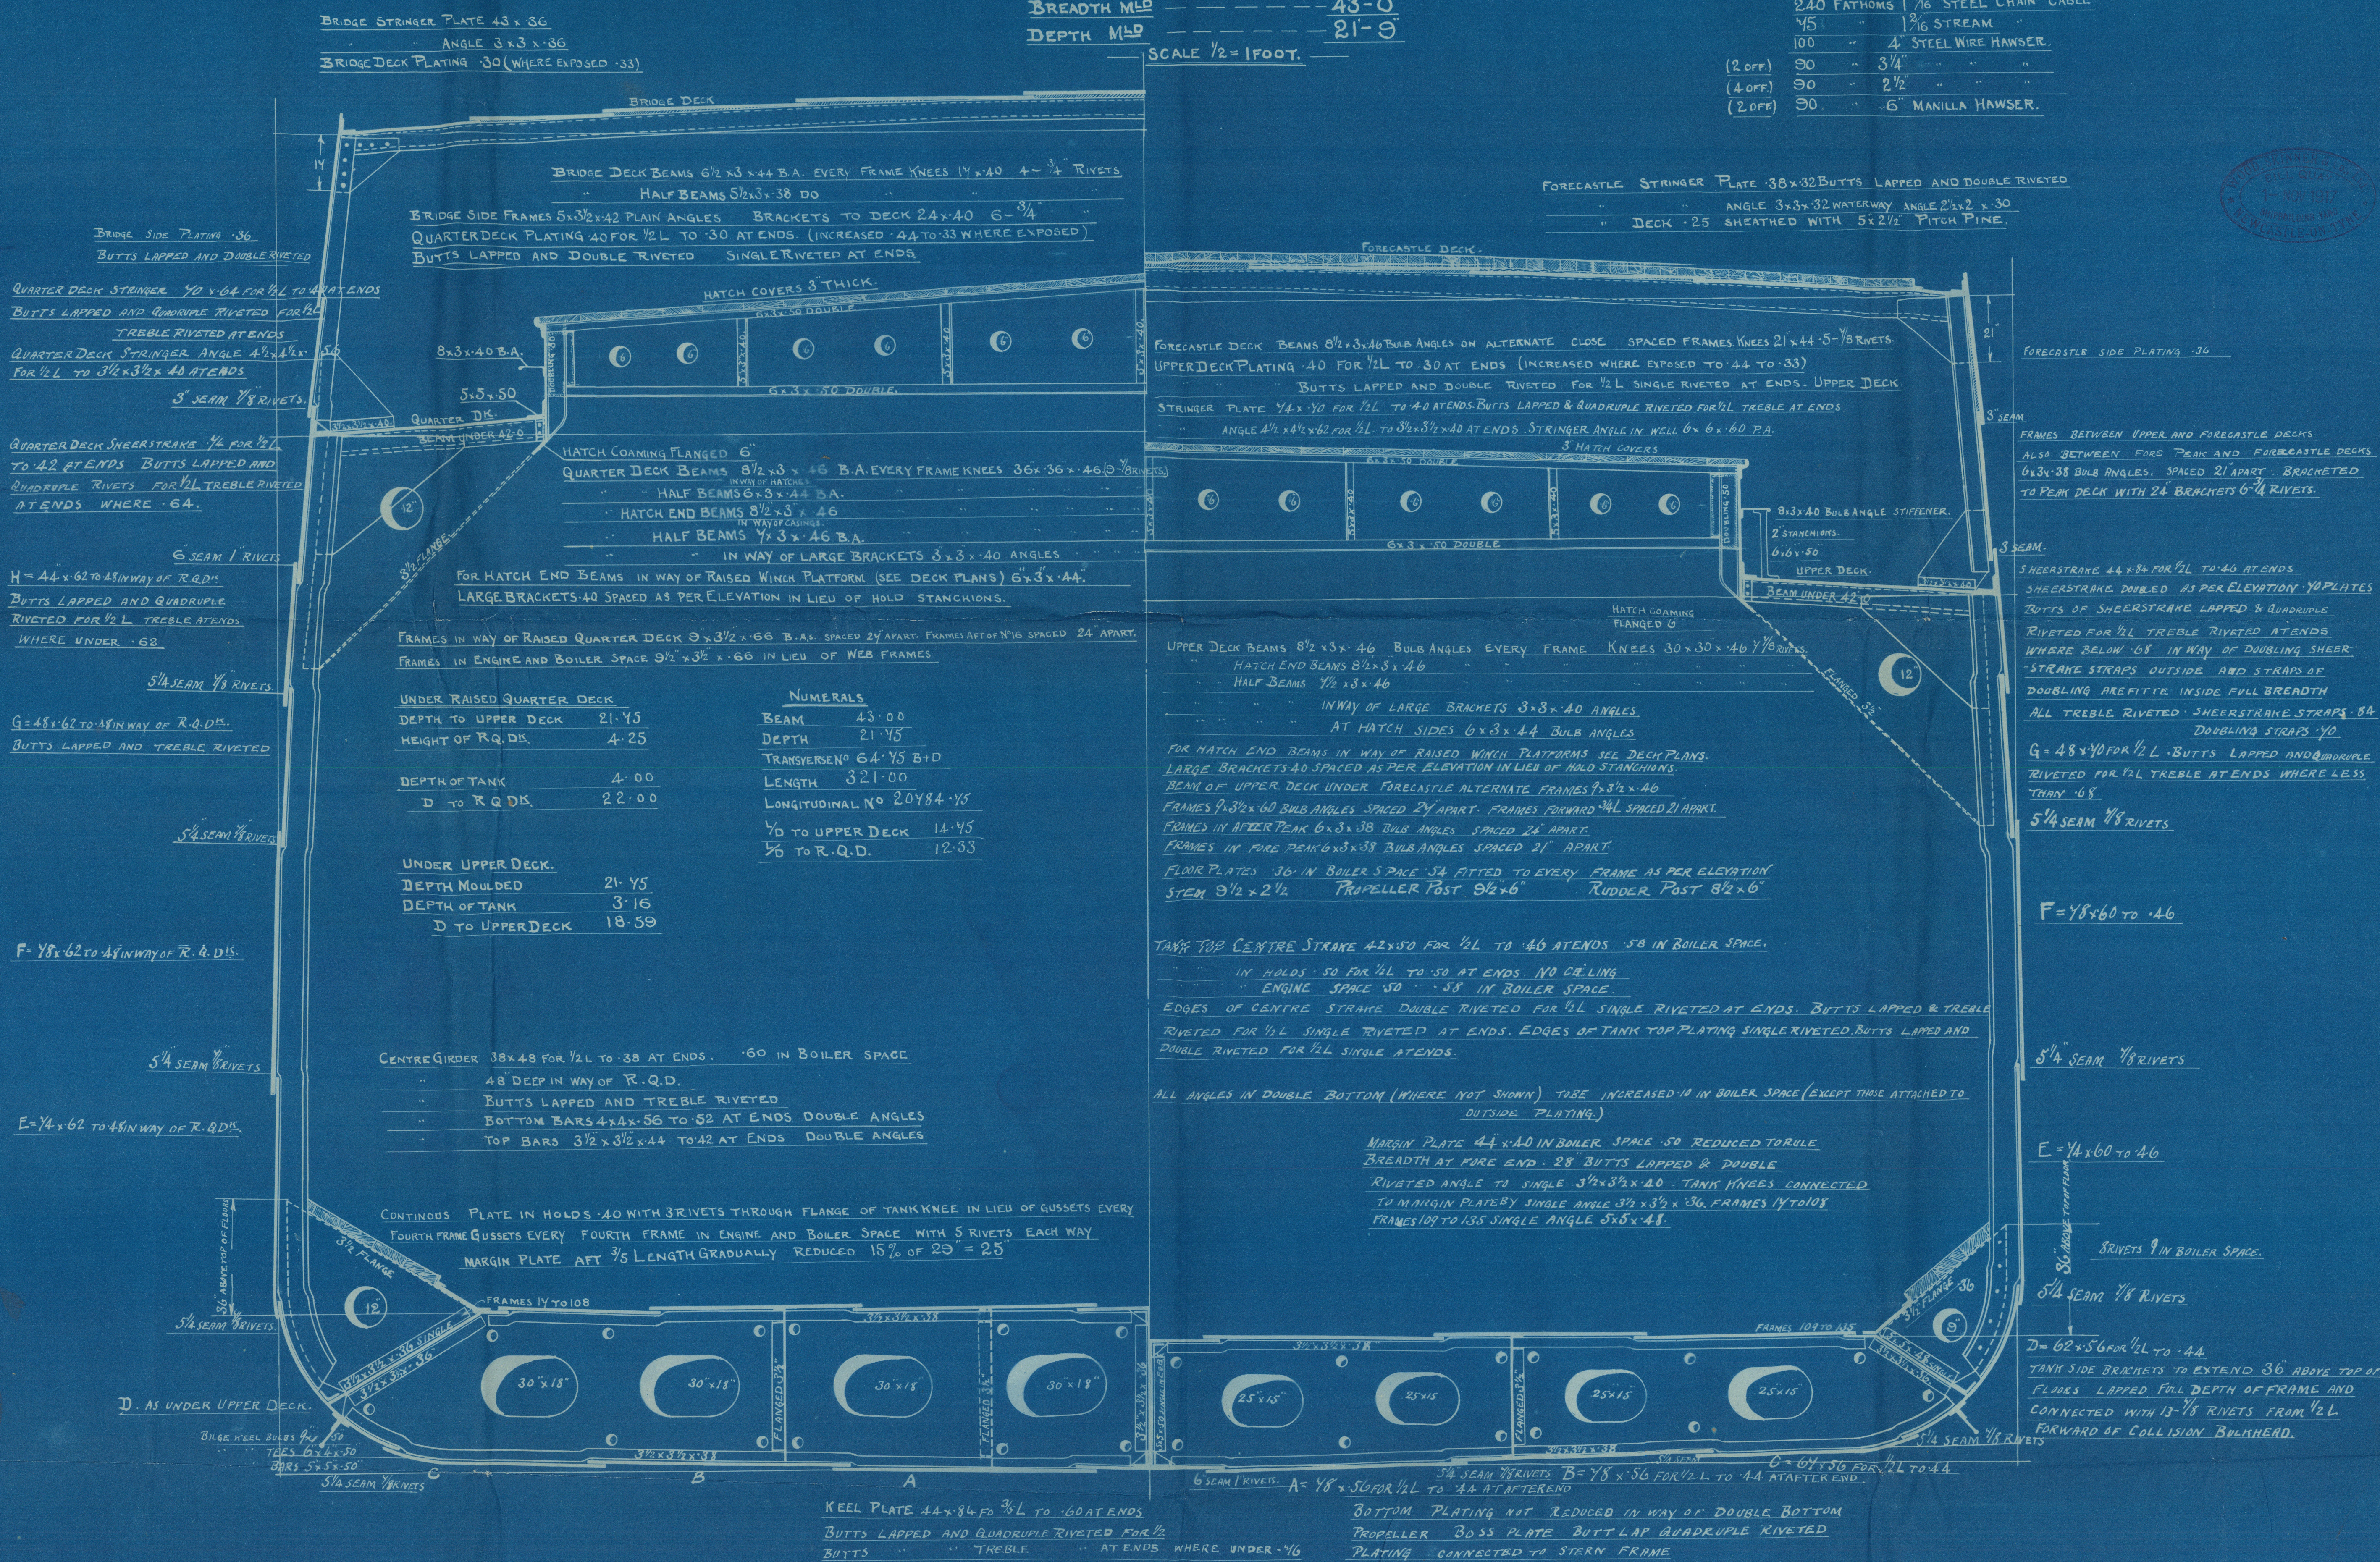

No 205.

Miss.
Wood Skinner & Co L^{ts}
No 205

"Wallsend"

- Friendship Station -
- as built -

S S "WALLSEND
NEWCASTLE ON TYNE.

Report No. 70407


RETAIN



© 2021

Lloyd's Register
Foundation

W763-0127

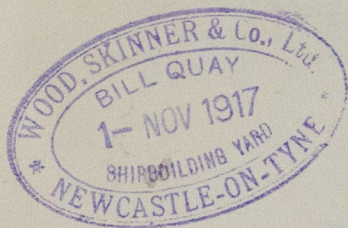

© 2021

Lloyd's Register
Foundation