


SCALE $\frac{1}{2}" = 1$ FOOT. TO CLASS 100 A.I. AT LLOYDS. RAISED QUARTER DECK TYPE.

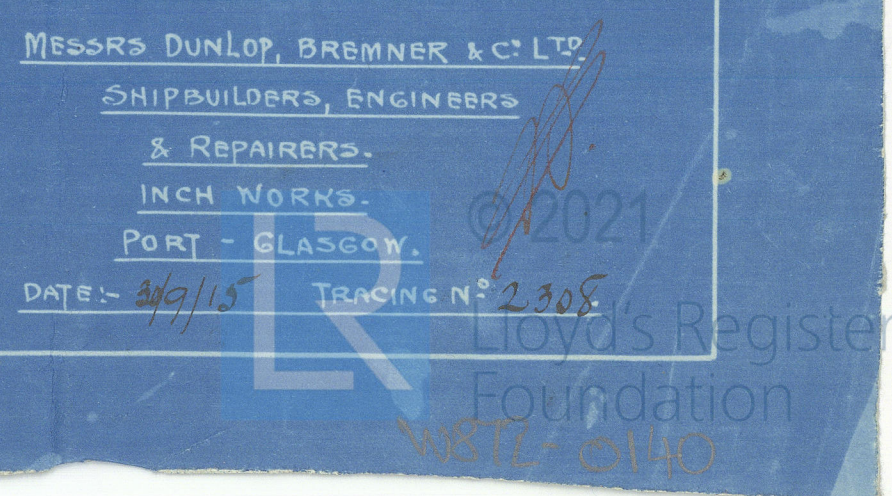

AS BUILT

Midship Section
Messrs Dunlop Bremner & Co.
No 286

S.S. "Ilston"
GR 1st Entry Rpt No 16927.



RETAIN

W872-0140



© 2021

Lloyd's Register
Foundation