

MIDSHIP SECTION.

— OF A —
WELL DECKED SCREW STEAMER

DIMENSIONS.

LENGTH ----- 255-0
BREADTH MLD ----- 38-0
DEPTH MLD ----- 19-6

CLASS 100. A. 1.

SCALE 1/2" = ONE FOOT

Lloyd's Numerals
Breadth MLD ----- 38.00
Depth MLD ----- 19.50
Transverse No ----- 57.50
255-
Longitudinal No 14662.50

Depths to length 13.07 Main Deck
— do — 10.85 P. Q. Deck.

Anchors & Cables.

Equipment No 15602

1st Bower ex stock 26 1/2 cuts of Stockless 33 cuts
2nd do do 26 1/2 " " do do 33 " "
3rd do do 22 " " do do 28 " "
Stream ex stock 8 1/2 " "
Kedge do do 4 1/2 " "
240 fathoms Stud Chain Cable 1 1/4"
75 do Stream Chain 1 1/4 or 4 Steel Wire


Hawsers & Warps.

90 fathoms Towline 11 or 3 1/2 Steel Wire
2-90 do Hauler 6 or 2 1/2 do
2-90 do Warps 5 or 2 1/2 do


Steel Wire with
Owners Consent

Bridge Stringer Plate 4-1 x 34
do Angle 3 x 3 x 34
Side plating 34
Wood Deck 5 x 3 P.P.

W/C Stringer Plate 25 x 30
do Angle 3 x 3 x 30
Plating under Windlass 30
Side Plating 34
Wood Deck 5 x 3 P.P.

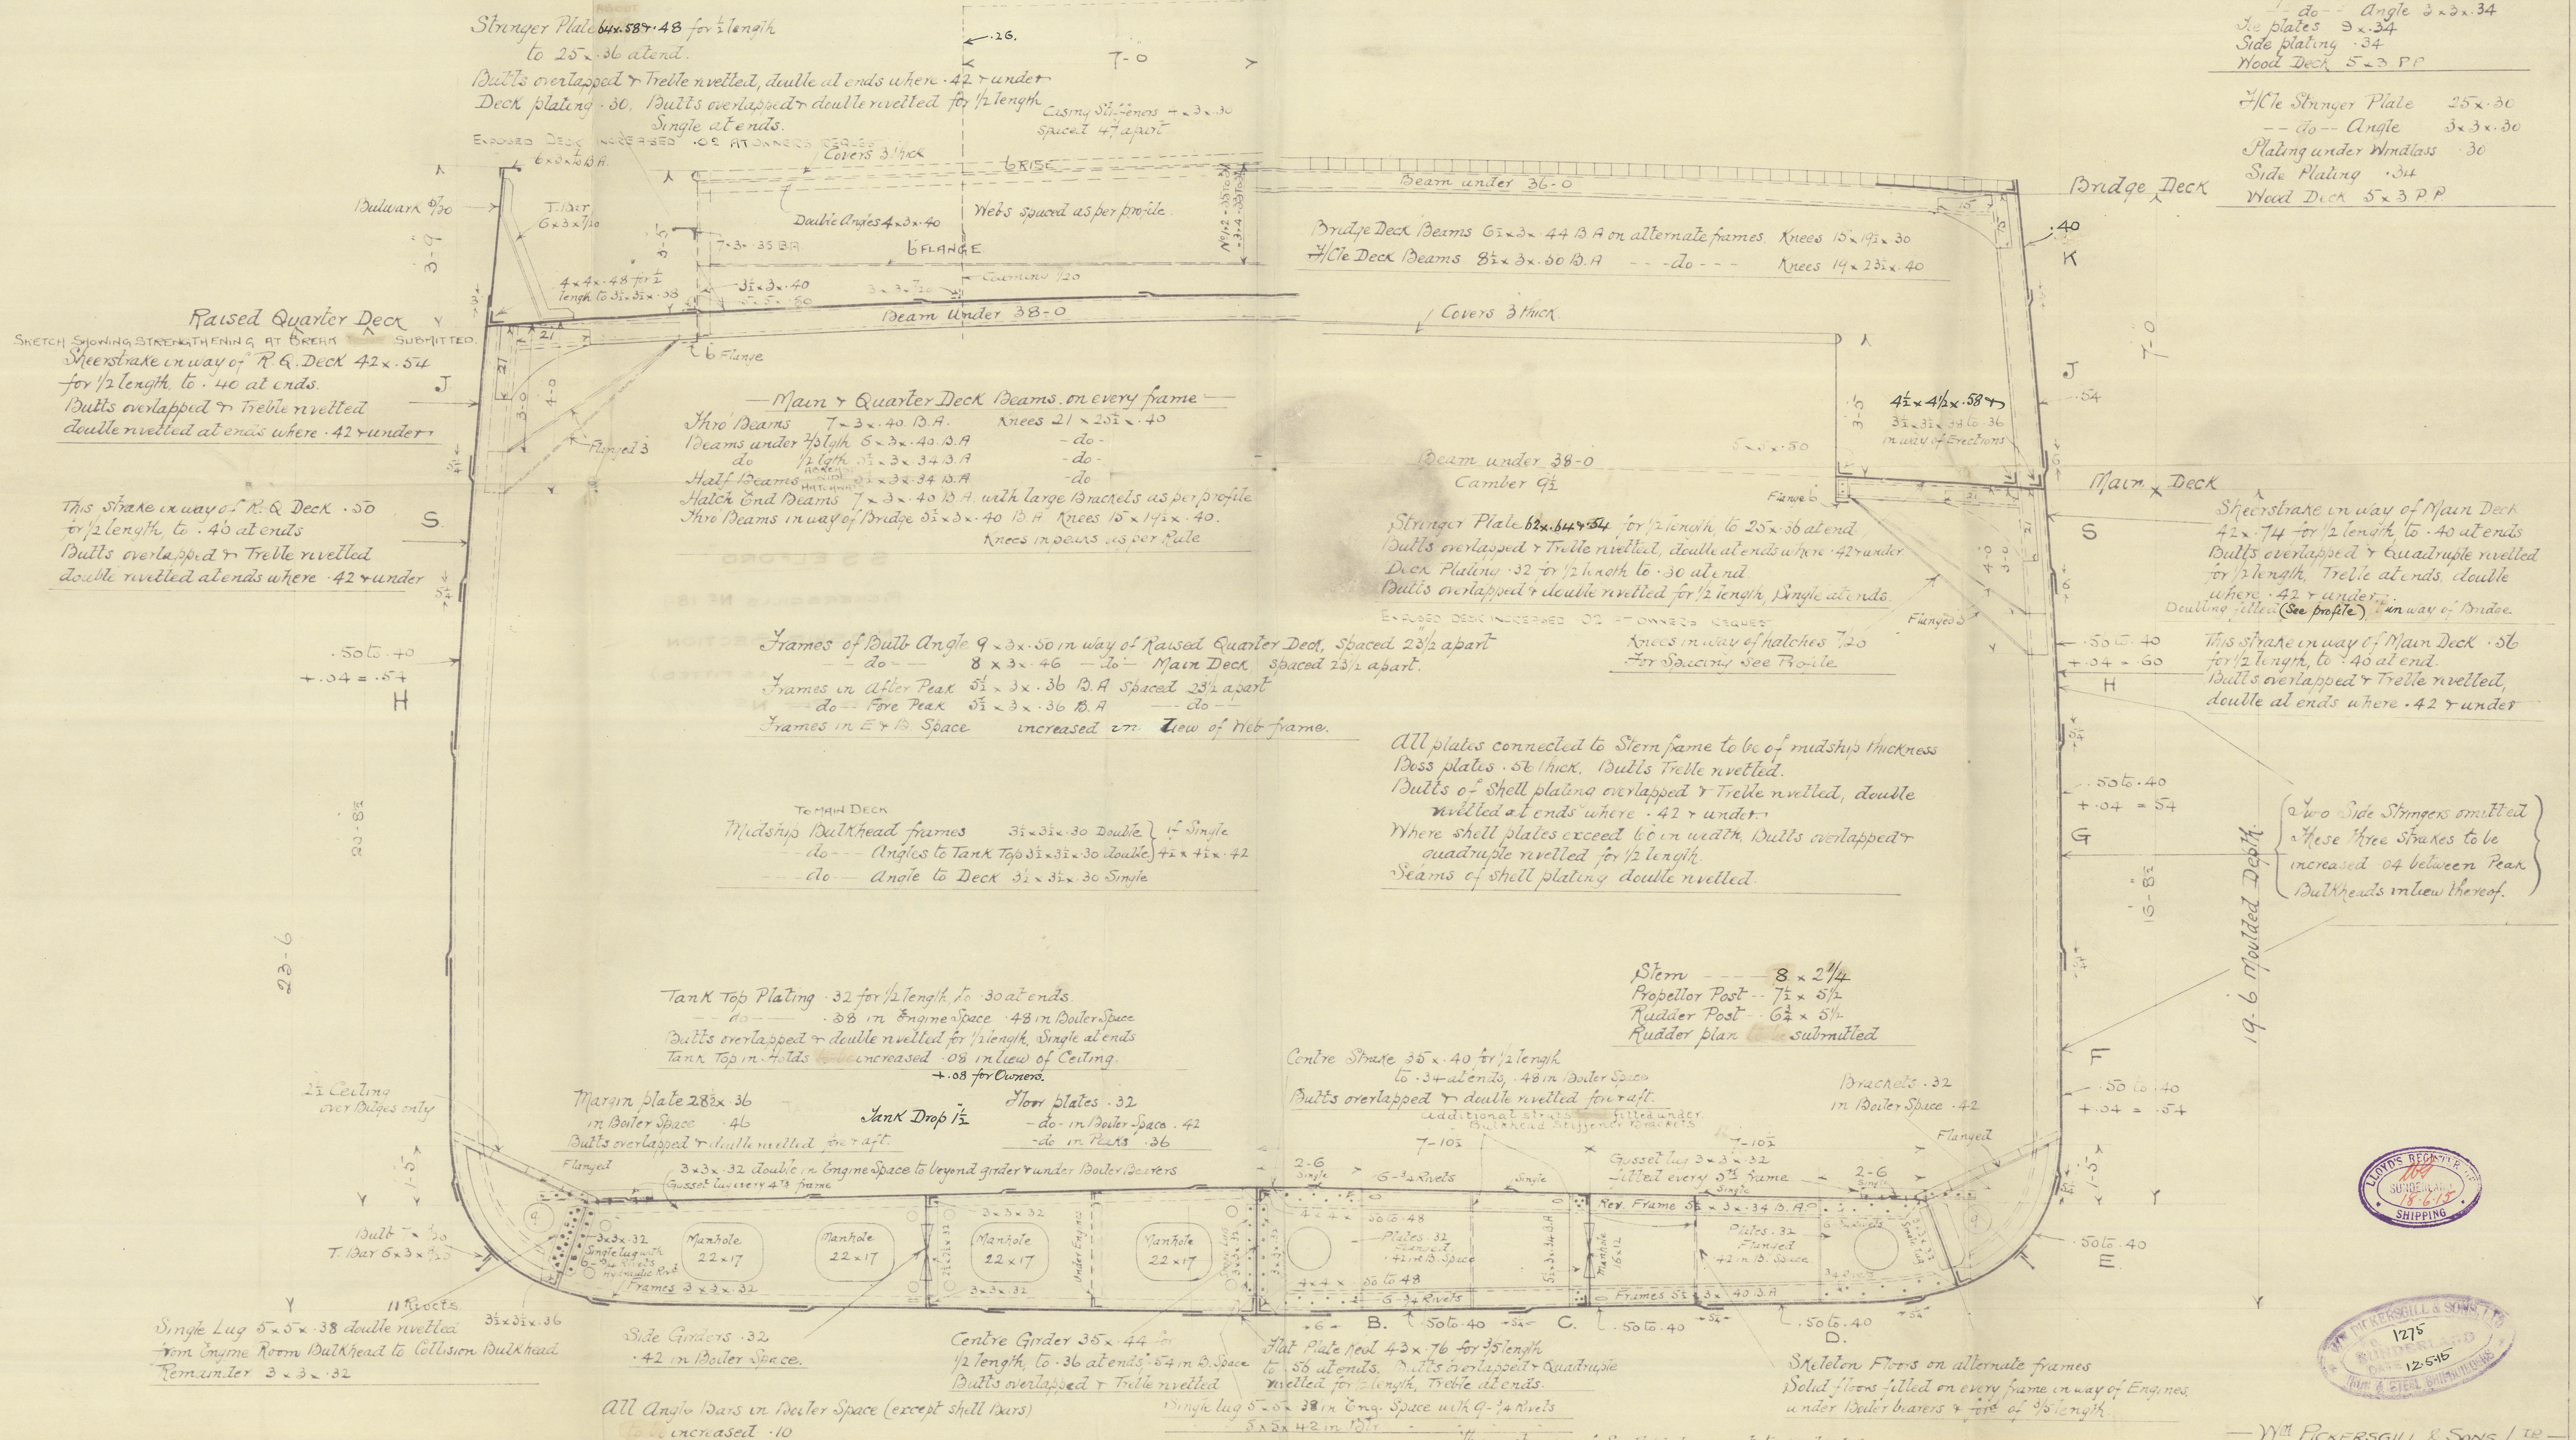

Two Side Stringers omitted
These three stringers to be
increased .04 between Peak
Bulkheads in lieu thereof.

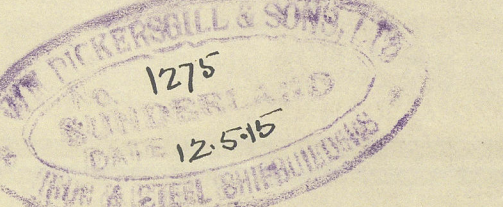

W. WICKERSGILL & SONS LTD
SHIPBUILDERS
SOUTHAMPTON

No 189.

Corrected to Lloyd's 13/10/1914.
" as built 14/8/15.

Lloyd's Register
Foundation

S. S. ELFORD

PICKERSGILLS N° 189

MIDSHIP SECTION

(AS FITTED)

SLD RPT N° 26476

RETAIN

SUNDERLAND RPT. No. 26476

RETAIN



© 2020

Lloyd's Register
Foundation