

MIDSHIP SECTION

- No 308 -

SCALE 1/2" = 1 FOOT

LENGTH ON LOAD LINE 284'-6"


BREADTH MOULDED 41'-6"

DEPTH MOULDED 21'-1"

CLASS 100. A.1 Lloyds Special Survey.

S. P. AUSTIN & SON, LTD.
SHIPBUILDERS & REPAIRERS,
WEAR DOCK YARD,
SUNDERLAND.
Date 1.12.24
Reference No. 1111

EQUIPMENT NUMERALS	
R.O. DECK	164.6 x 4.5 = 740.70
FORECASTLE	31.7 x 2.5 = 79.25
CASINGS + ENGINEERS HOUSES	47.8 x 7.2 = 344.16
FORWARD LOWER HOUSE	11.5 x 7.2 = 82.80
FORWARD UPPER HOUSE	11.5 x 7.2 = 82.80
	1091.26
L(B+D)	17804
EQUIPMENT No	18895 18960

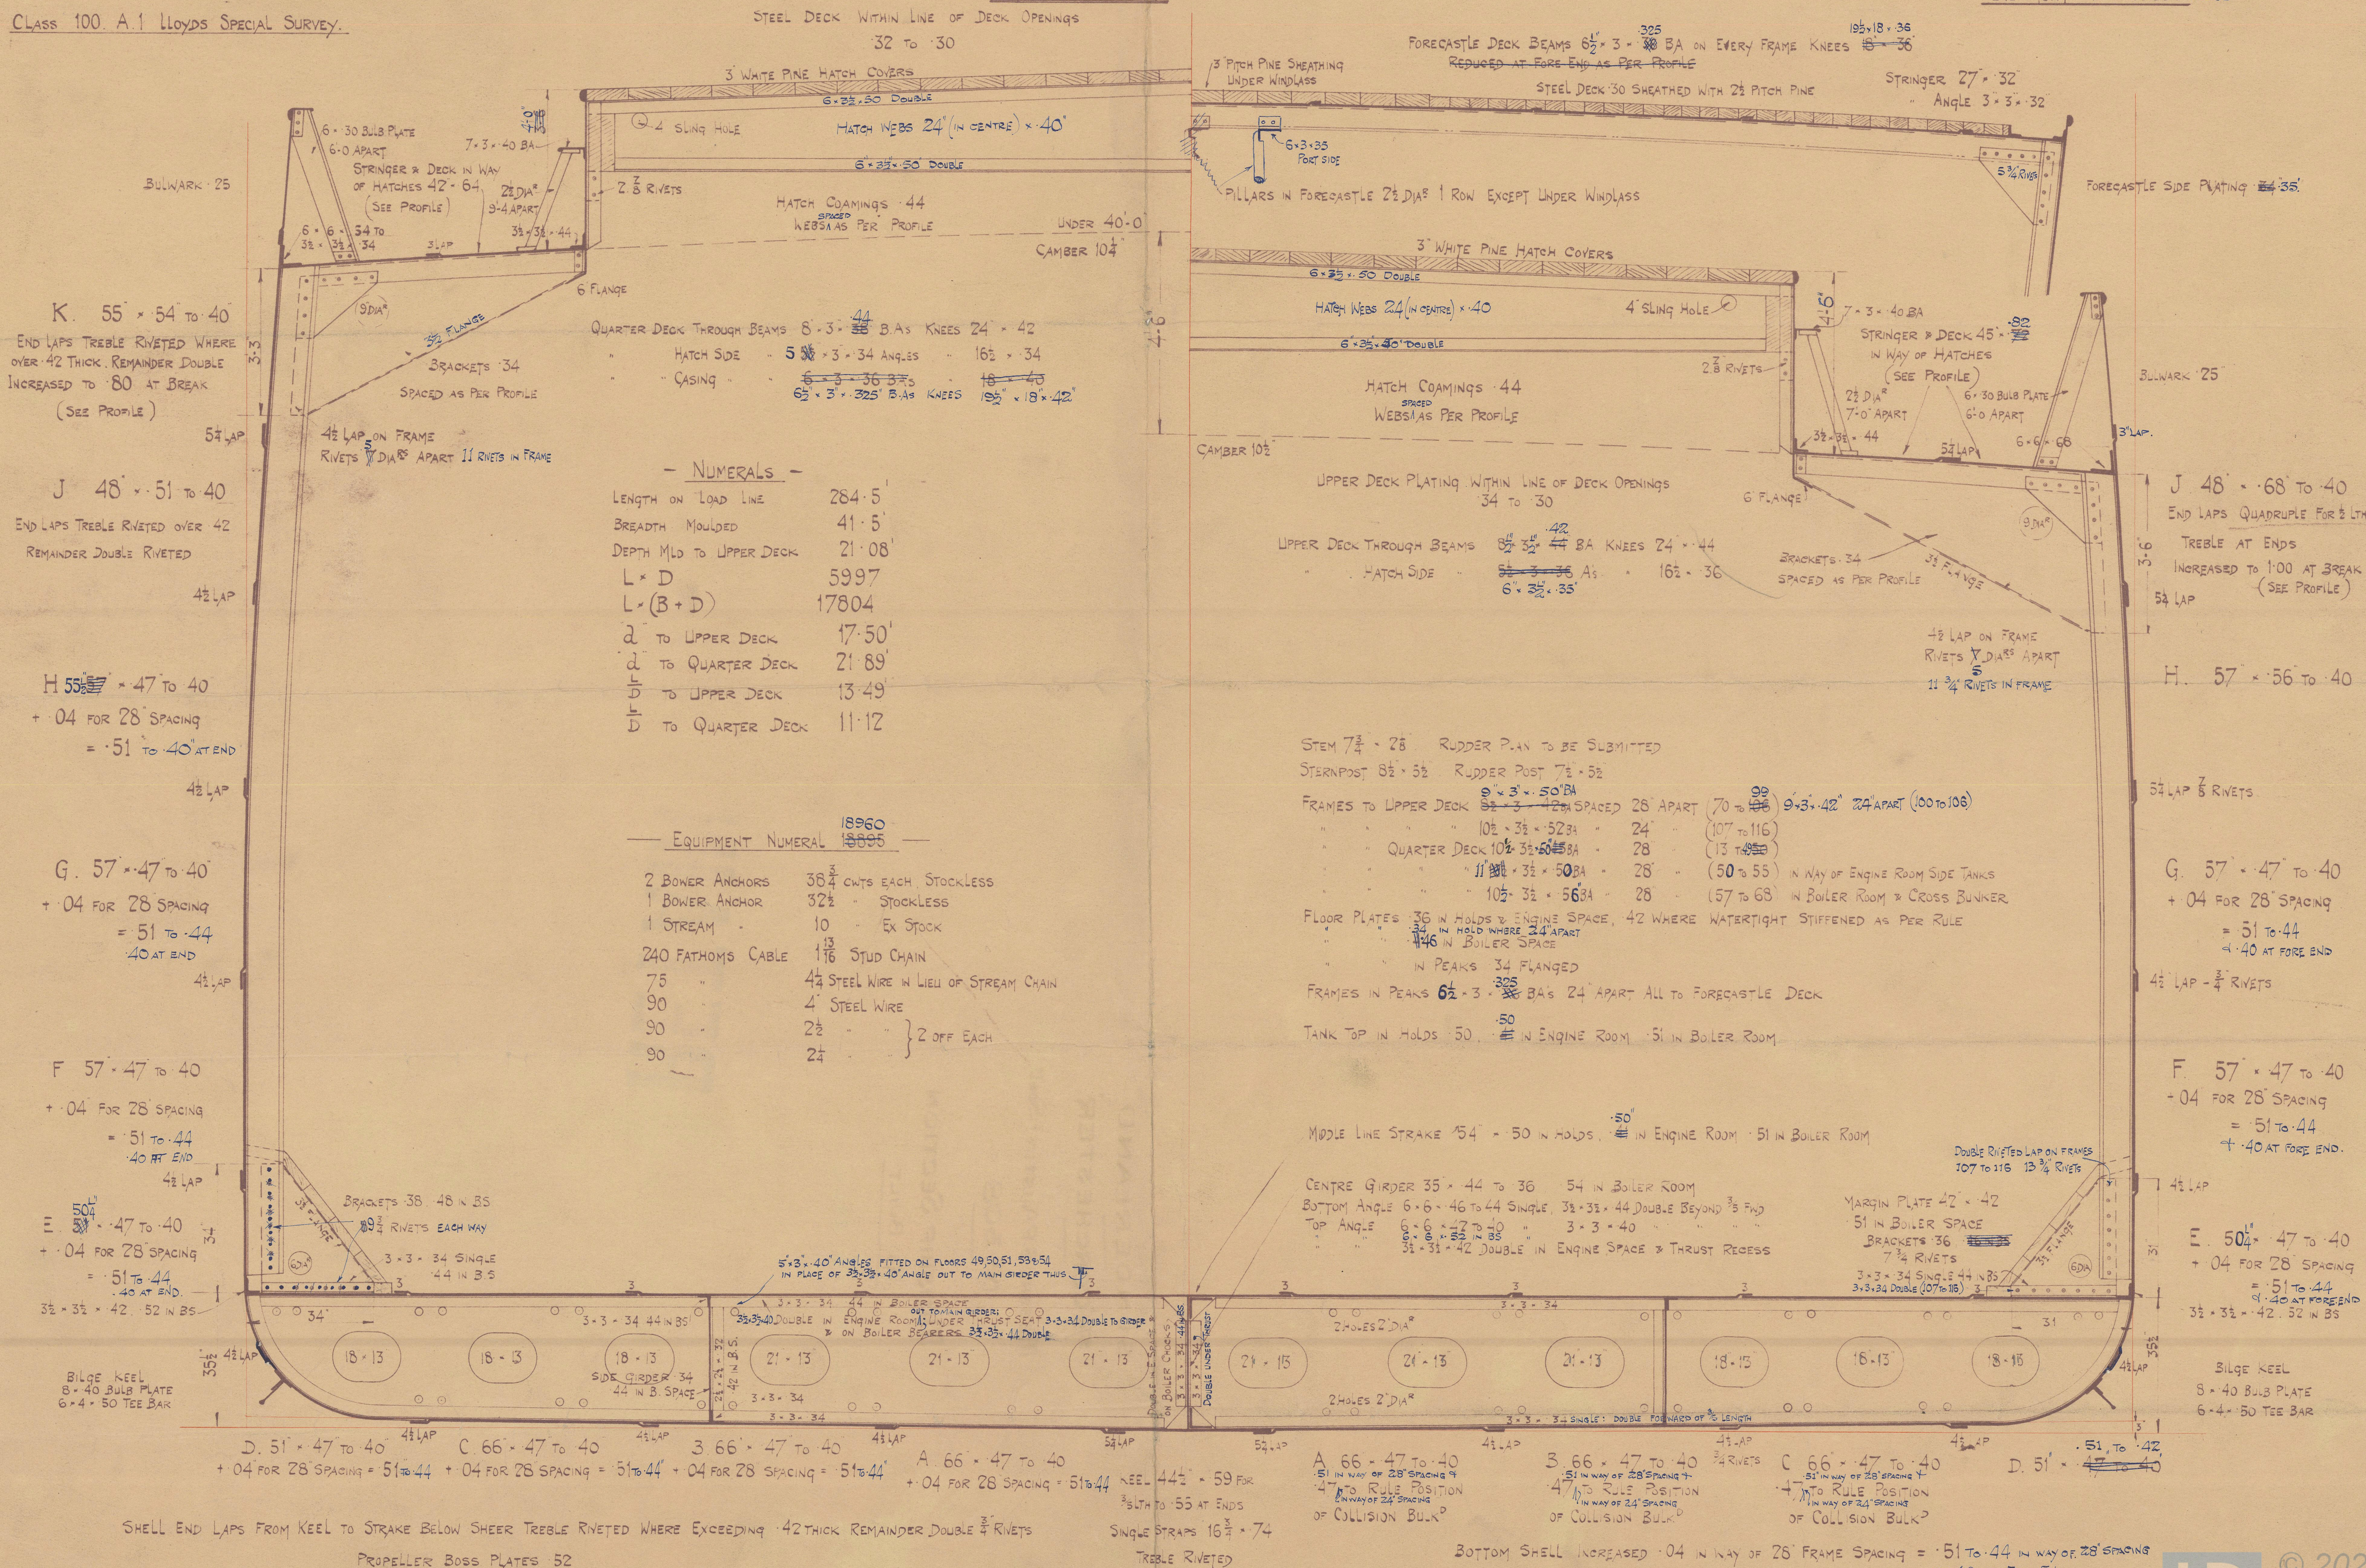

NOTE: THIS PLAN IS A COPY OF SECTION ORIGINALLY SUBMITTED IN APRIL 1924
NOTES & CORRECTIONS IN BLUE AS ACTUALLY FITTED IN SHIP

SUNDERLAND
S/S "CORCHESTER"

MESSRS S. PAUSTIN & SONS
Nº 308

MIDSHIP SECTION
As BUILT

SLD. RPL. NO. 29410.

RETAIN

002038-002050-0068



© 2020

Lloyd's Register
Foundation