

LENGTH FROM AFTER SIDE OF STEM TO FORE SIDE OF STERN POST 134'-0"  
 BREADTH MOULDED 25'-3 1/2"  
 DEPTH TO SKIN ASSUMING 7 1/2" ROUND UP OF BEAM 14'-5 1/2"  
 DEPTH TO LENGTH 13'-4 1/2"

# MIDSHIP SECTION

## DIMENSIONS.

LENGTH B.P. 195'-0" BREADTH EX 30'-0" DEPTH M.L. 13'-10"  
 TO CLASS 100 A.I. AT LLOYD'S "RAISED QUARTER DK"

SCALE 1/2" = 1 FOOT

## EQUIPMENT.

LENGTH OF QUARTER DECK 108'-2" x 3'-6" BRIDGE 12'-10" x 7'-6"  
 F'SLE 24'-0" x 7'-0"  
 EQUIPMENT NO 11992 LETTER K.  
 3 BOWERS STOCKLESS COLLECTIVE WEIGHT 5 1/4 CWTs  
 1 STREAM ANCHOR EX STOCK 3 1/4 "  
 1 KEDGE 2 1/2 "  
 210 FATHOMS OF 1 1/2" STUD CHAIN CABLE  
 60 " " 3/4" STEEL WIRE STREAM  
 30 " " 3 " TOWLINE  
 30 " " 2 1/4 " HAWSER WITH OWNERS  
 50 " " 1 3/4 " WARP CONSENT.


## NUMERALS

1/2 GIRTH	26-58
1/2 BEAM	14-85
DEPTH	14-45

35-32 1<sup>ST</sup> N° + 35 = 59-42 N° FOR QU. DK. FRAME &c.

184-0

10848-48 2<sup>ND</sup> N°

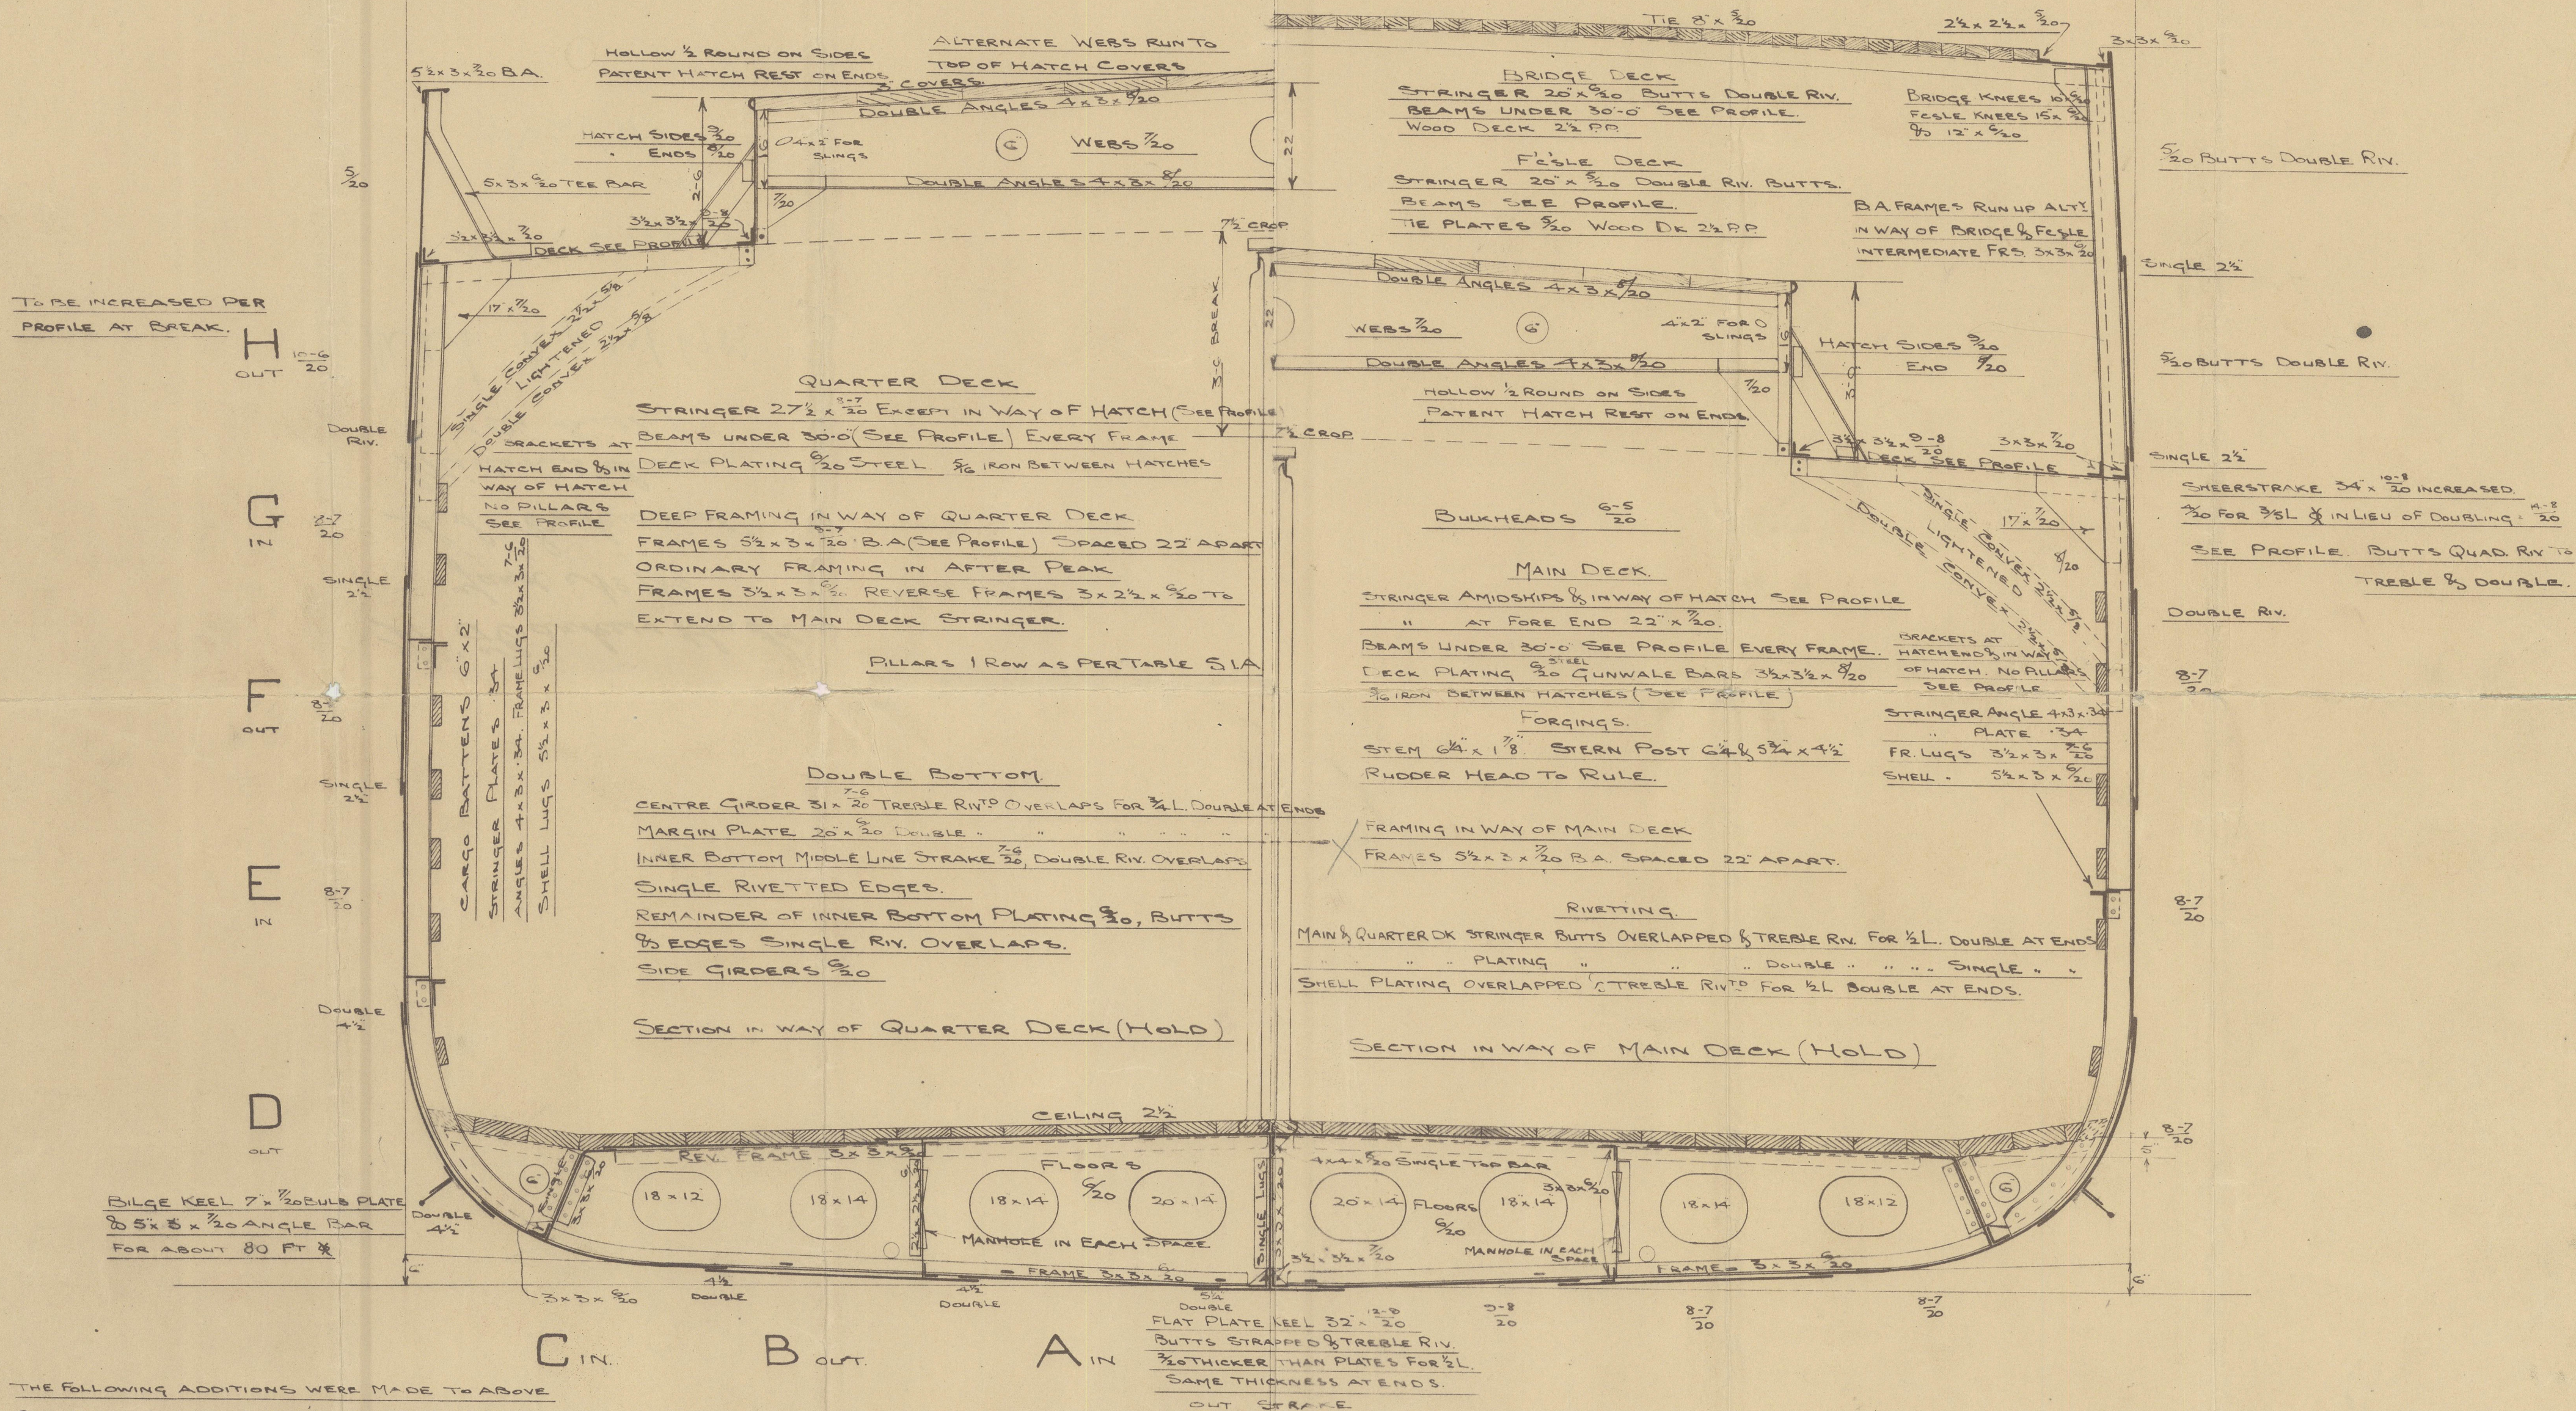

THE FOLLOWING ADDITIONS WERE MADE TO ABOVE

SCANTLING'S PER OWNERS REQUIREMENTS.


- 30 ON FRAMES IN TANK
- 30 " REV FR. THROUGHOUT BOTTOM
- 30 " SHELL A STRAKE FR. 3 TO 101.
- " " B. " " G. " 97.
- " " C. " " 25 " 89.

- 30 ON INTER PLATE EACH SIDE IN TANK & BOILER ROOM.
- 20 " " BARS TOP & BOTTOM.
- 20 " BULB ANGLE FRAMES BETWEEN PEAK BULKHEADS
- 30 " TANK TOP (EXCEPT CENTRE STRAKE) & MARGIN PLATE

## SECTION IN WAY OF E & B SPACE

FLOORS IN BOILER SPACE 18 1/2 x 16 IRON  
 " " ENGINE " " 20 AFT OF 30

SAME THICKNESS AS FLOORS.

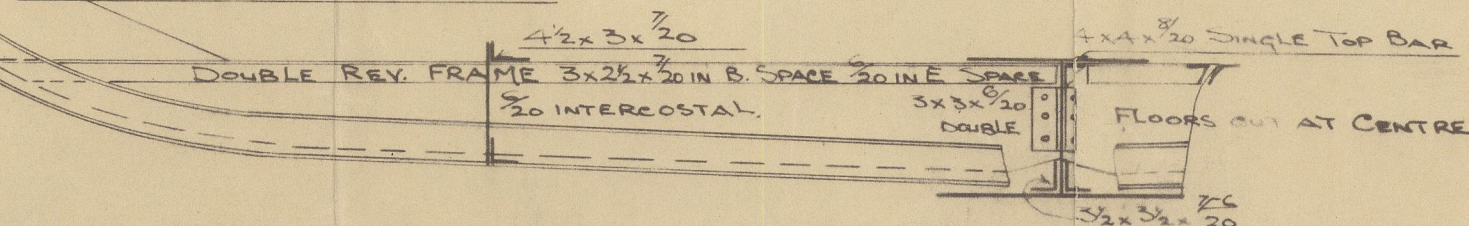


WHARFESS & SON LTD

SHIPBUILDERS & REPAIRERS

EAST SLIPWAY

MIDDLESBROUGH-ON-TEES.

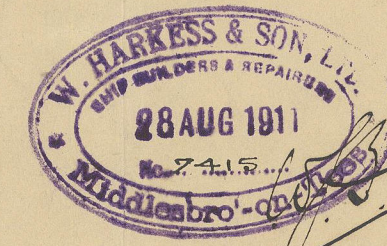



H. Harkness & Son Ltd  
Yard No 189  
S.S. "Eskwood"  
Midship Section  
(as built)

Mar. Report 1983

Ridworth



© 2020

Lloyd's Register  
Foundation

002062-002070-0274