


TO CLASS + 100 A.I. STEAM TRAWLER.

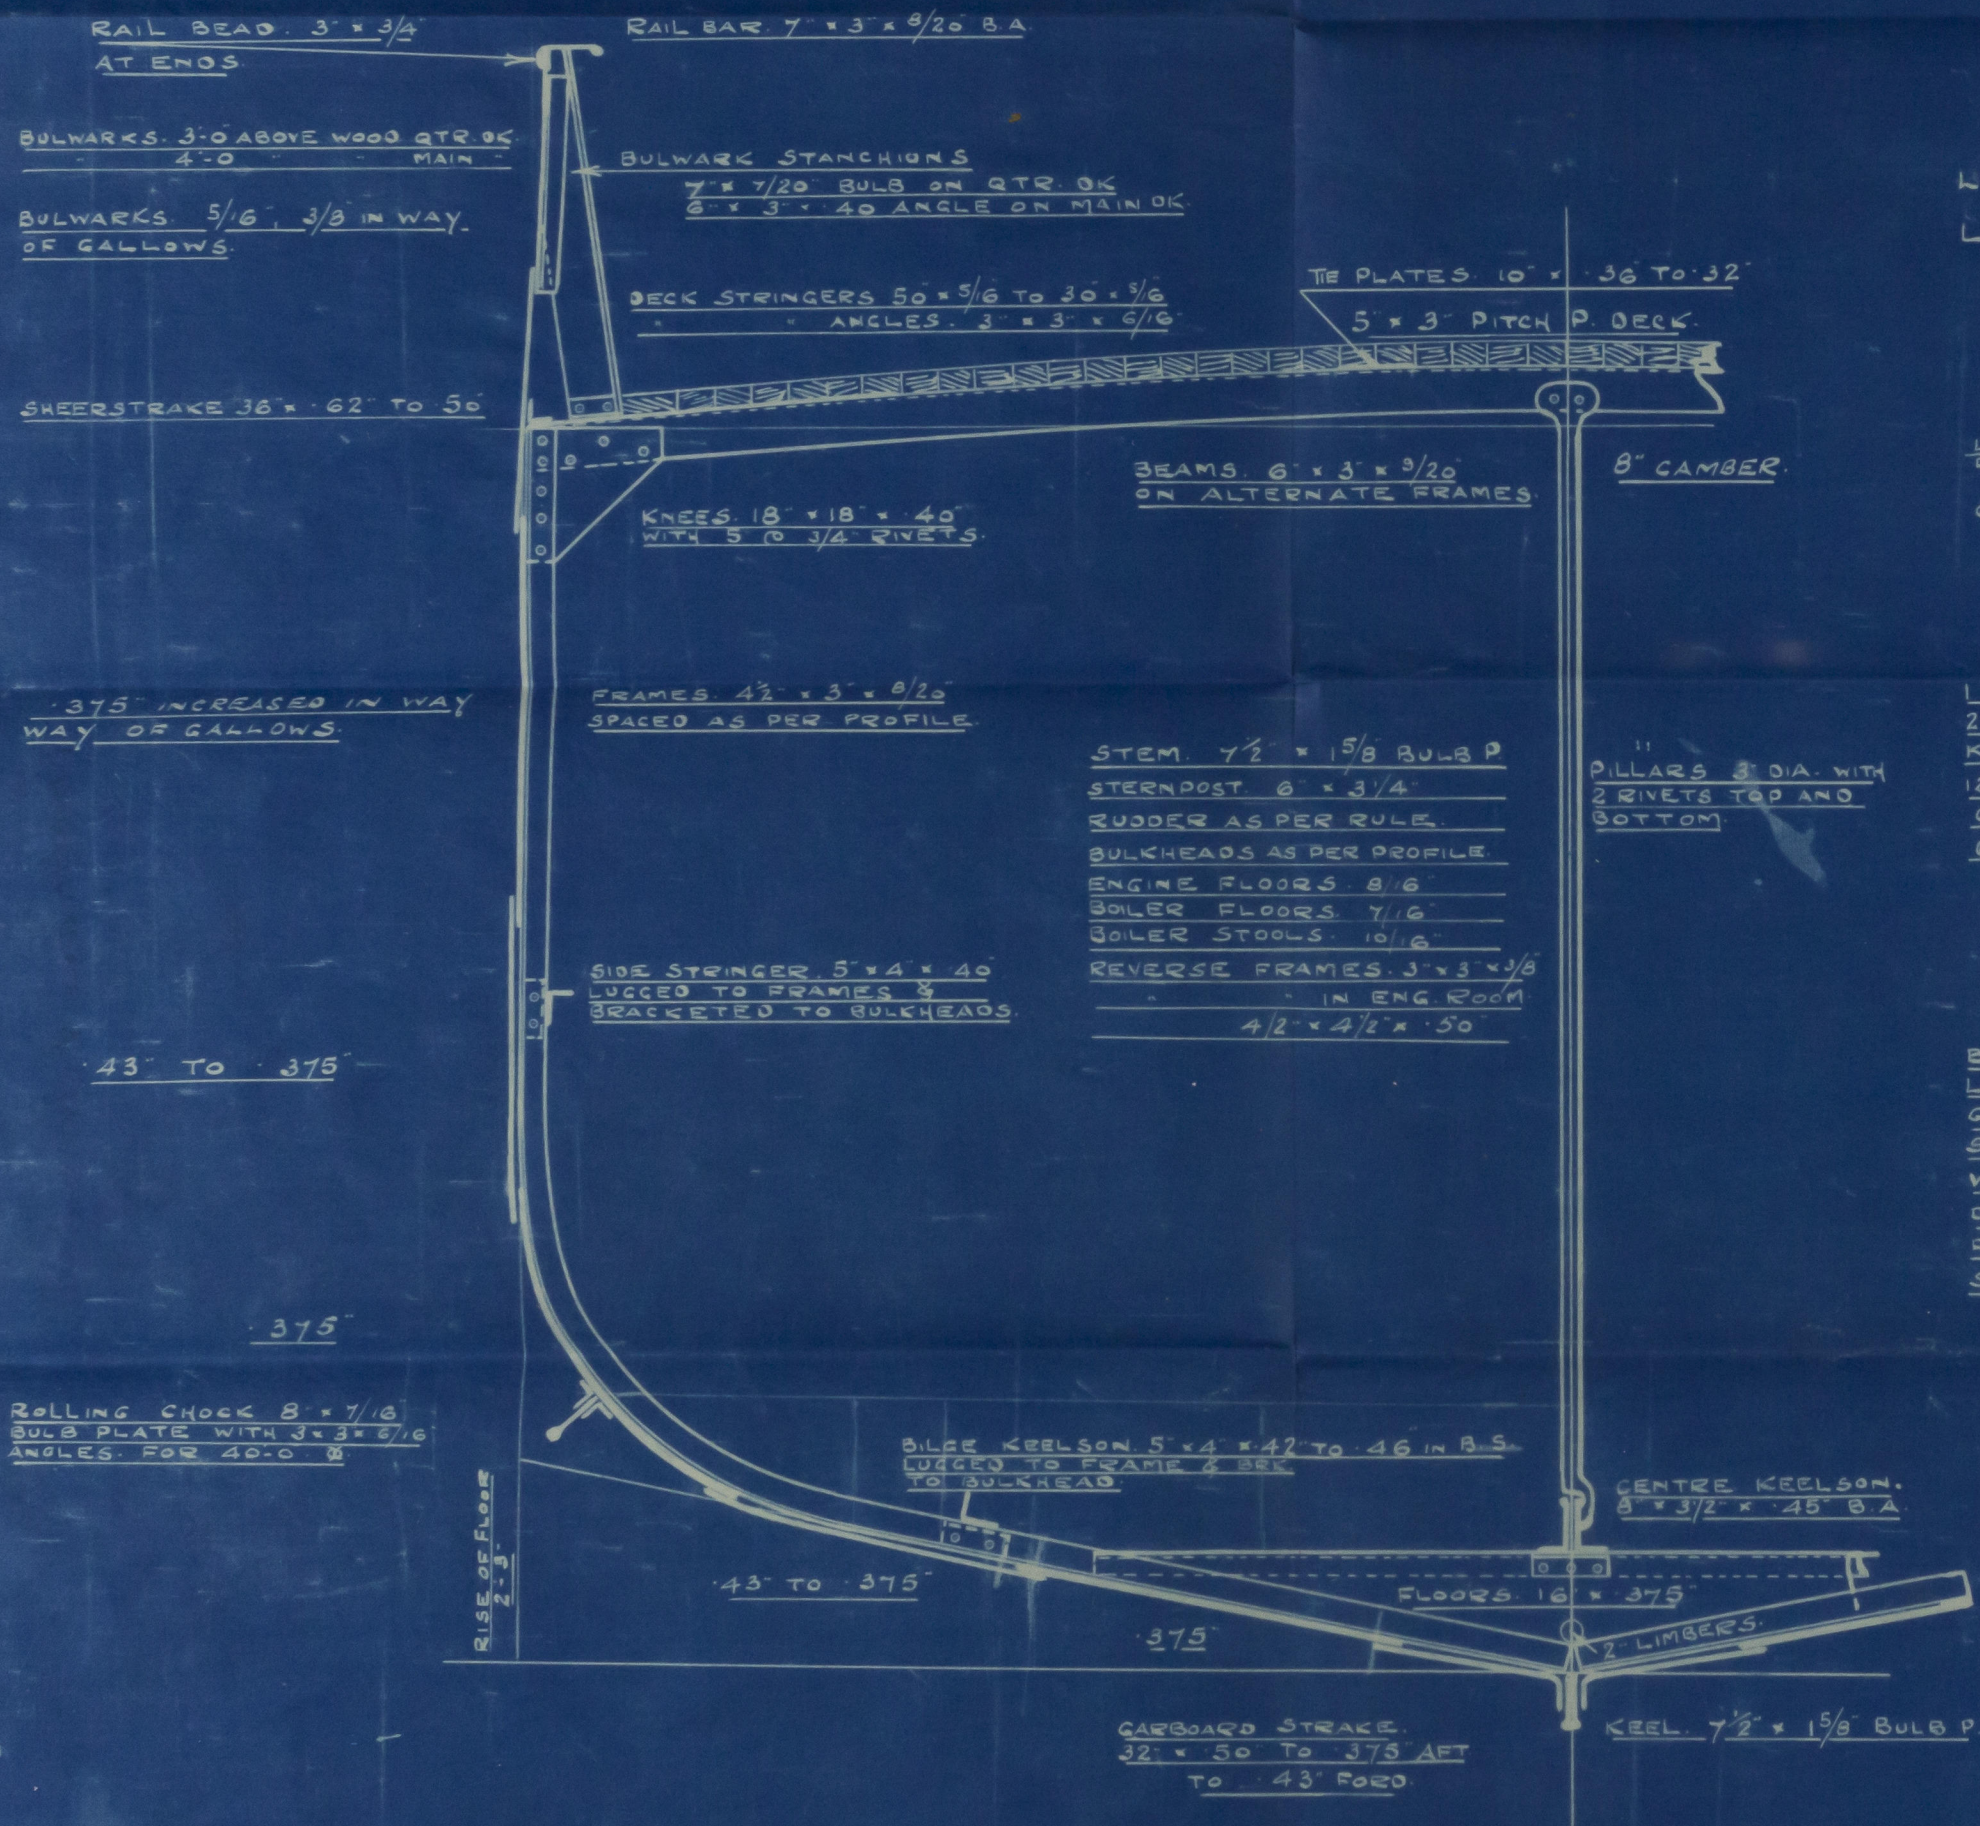

BUTTS OF SHELL PLATING TO BE
LAPPED & DOUBLE RIVETED EXCEPT
GARBOARD, SHEER STRAKE & E & F
STRAKES IN WAY OF CHAFING BAR
WHICH ARE TO BE STRAPPED &
DOUBLE RIVETED. ALL LANDINGS
DOUBLE RIVETED. BULWARKS
SINGLE RIVETED.

1028.

MidShip Section.
(as built)

M.S. "LORD GRAY."
Cochrane & Sons. Ltd.

S.S. "Lord Grey"

INVESTIGATION REPORT No. 39418



© 2020

Lloyd's Register
Foundation

002101-002108-0067