






N°1136. PROFILE & DECKS.

DIMENSIONS - B.P. 245'-0", BREADTH M^{LD} 37'-0", DEPTH M^{LD} 20'-0" (UPPER DK).


SCALE 1/8" = 1 FT.

ISHERWOOD SYSTEM PATENT.

CLASS 100 A1 LLOYDS.

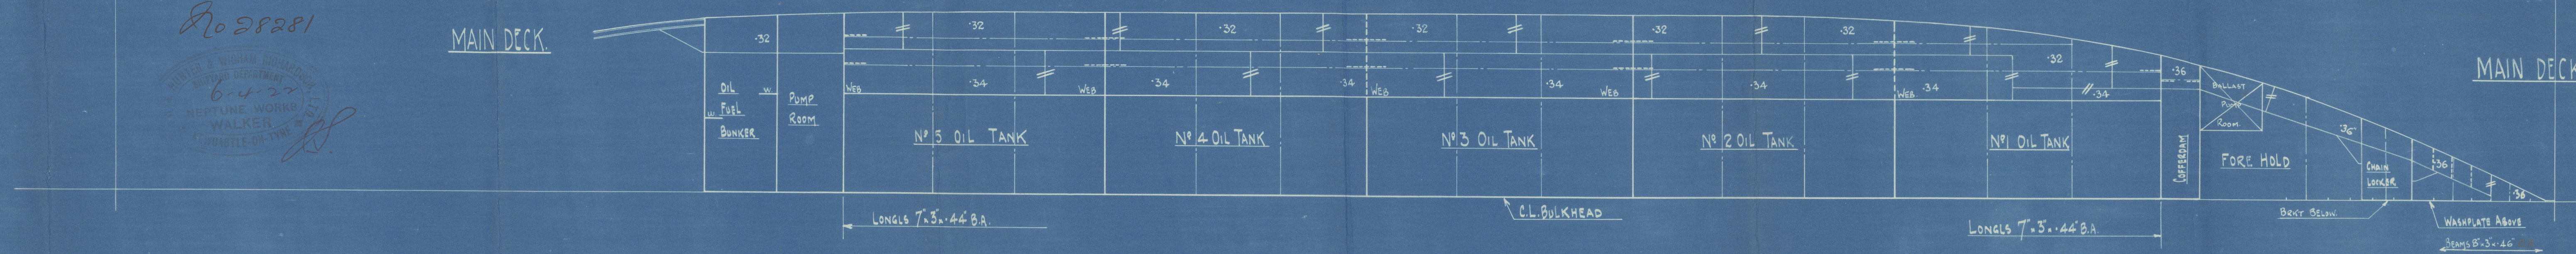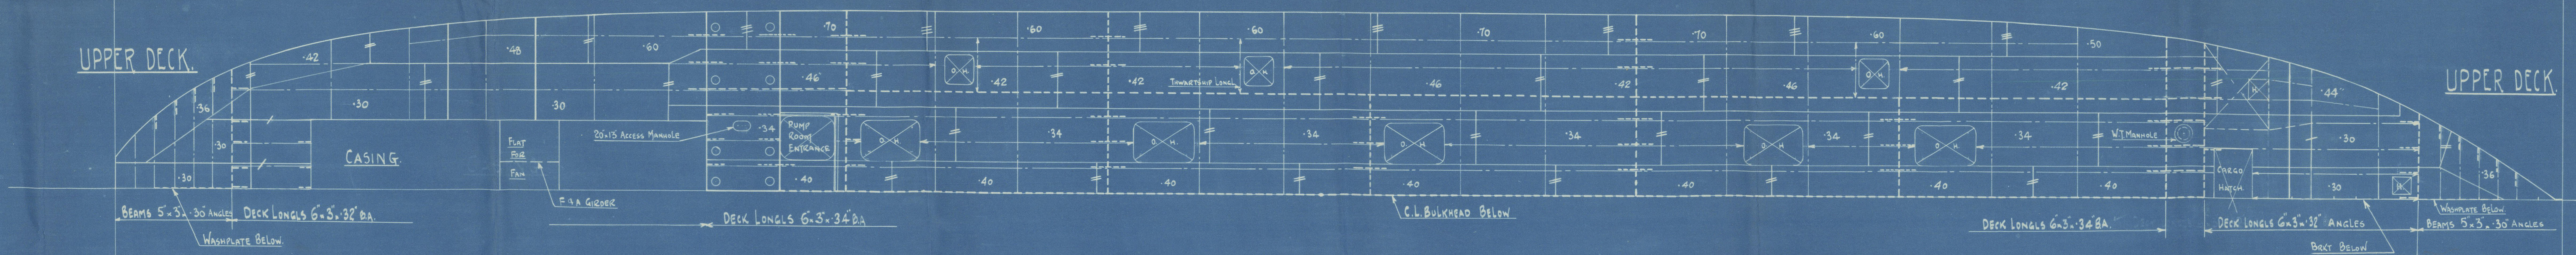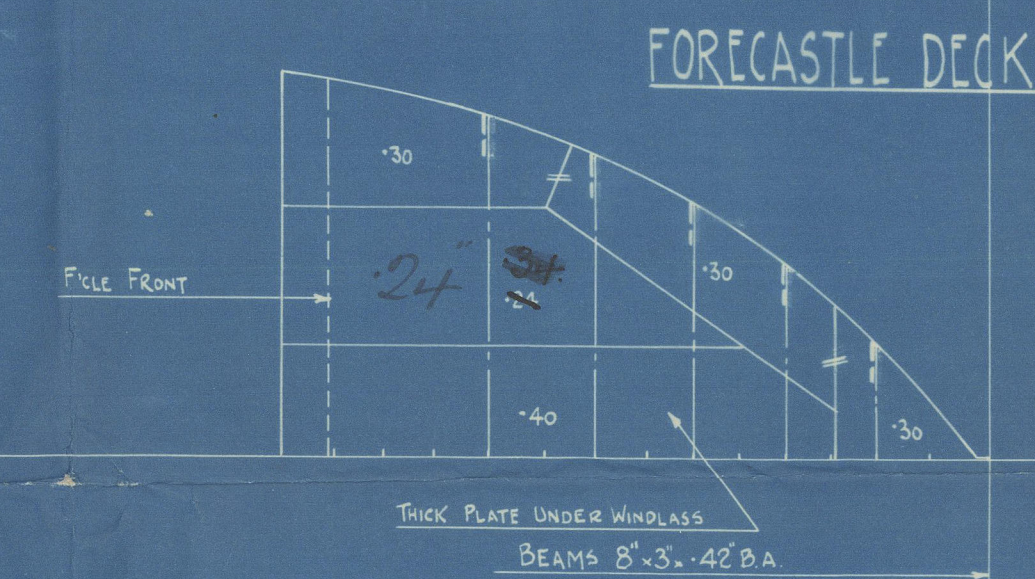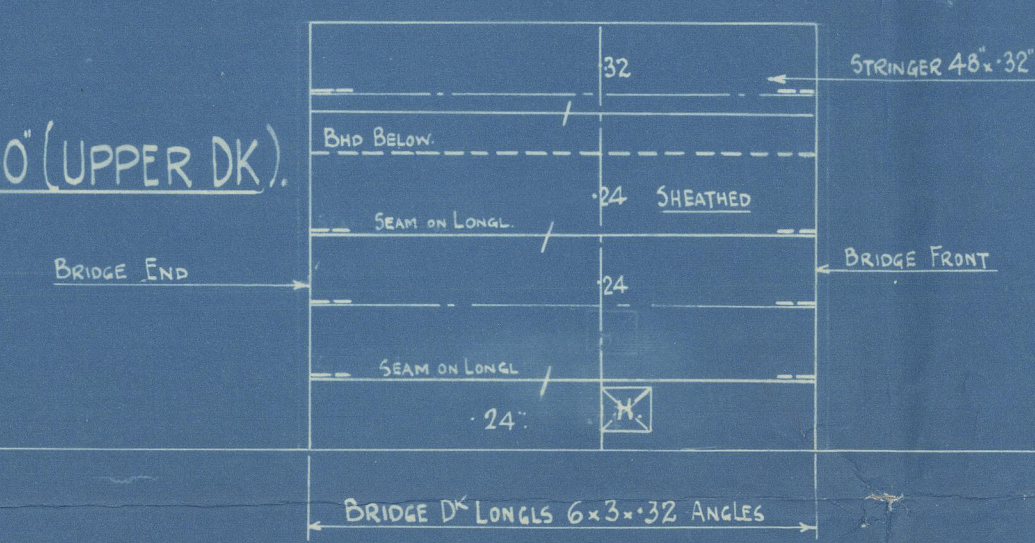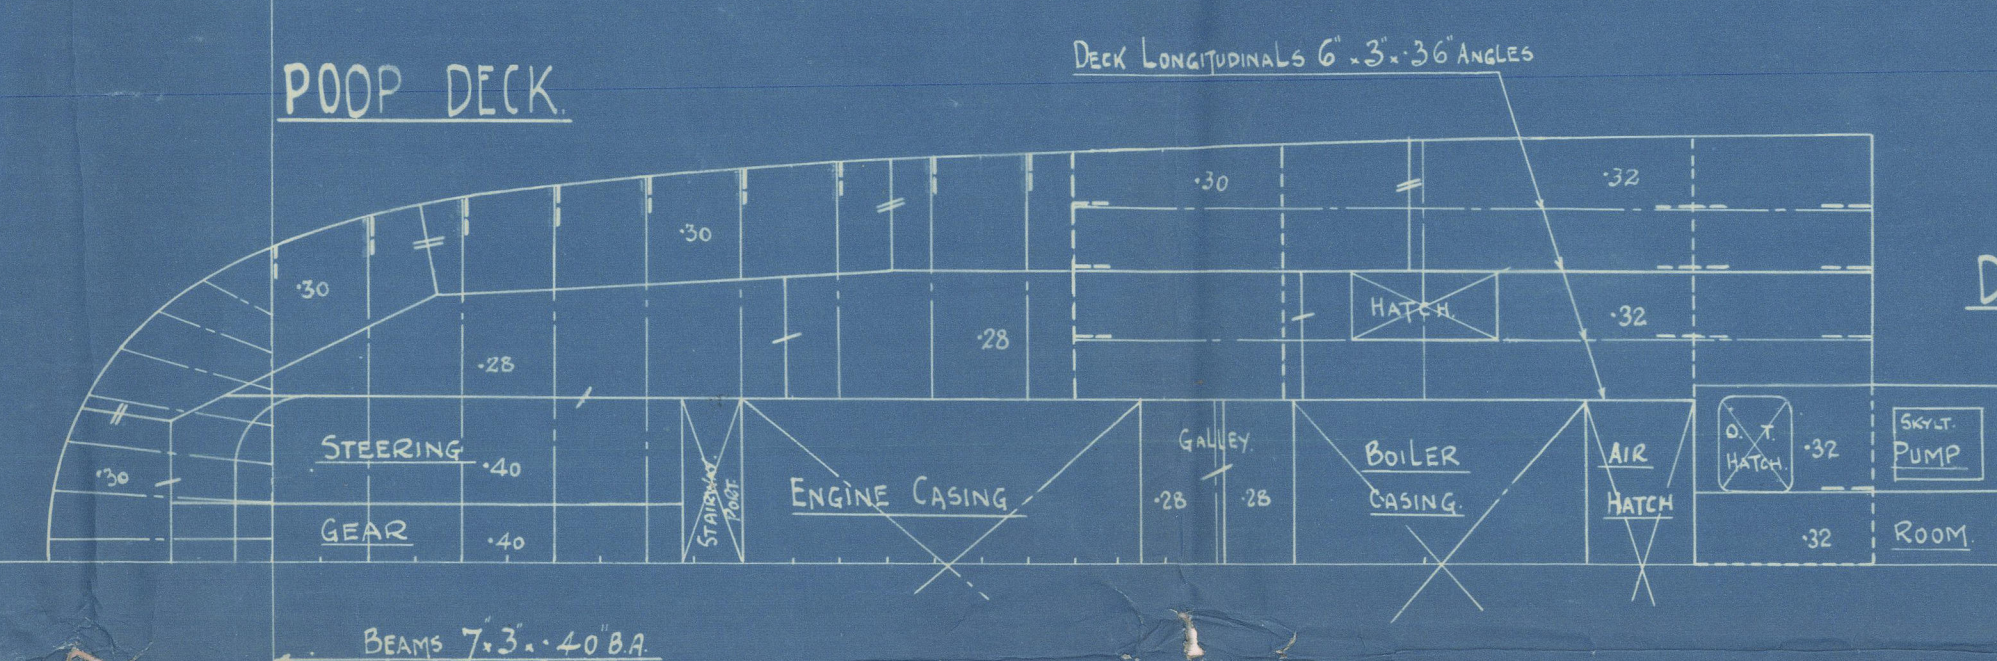

No 28281

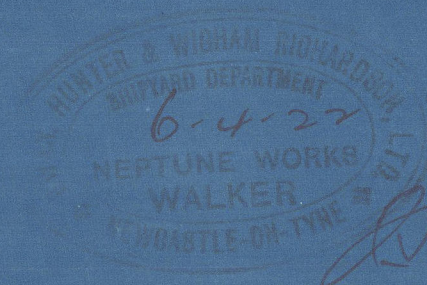

WALKER & WALKER, LTD.
SHIPBUILDERS & ENGINEERS
10, 11, 12, 999, 1000.

Profile & Decks
As built-

Nº 1136

Swan Hunter & Wigham
Richardson & L

Newcastle on Tyne

"BRITISH SCOUT"

NEWCASTLE ON TYNE.

Report No. ~~145050~~
76050.



© 2020

Lloyd's Register
Foundation

002174-002183-0078