

WIDE SHIP SECTION  
1154  
I

WIDE SHIP SECTION  
1154  
I

1380  
1316

WIDE SHIP SECTION  
1154  
I

WIDE SHIP SECTION  
1154  
I

WIDE SHIP SECTION  
1154  
I

# MIDSHIP SECTION. STEEL SCREW TRAWLER. No 1127.

DIMNS: 160' 0" BP x 26' 6" MLD x 15' 0" MLD.  
TO CLASS 100-A1 STEAM TRAWLER.  
SCALE 2 IN = 1 FT.

## NUMERALS.

L x D --- 2400.  
L x (B+D) --- 6640.

## EQUIPMENT.

1<sup>ST</sup> BOWER ANCHOR 9 3/4 CWTs. STOCKLESS.  
2<sup>ND</sup> " " 9 1/4 " " "  
KEDGE ANCHOR 3 3/4 " EX STOCK.  
135 FATHOMS 1 3/16" STUD LINK CABLE.  
60 " 6" HAWSER.  
60 " 5 1/2" WARP.

## RIVETING.


ALL LANDING EDGES TO BE DOUBLE RIVETED,  
EXCEPT TOP EDGE OF SHEERSTRAKE, WHICH IS  
TO BE SINGLE RIVETED.

BUTTS OF GARBOARD & SHEERSTRAKE STRAPPED  
& TREBLE RIVETED FOR 1/2 LENGTH - STRAPPED  
& DOUBLE RIVETED AT ENDS.

BUTTS OF E & F STRAKES OVERLAPPED & TREBLE  
RIVETED FOR 1/2 LENGTH - OVERLAPPED & DOUBLE  
RIVETED AT ENDS.

REMAINDER OF BUTTS OVERLAPPED & DOUBLE  
RIVETED FORE & AFT.

SHELL RIVETS TO BE STEEL. REMAINDER IRON.

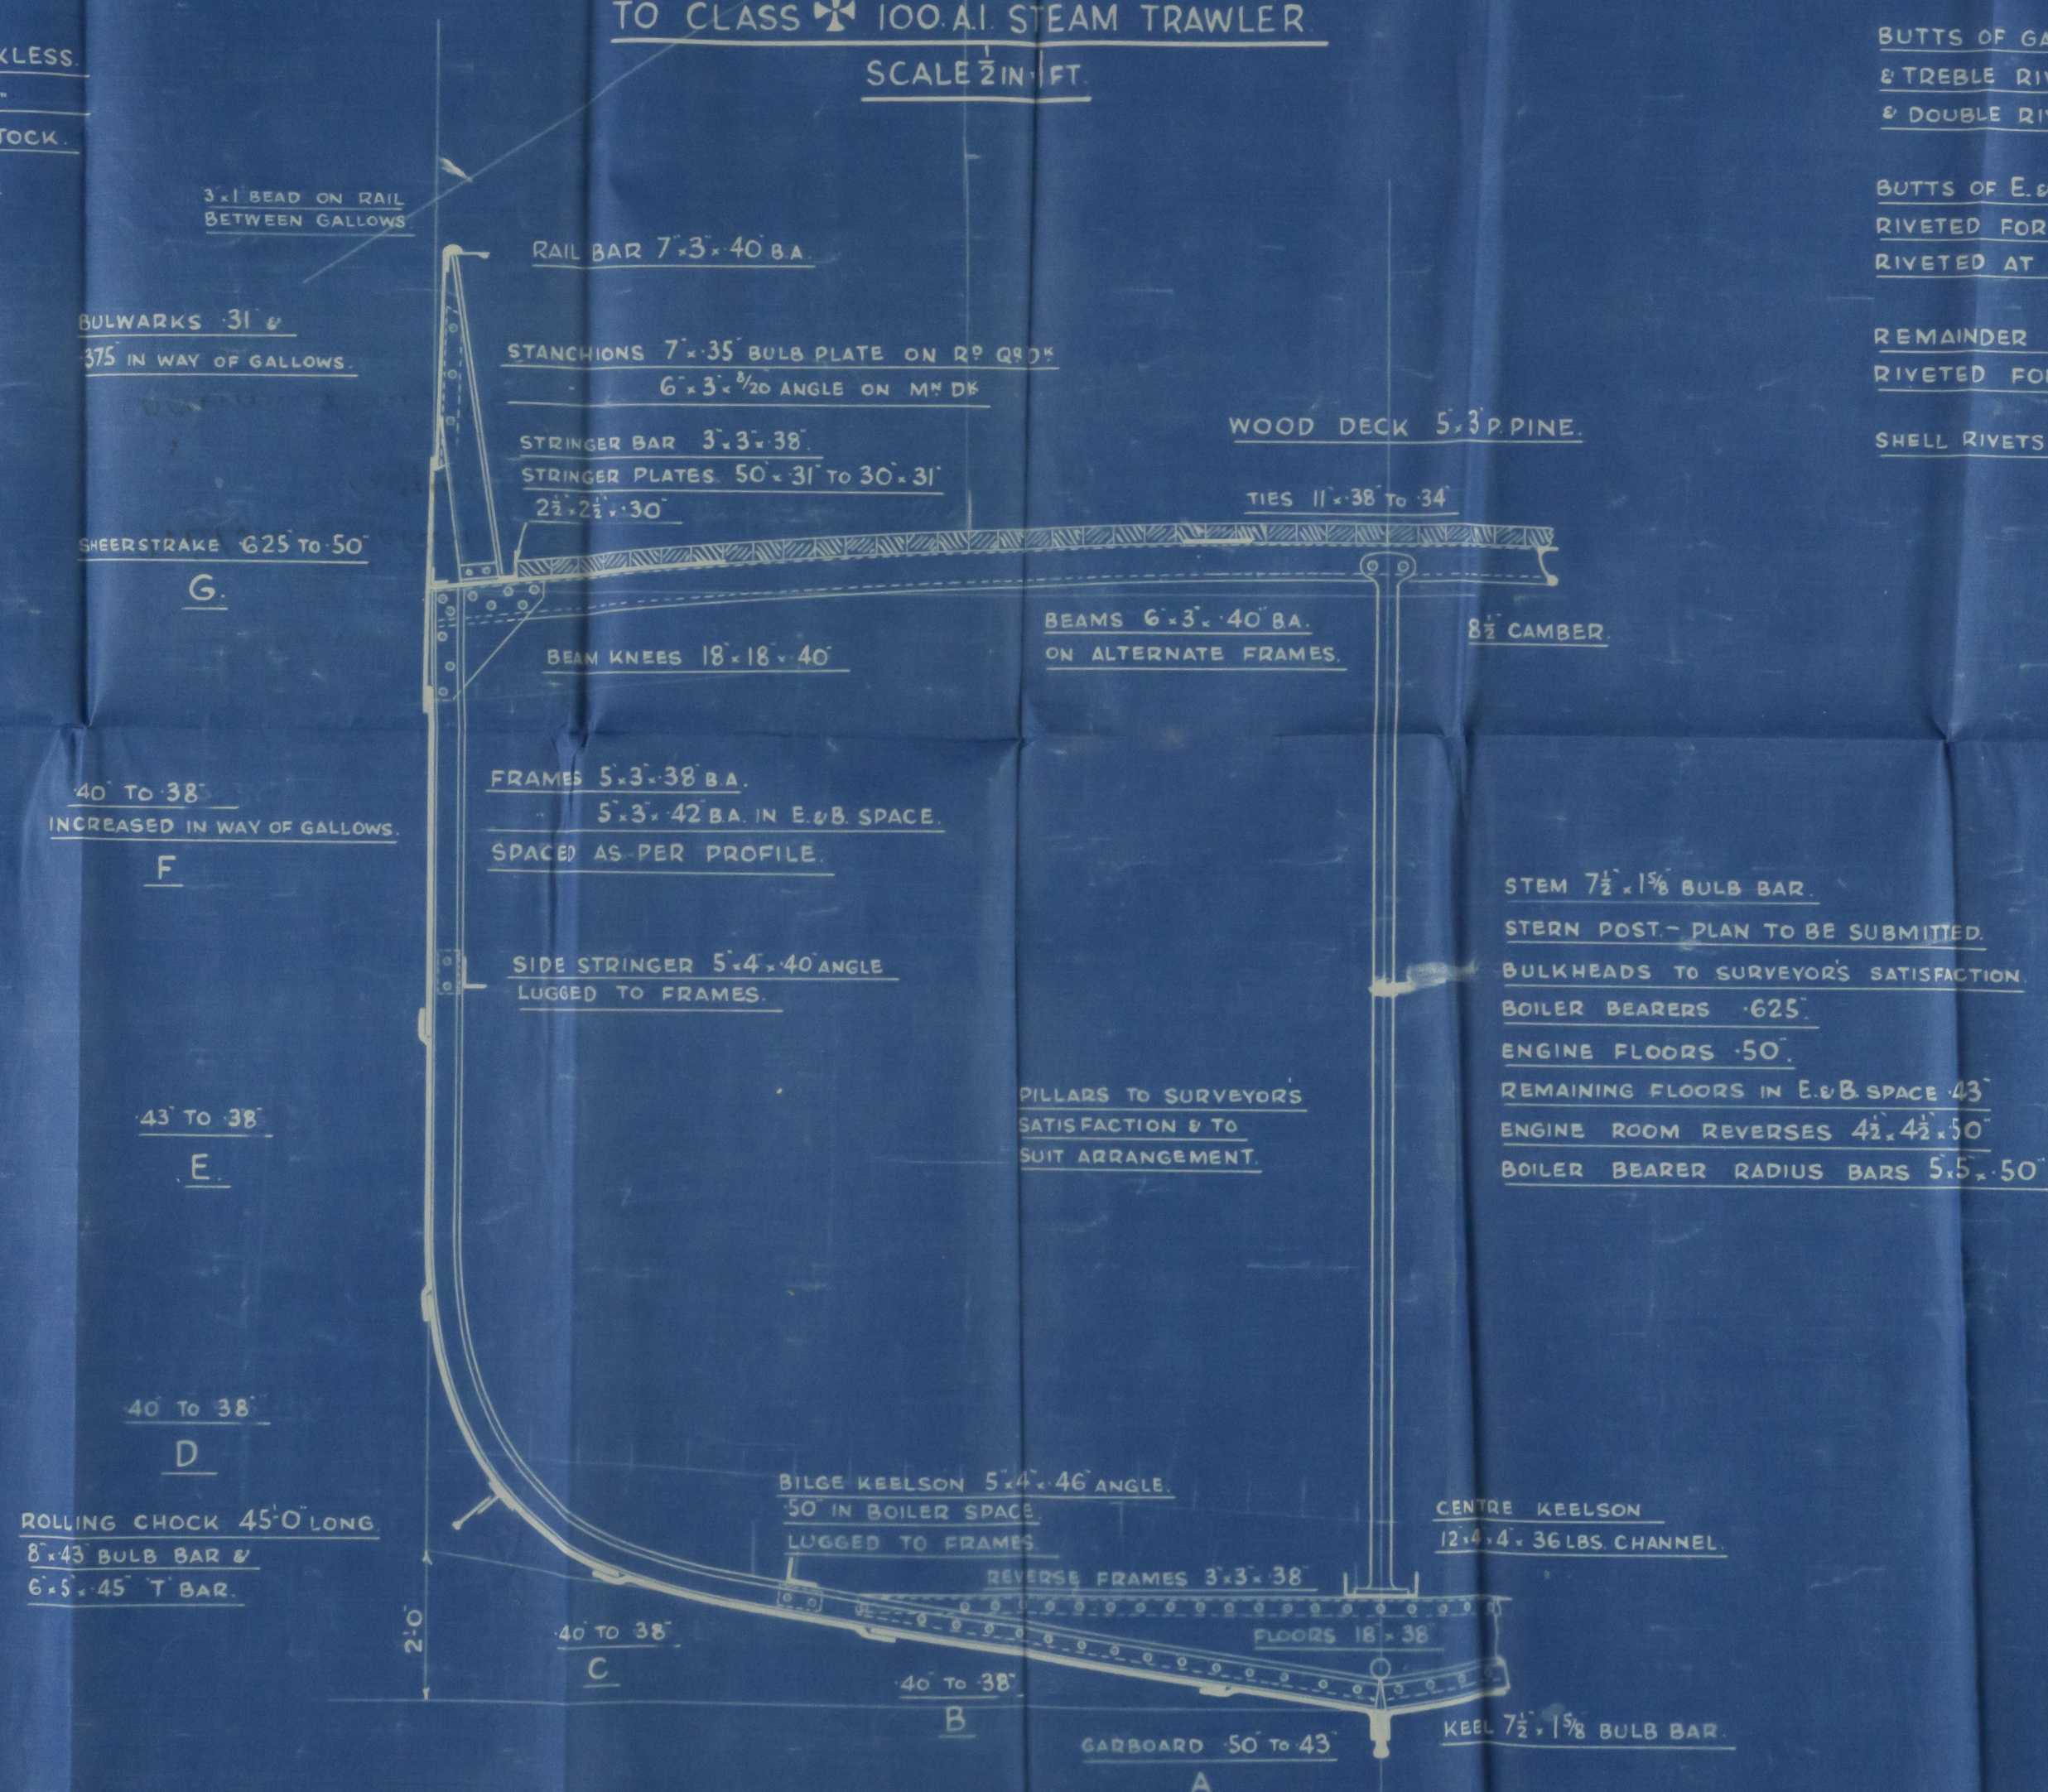



No. 7127  
Midship Section  
 (as built)  
Cochrane & Sons Ltd

PLAN No. 1923  
 FOR ENCLOSURE TO  
 MESSRS. LLOYD'S  
 R.O.S. Hull FROM  
 COCHRANE & SONS, LTD.  
 SHIPBUILDERS, SELBY.  
 DATE 20-10-24

S.S. Cape Barfleur.  
 HULL No. 45237

Midship Section  
 1124

002241-002248-0077



© 2020

Lloyd's Register  
 Foundation