

# MIDSHIP SECTION. S.S. "FRANÇAISE".

BOAT DECK	
BEAMS	4" x 3" x 3/4 ANG.
STRINGER PLATE	21" x 3/4
CURTAIN ANGLE	5" x 4" x 3/8
WOOD DECK	5" x 2 1/2" P.P.

## DIMENSIONS.

LENGTH B.P.	285' 0"
BREADTH EXT.	42' 0"
DEPTH MLD.	20' 0"

CLASS \*100 A1 AT LLOYDS.

SCALE 1/2" = 1 FT

## FORECASTLE DECK

BEAMS	6 1/2" x 3" x 40 BULB ANGLE EVERY FRAME
1 ROW OF PILLARS	2 1/4" DIA SPACED 4' 6" APART
STRINGER PLATE	21" x 3/4 ANGLE 3" x 3" x 3/8
DECK PLATING	.30 SHEATHED WITH 5/16" P.P.
SIDE PLATING	.36 KNEES 16" x 40 4" x 3/4 RIVS



## EQUIPMENT (LETTER S)

2 BOWER ANCHORS	38 1/2 CWTs STOCKLESS
1	32 1/2 " DO.
1 STREAM	10 " EX. STOCK
1 KEDGE	5 " DO.
STUDCHAIN CABLE	240 FMS 1 1/8" DIA.
STREAM CHAIN	75 " 1 1/8" OR 1 1/4" STEEL WIRE
TOWLINE	90 " 4 "
HANSERS	TWO 90 " 2 1/2 "
WARPS	TWO 90 " 2 1/4 "

## LLOYDS NUMERALS.

ERECTOR	POOP	RAISED QUARTER DECK	BRIDGE	FORECASTLE	CASINGS
	134.0	336.0	326.25	132.3	197.56
	1126.11				
LONGITUDINAL N°	17621.55				
EQUIPMENT N°	18747.66				

B = 41.83  
D = 20.00  
L = 285  
17621.55 LONG. N°  
d IN WAY OF UPPER DECK = 17.0  
" " " R° Q° DECK = 18.78

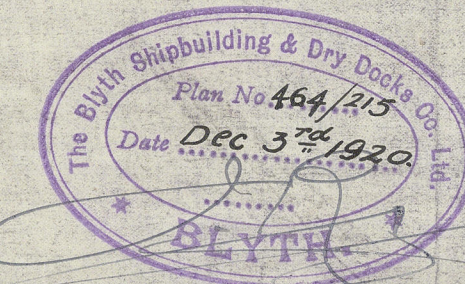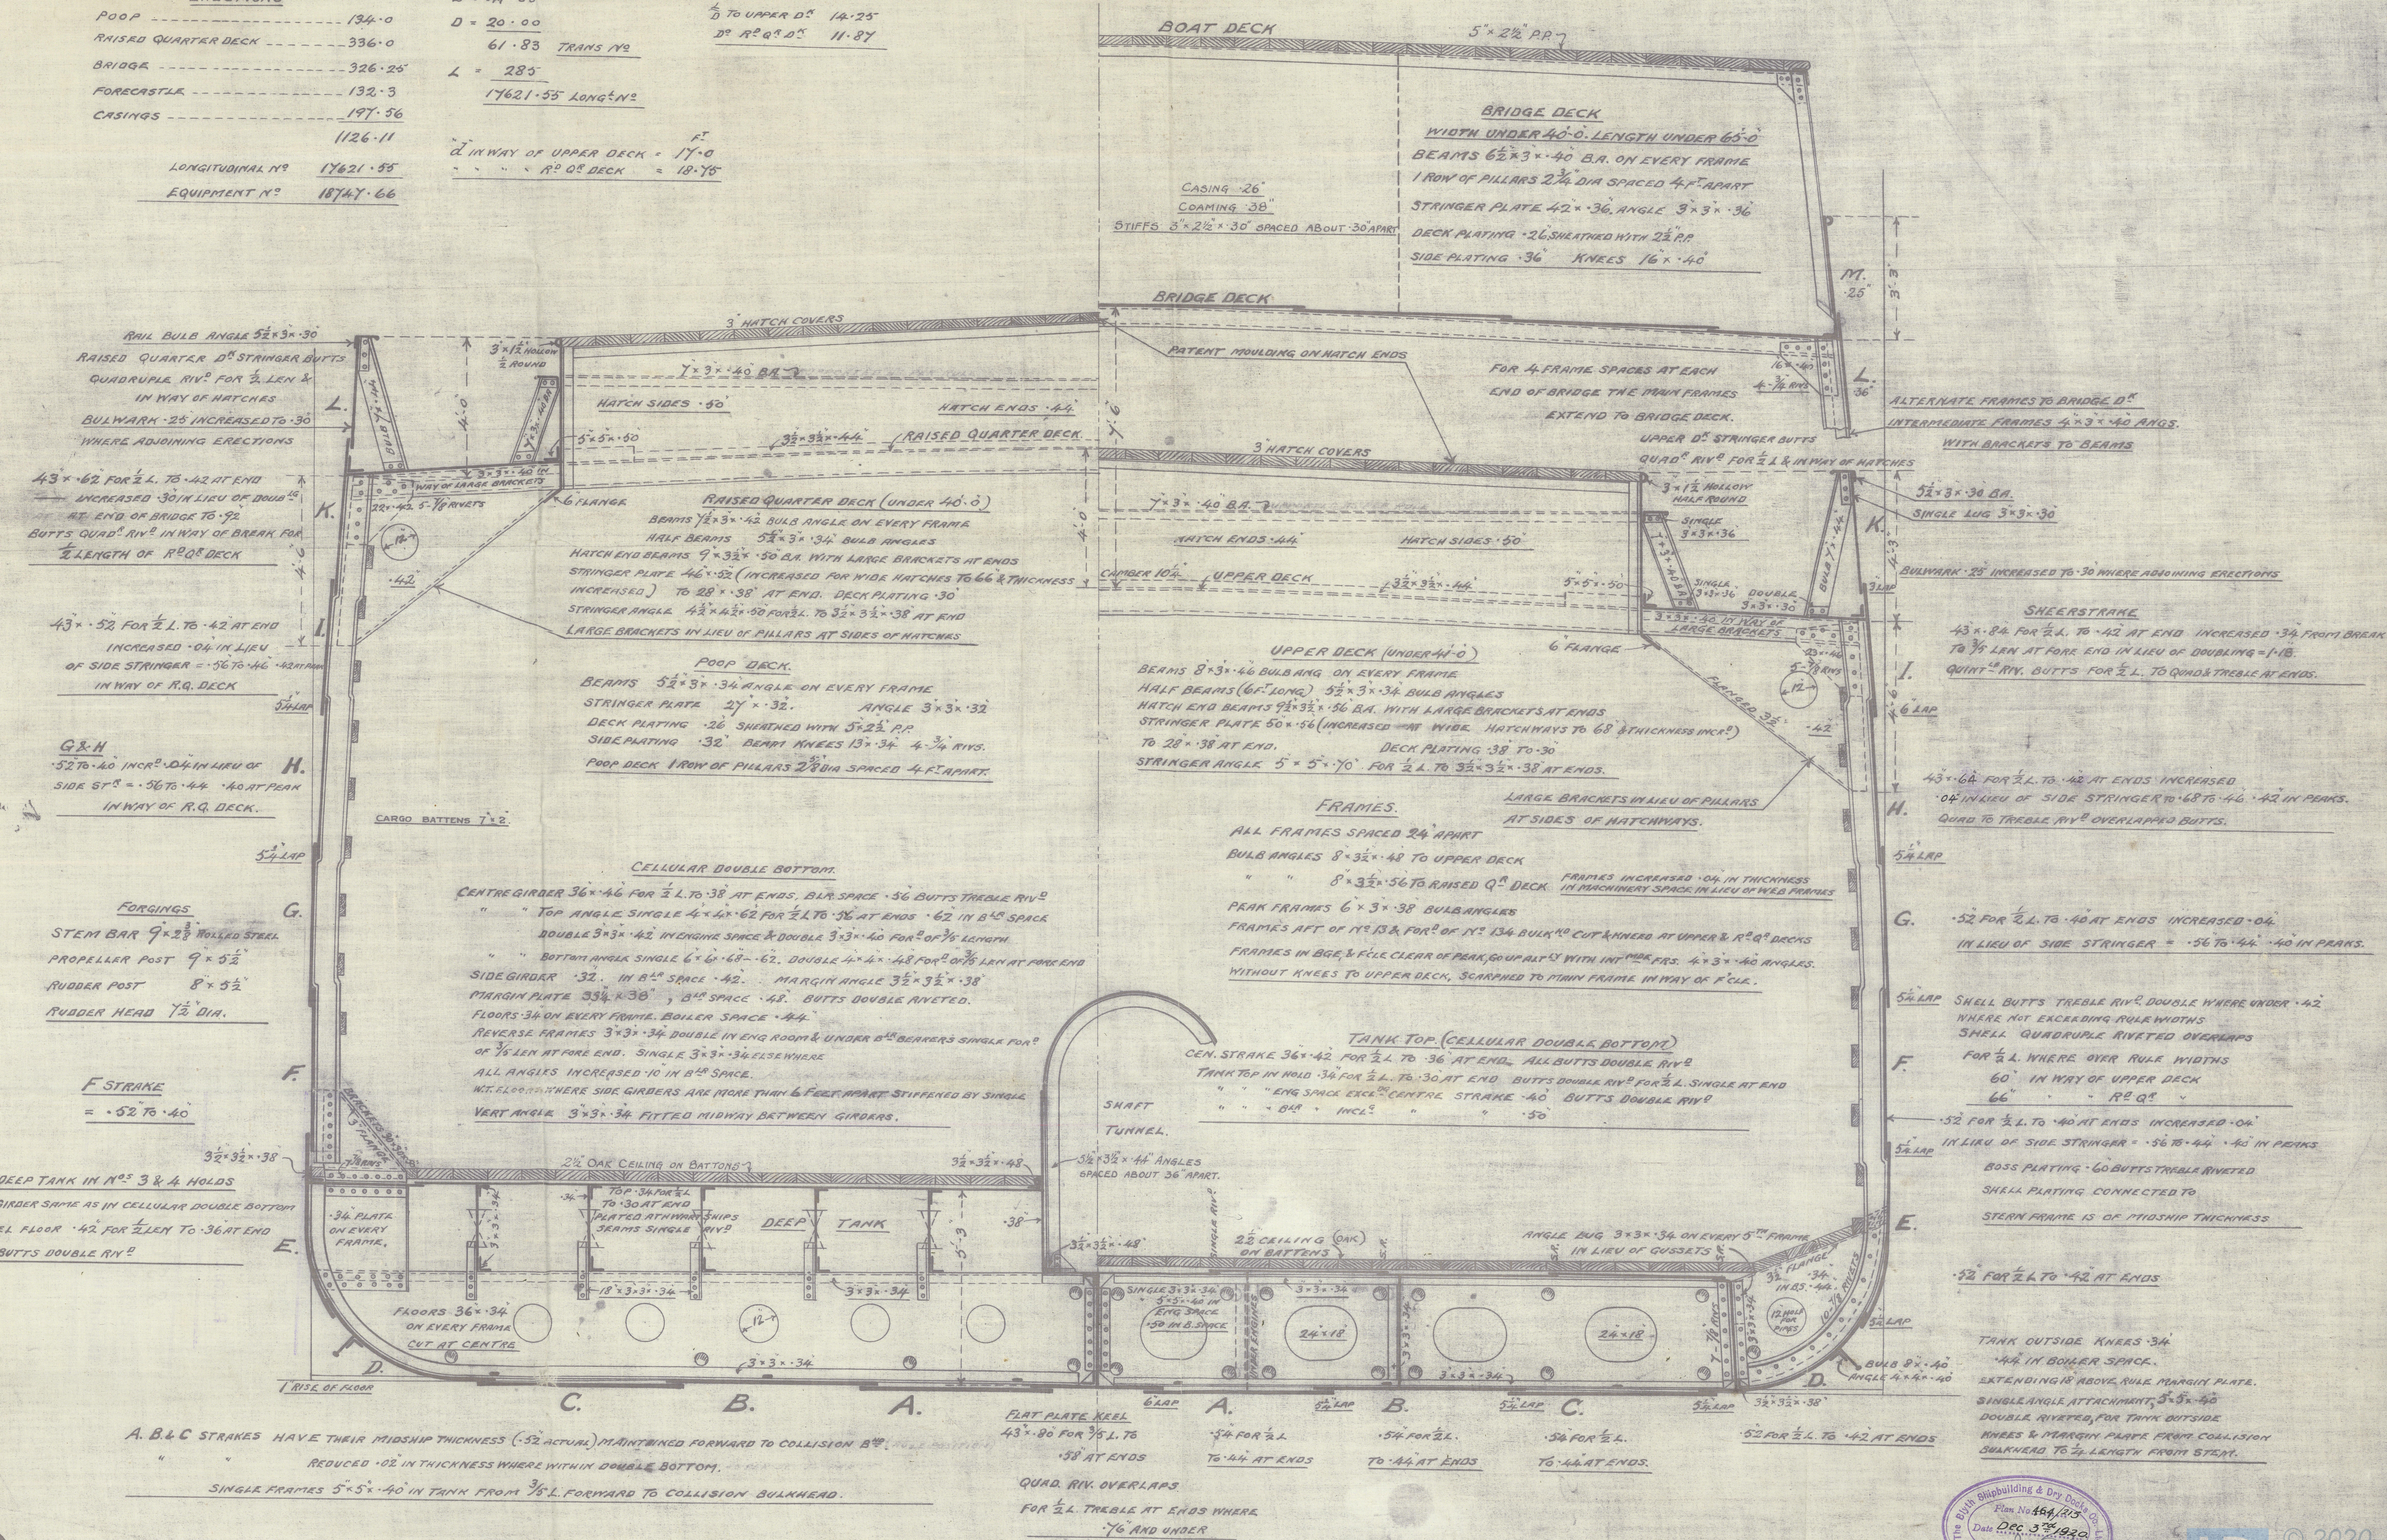



Blyth PB + soc 19

No 215

Missup Linton  
as built.

Meade

S. S. FRANCAISE.

\* NEWCASTLE ON TYNE.

Report No. 43927.

S. S. CAENNAISE

NEWCASTLE ON TYNE.

Report No. 44626.



© 2020

Lloyd's Register  
Foundation

002279-002288-0001