

PROFILE & DECK PLAN


STEEL SCREW TRAWLER

"PERIHELION"

DIMENSIONS 140.0' B.P. x 23.102' M. x 14.0' M.


SCALE 1/4" = 1' FOOT.

PLAN OF BULKHEADS TO BE SUBMITTED

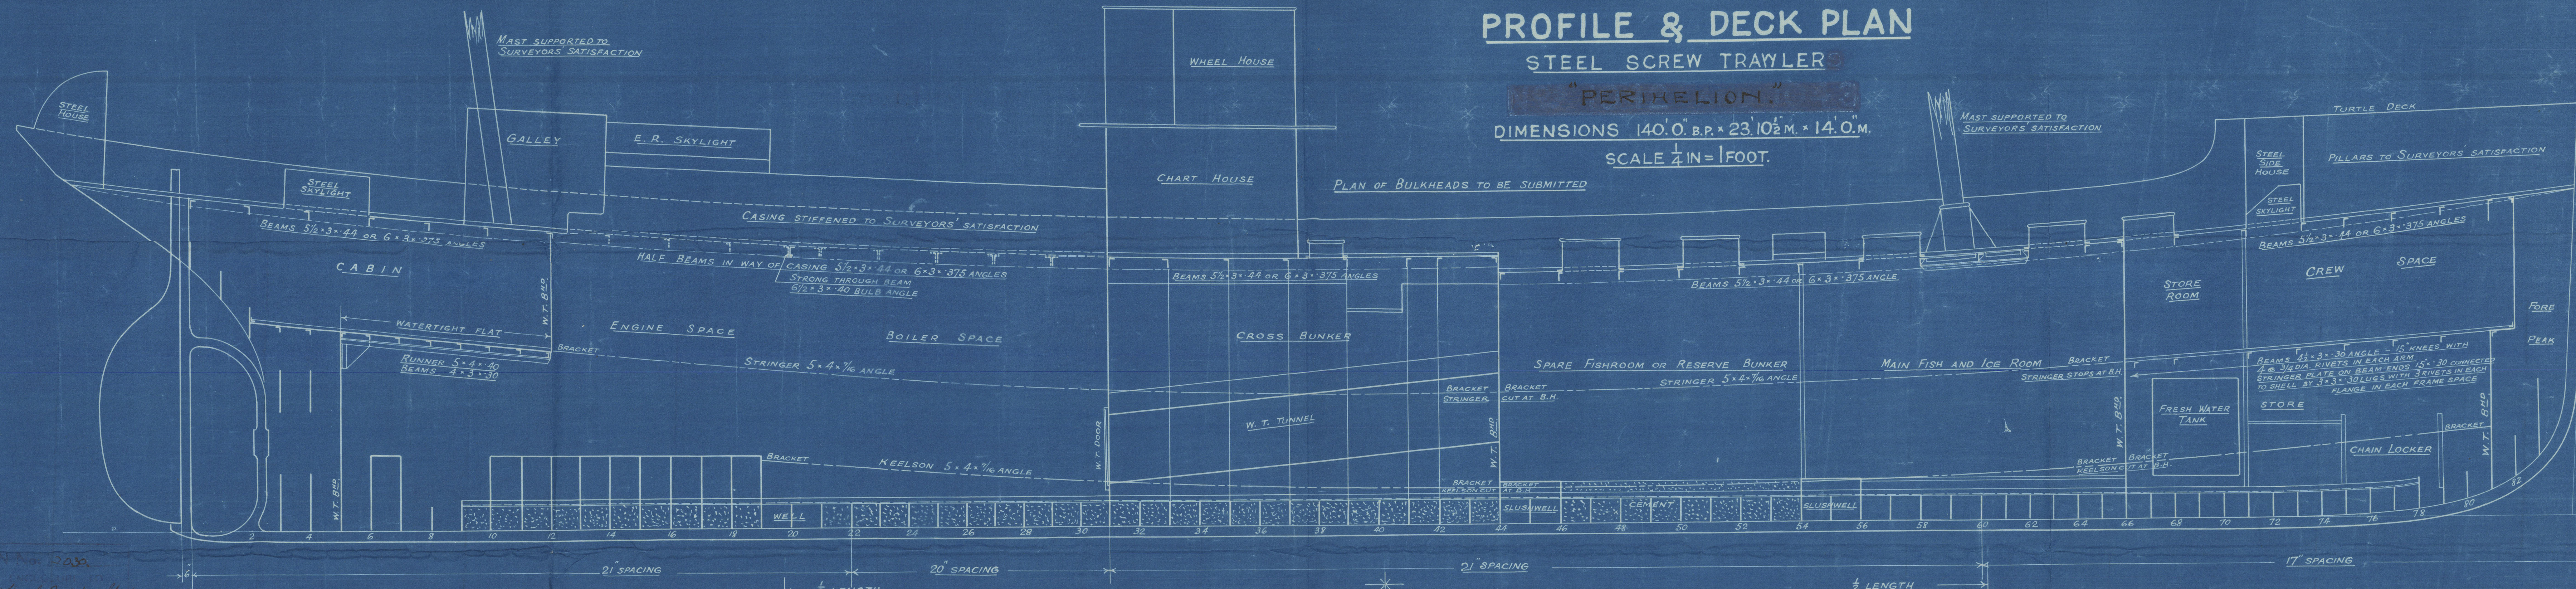


PLAN No. 2030
FOR ENGINEERS TO
HARVEY & CO. LTD. LTD.
HULL

DATE 22-4-29

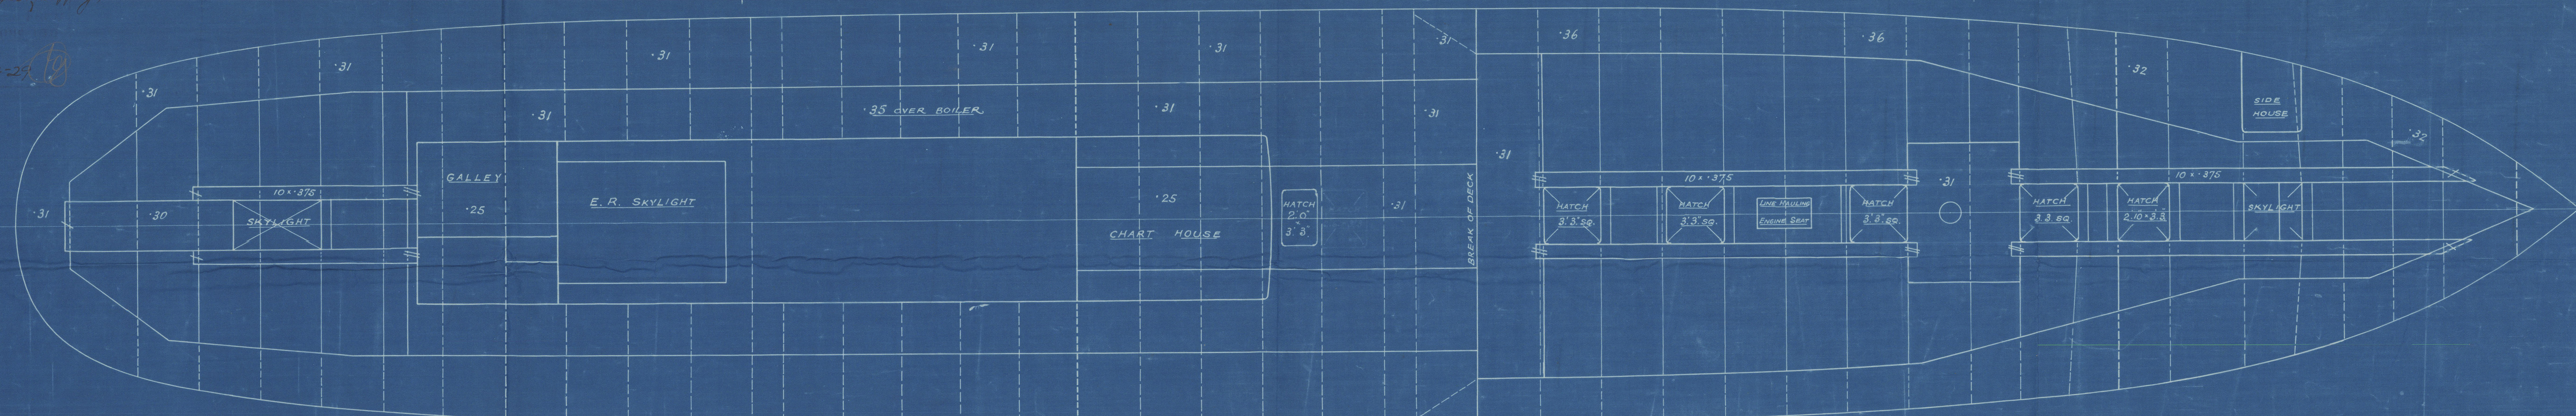

Lloyd's Register Foundation
003298-162804-0182

S/T Perihelion
Messrs. Lloyd's Register of Shipping,
Hull

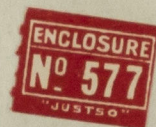

No 1043
Profile & Deck (as built)
Cochrane & Sons Ltd.

S.S.	"Perihelion"
HULL REPORT No.	39818

PATTI X



© 2021

Lloyd's Register
Foundation

002298-002304-0183