


No III.

MIDSHIP SECTION.

To Class 100. A.I. LLOYDS.

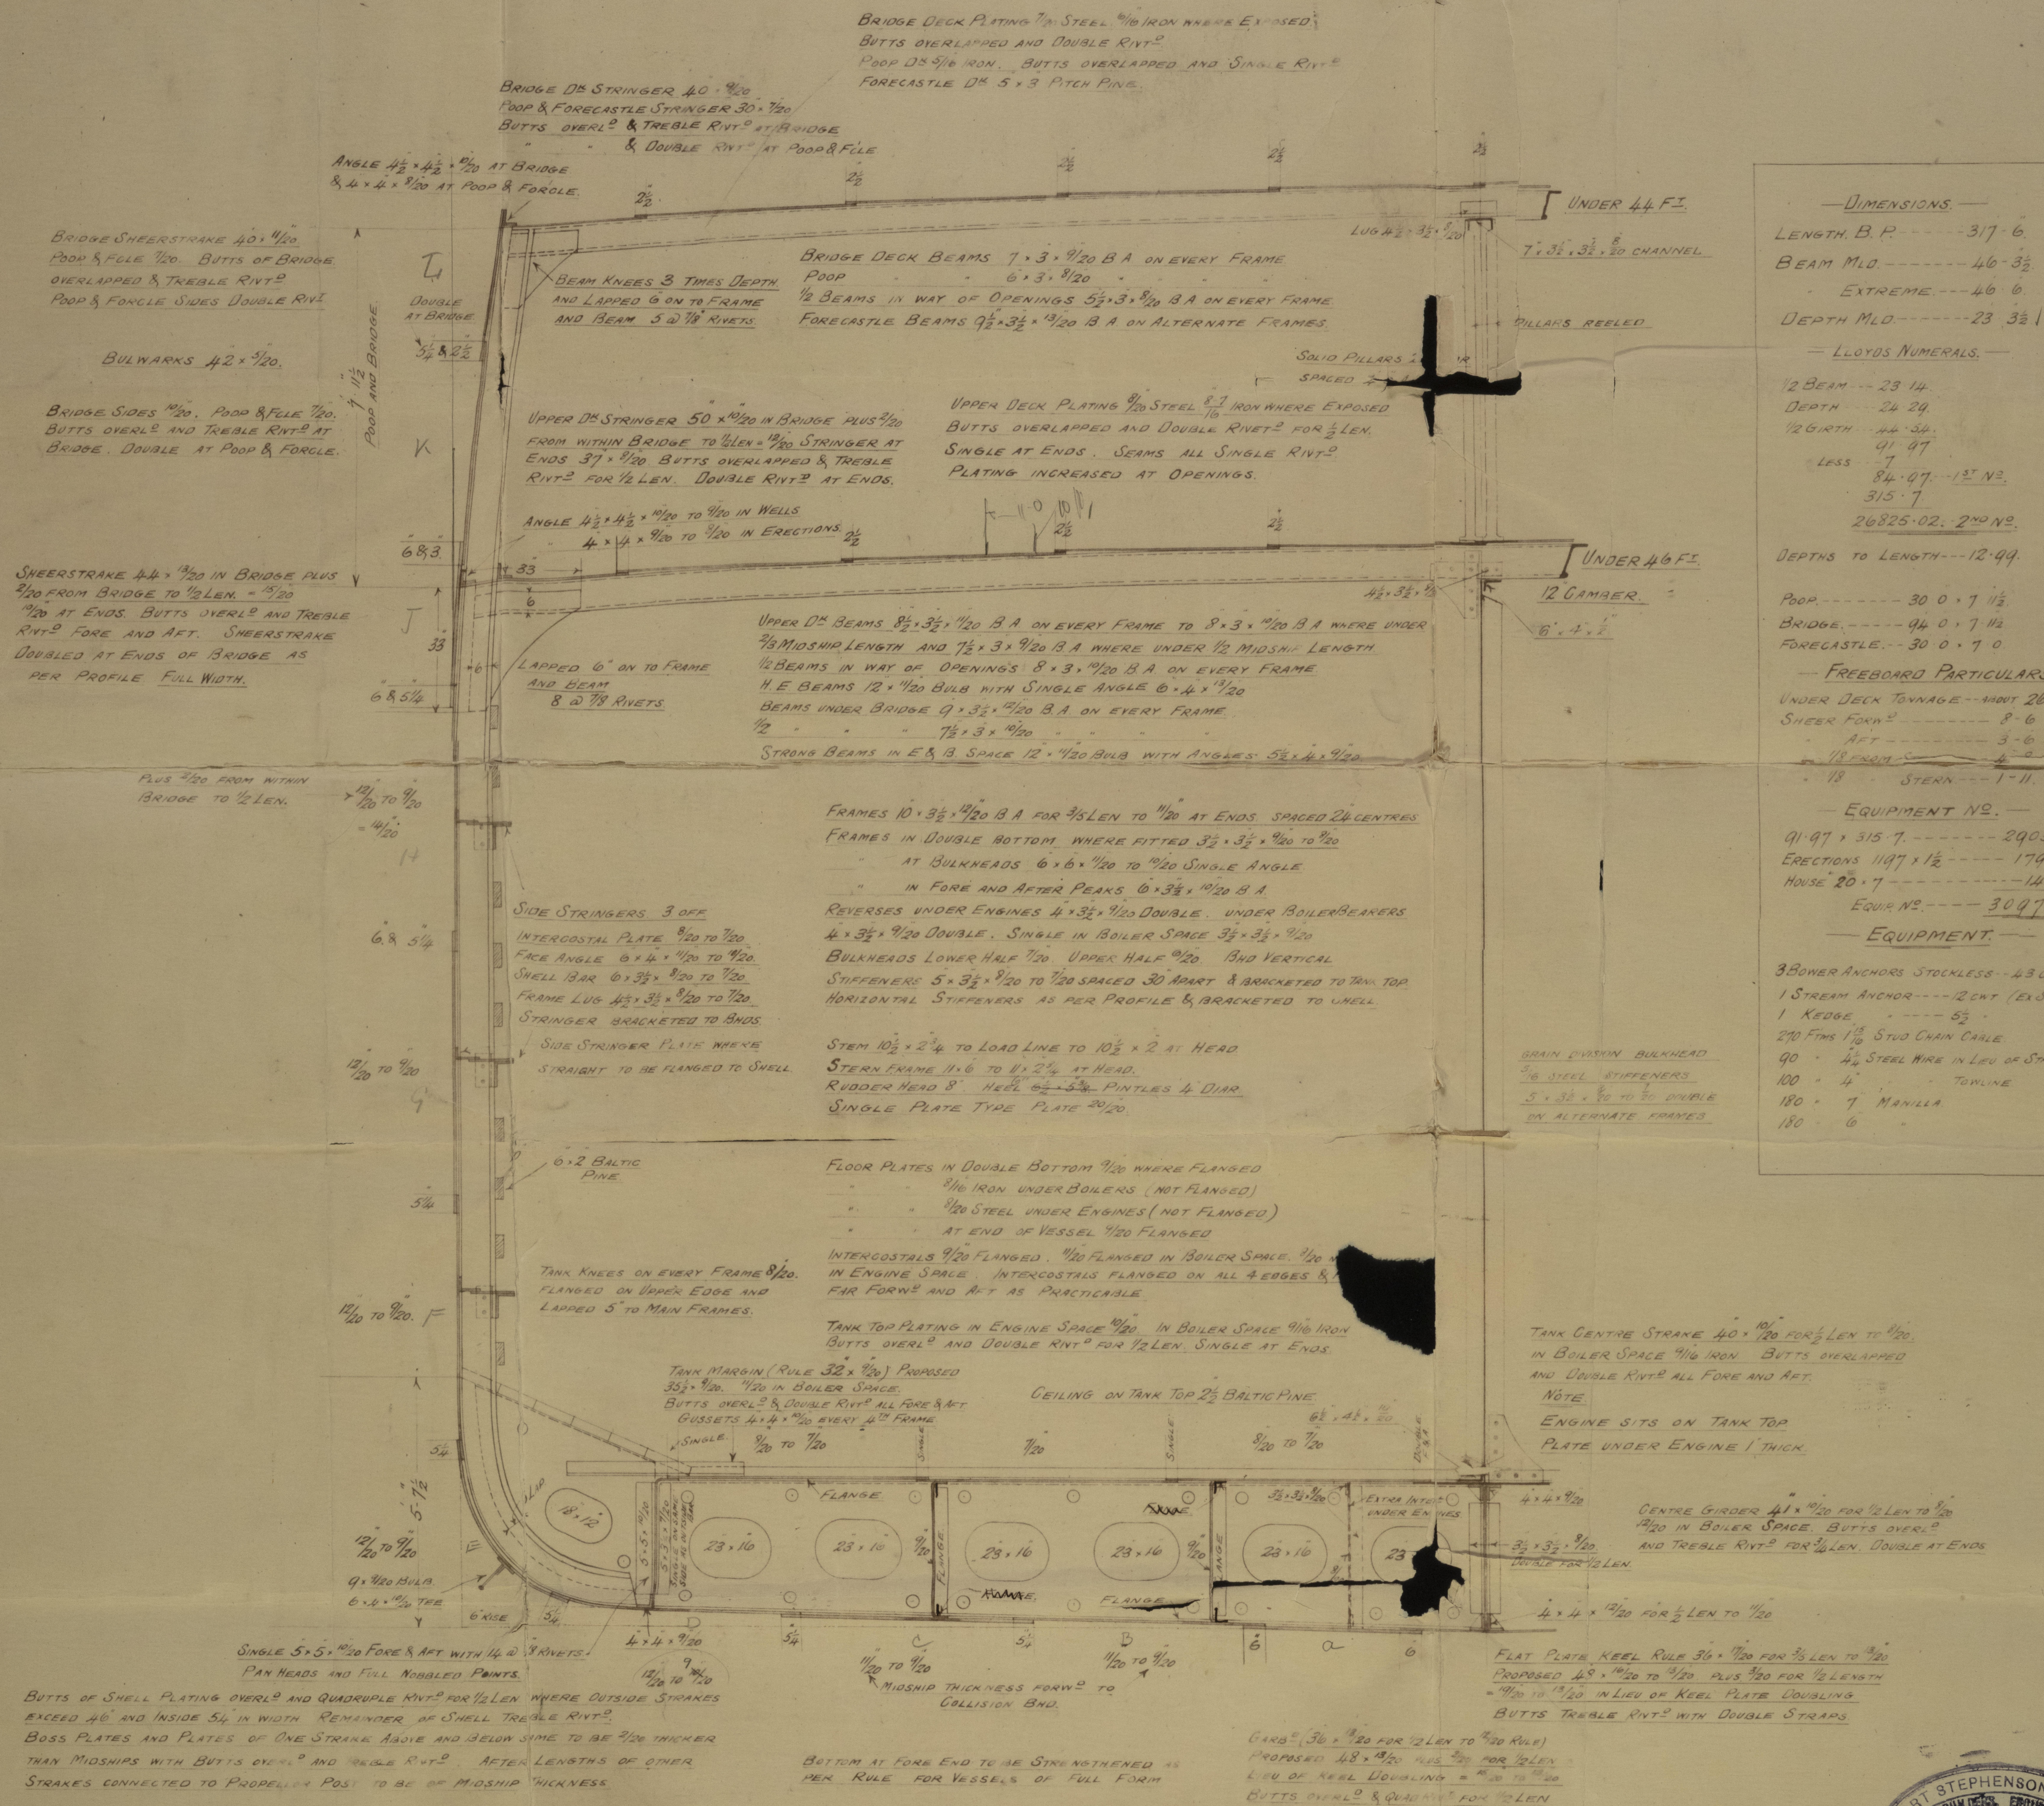

DIMENSIONS.	
LENGTH B.P.	317.6
BEAM MLD.	46.3 1/2
EXTREME	46.0
DEPTH MLD.	23.3 1/2
LLOYDS NUMERALS.	
1/2 BEAM	23.14
DEPTH	24.29
1/2 GIRTH	44.34
	41.07
LESS	7
	84.07 - 1st N3.
	315.7
	26825.02 - 2nd N2.
DEPTHS TO LENGTH - 12.99	
POOP	30.0 x 7 1/2
BRIDGE	94.0 x 7 1/2
FORECASTLE	30.0 x 7.0
FREEBOARD PARTICULARS.	
UNDER DECK TONNAGE - ABOUT 2630 TONS	
SHEER FORM	8-6
AFT	3-6
1/8 FROM	4-6
1/8 STERN	1-11
EQUIPMENT NO.	
91.97 x 315.7	29034.92
ERECTOR 1197 x 1 1/2	1795.50
HOUSE 20.7	140.00
EQUIP NO.	30970.42
EQUIPMENT.	
3 BOWER ANCHORS STOCKLESS - 43 CWT EACH	
1 STREAM ANCHOR - 12 CWT (EX STOCK)	
1 KEDGE - 5 1/2	
270 FTH 1 1/2" STUD CHAIN CABLE	
90 - 4 1/2" STEEL WIRE IN LIEV OF STREAM CHAIN	
100 - 4" TOWLINE	
180 - 7" MANILLA	
180 - 6	



Midship
Section.

No 111

as built—

G.P. "Marina."

Newcastle Report

N^o 52439.

Virginia



© 2020

Lloyd's Register
Foundation

002305-002319-0125