


PROFILE AND DECKS.

PILLARING THROUGHOUT TO SURVEYORS SATISFACTION.
 DIMENSIONS:- 140'-0" B.P. x 24'-0" EXT. x 14'-0" MLD. DEPTH
 SCALE 1/4" = 1 FOOT.

N^o 433 483
 SUBMITTED TO LLOYDS. 16.5.27
 APPROVED BY LLOYDS. 19.5.27
ST MELANTE

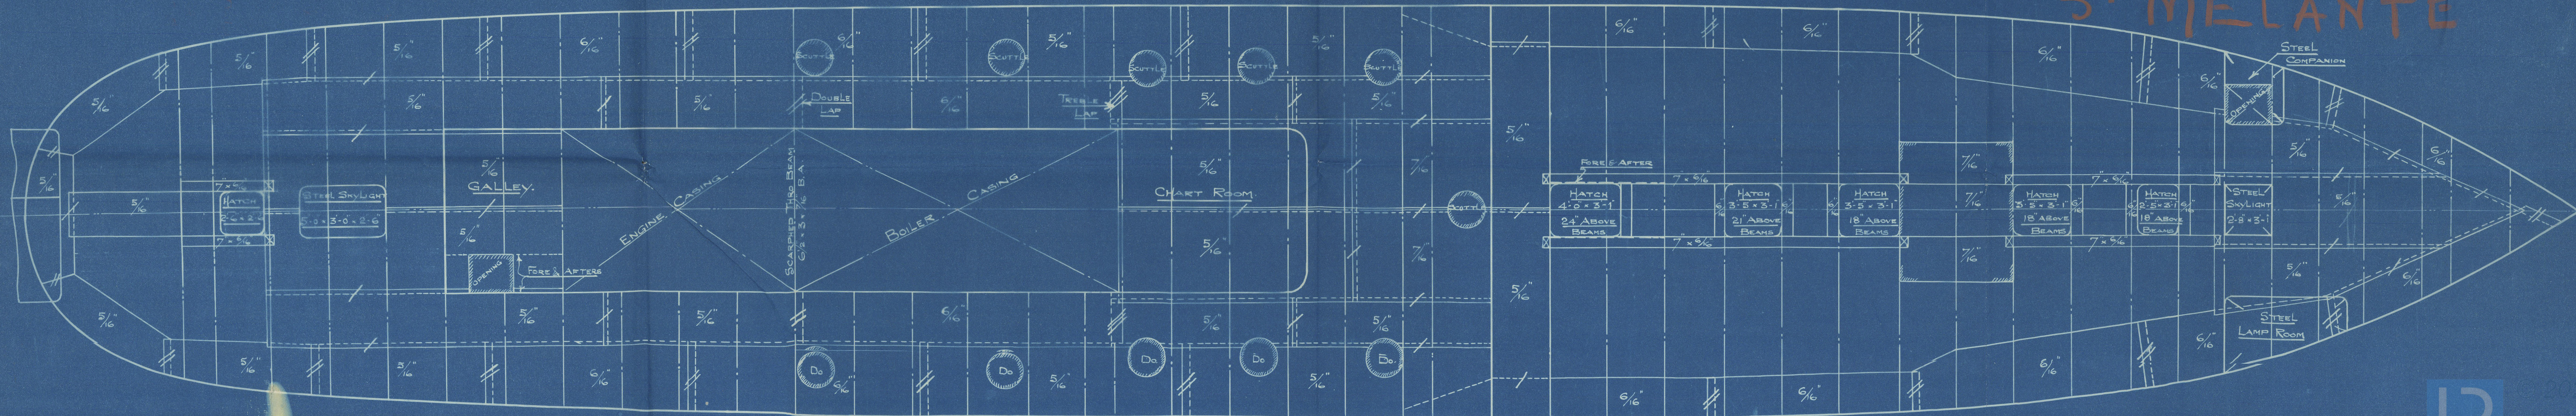

Book Walton & Gemmell

Profile & Oh Plans

As built

ex L 89

" ST MELANTE "

EX
WOMERSLEY X

NN

RAPALLO



© 2020

Lloyd's Register
Foundation

002305-002319-0143