

# EQUIPMENT

1 STOCKLESS ANCHOR 8 1/4 CWT.  
 1 " " 7 1/2 "  
 1 RODGERS " 3 1/4 " EX STOCK  
 120 FATHOMS 1 1/2" STUD LINK CABLE  
 60 " 6" HAWSER.  
 60 " 5" WARP.

# MIDSHIP SECTION

## N<sup>OS</sup> 458 & 9 & 60.

SCALE 1/2" = 1 FT

DIMENSIONS:- 140'-0" BP x 24'-0" EX x 13'-9" MLD


CLASS 100A1 STEEL STEAM TRAWLER

# LLOYDS NUMERALS

L x D	=	1925-00
L x (B+D)	=	5266-80
D	=	13-75
B+D	=	37-62

# PROPORTIONS

L	=	10-18
B	=	6-8
D	=	12-33

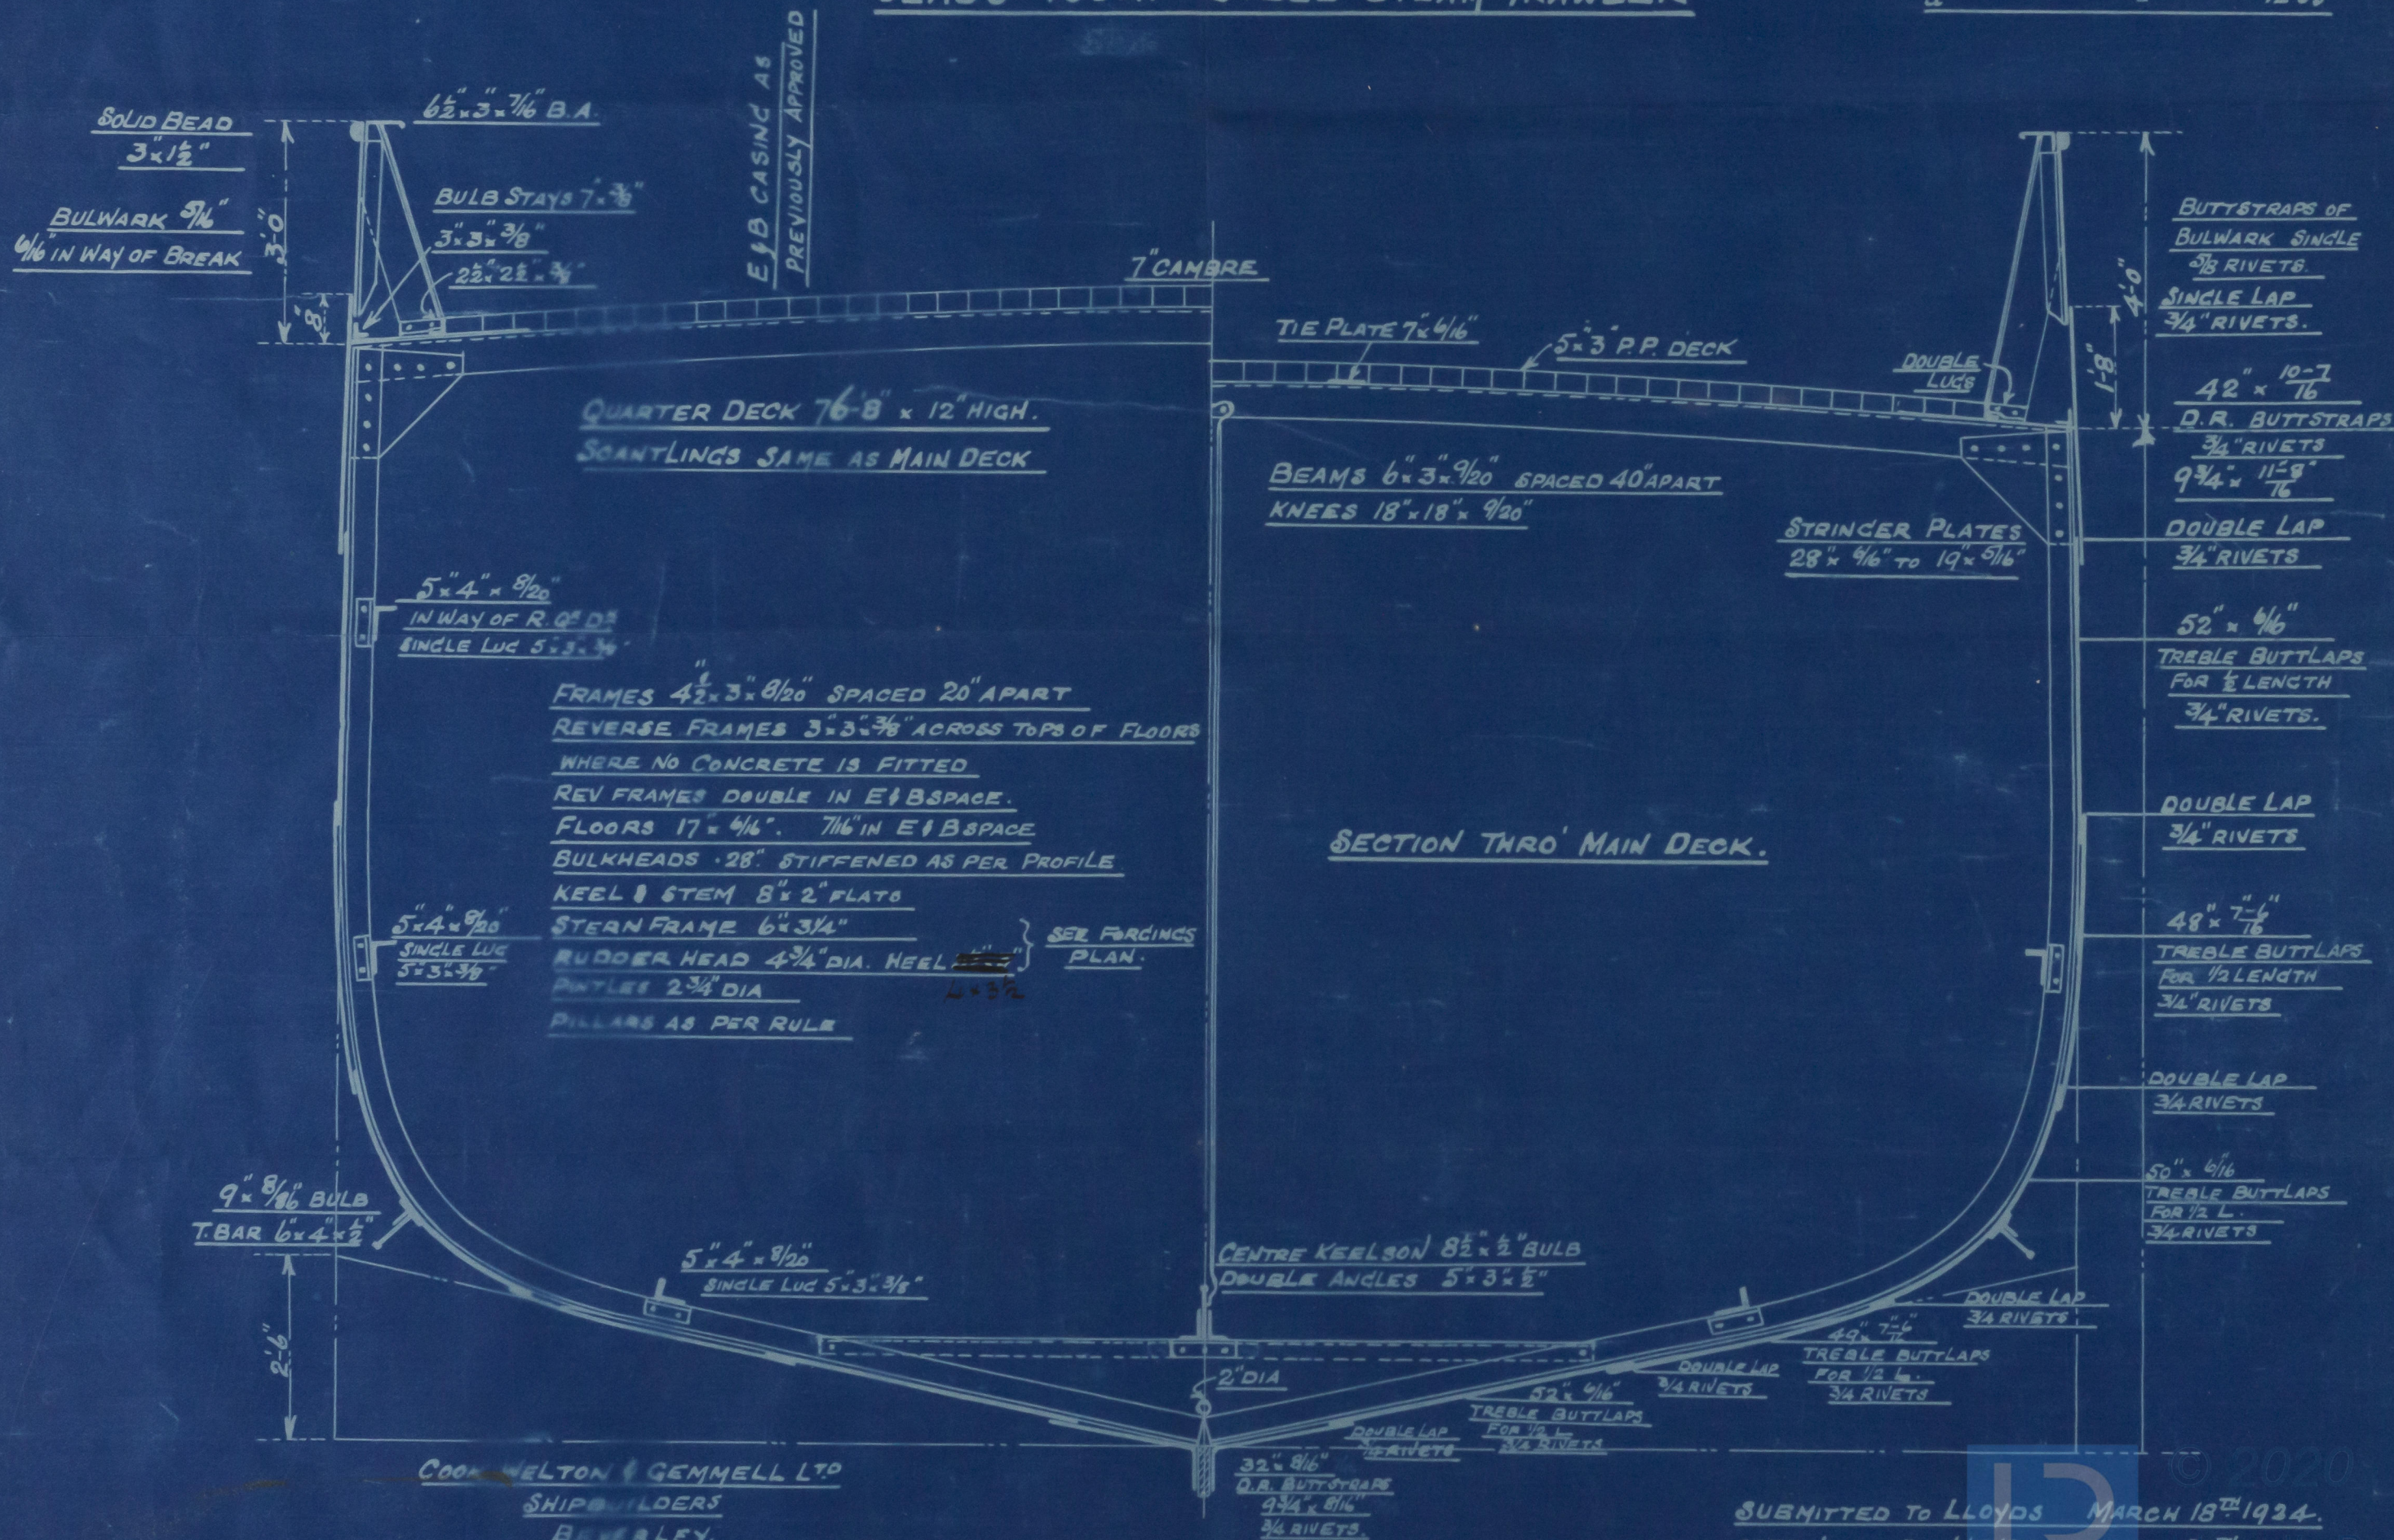

SUBMITTED TO LLOYDS MARCH 18<sup>TH</sup> 1924.  
 APPROVED BY LLOYDS MARCH 24<sup>TH</sup> 1924.



Midships Section  
(As built).

Cook Helton + Gemmell  
N<sup>o</sup> 259

S/T "ST MERRYN"

Hull Rpt No. 35537



© 2020

Lloyd's Register  
Foundation

002330-002339-0061