


SCALE  $\frac{1}{2}$ " = 1 FOOT

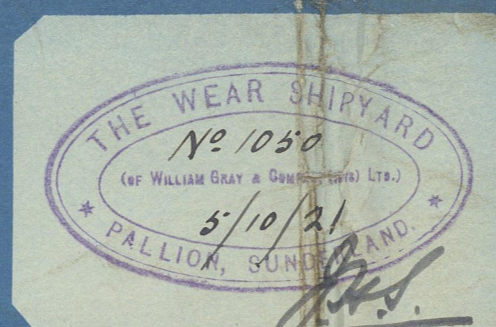

$L_{STRAKE} = 1 \text{ RIVETS}$   
 $M \quad " \quad = 1/8 \quad "$   
 $L_{RM} \quad " \quad = 1/8 \quad "$

DOUBLE STRAKE TRIBLE RIVETS FOR 1/8" OUTSIDE OF BRIDGE TO QUAD TRIBLE LAYERS  
 OR PAINTING OVERLAP  
 63 LAPS FOR 1/8" OUTSIDE OF BRIDGE

SECTION IN WAY OF BOILERS.

Nº 94Z SHIP.

Nº 942 SHIP

SECTION IN WAY OF INTERMEDIATE FLOOR.

SUNDERLAND

THE WEAR SHIPYARD

MIDSHIP SECTION

(AS BUILT)

No 942

S.S. "KARONGA"

SUNDERLAND RPT. No. 28199.



© 2020

Lloyd's Register  
Foundation

002550-002538-0001