

EQUIPMENT N <sup>o</sup>			
L x (B + D)	=	13148	
RAISED QUARTER DECK	144.77' x 4.16'	=	602
FORECASTLE	27.23' x 7.25' x .75	=	148
CASINGS ETC.	51.75' x 7' x .5	=	181
HOUSE	12.75' x 7.25' x .5	=	46
			14125

# S.S. N<sup>o</sup> 1473. MIDSHIP SECTION.

SCALE =  $\frac{1}{2}$ " = 1 FOOT.

DIMENSIONS:- LENGTH B.P. 242'-0", BREADTH MLD. 36'-4", DEPTH MLD. 18'-0" TO UPPER DECK.  
CLASS \* 100 A.I. LLOYDS.

## EQUIPMENT


2 BOWER ANCHORS	30½ CWTs. EACH	STOCKLESS
1 " "	26 " "	" "
1 STREAM " "	7½ " "	EX STOCK
240 FATHOMS	1½" "	STUD CHAIN CABLE
75 " "	3¾" "	STEEL WIRE
90 " "	¾" "	STEEL WIRE TOWLINE
2 @ 90 " "	2¼" "	STEEL WIRE HAWSERS
2 @ 90 " "	1¾" "	" " WARPS

L =	242'-0"
B =	36'-4"
D =	18'-0"
L x D =	4356
L x (B + D)	13148
$\frac{1}{2}$ TO UPPER DECK	13.4
$\frac{1}{2}$ TO R.Q. DECK	10.9
d FOR FRAMING (UPPER DECK)	14.72
d " " (R.Q. DECK)	18.88

d TO UPPER DECK WITH NORMAL  
BEAM KNEE AND NORMAL FRAME KNEE = 15.22

FRAME KNEE ABOVE NORMAL  $12 \div 2 = 14.72$

B.A. SECTIONS ARE 1904 STANDARD  
UNLESS OTHERWISE STATED.

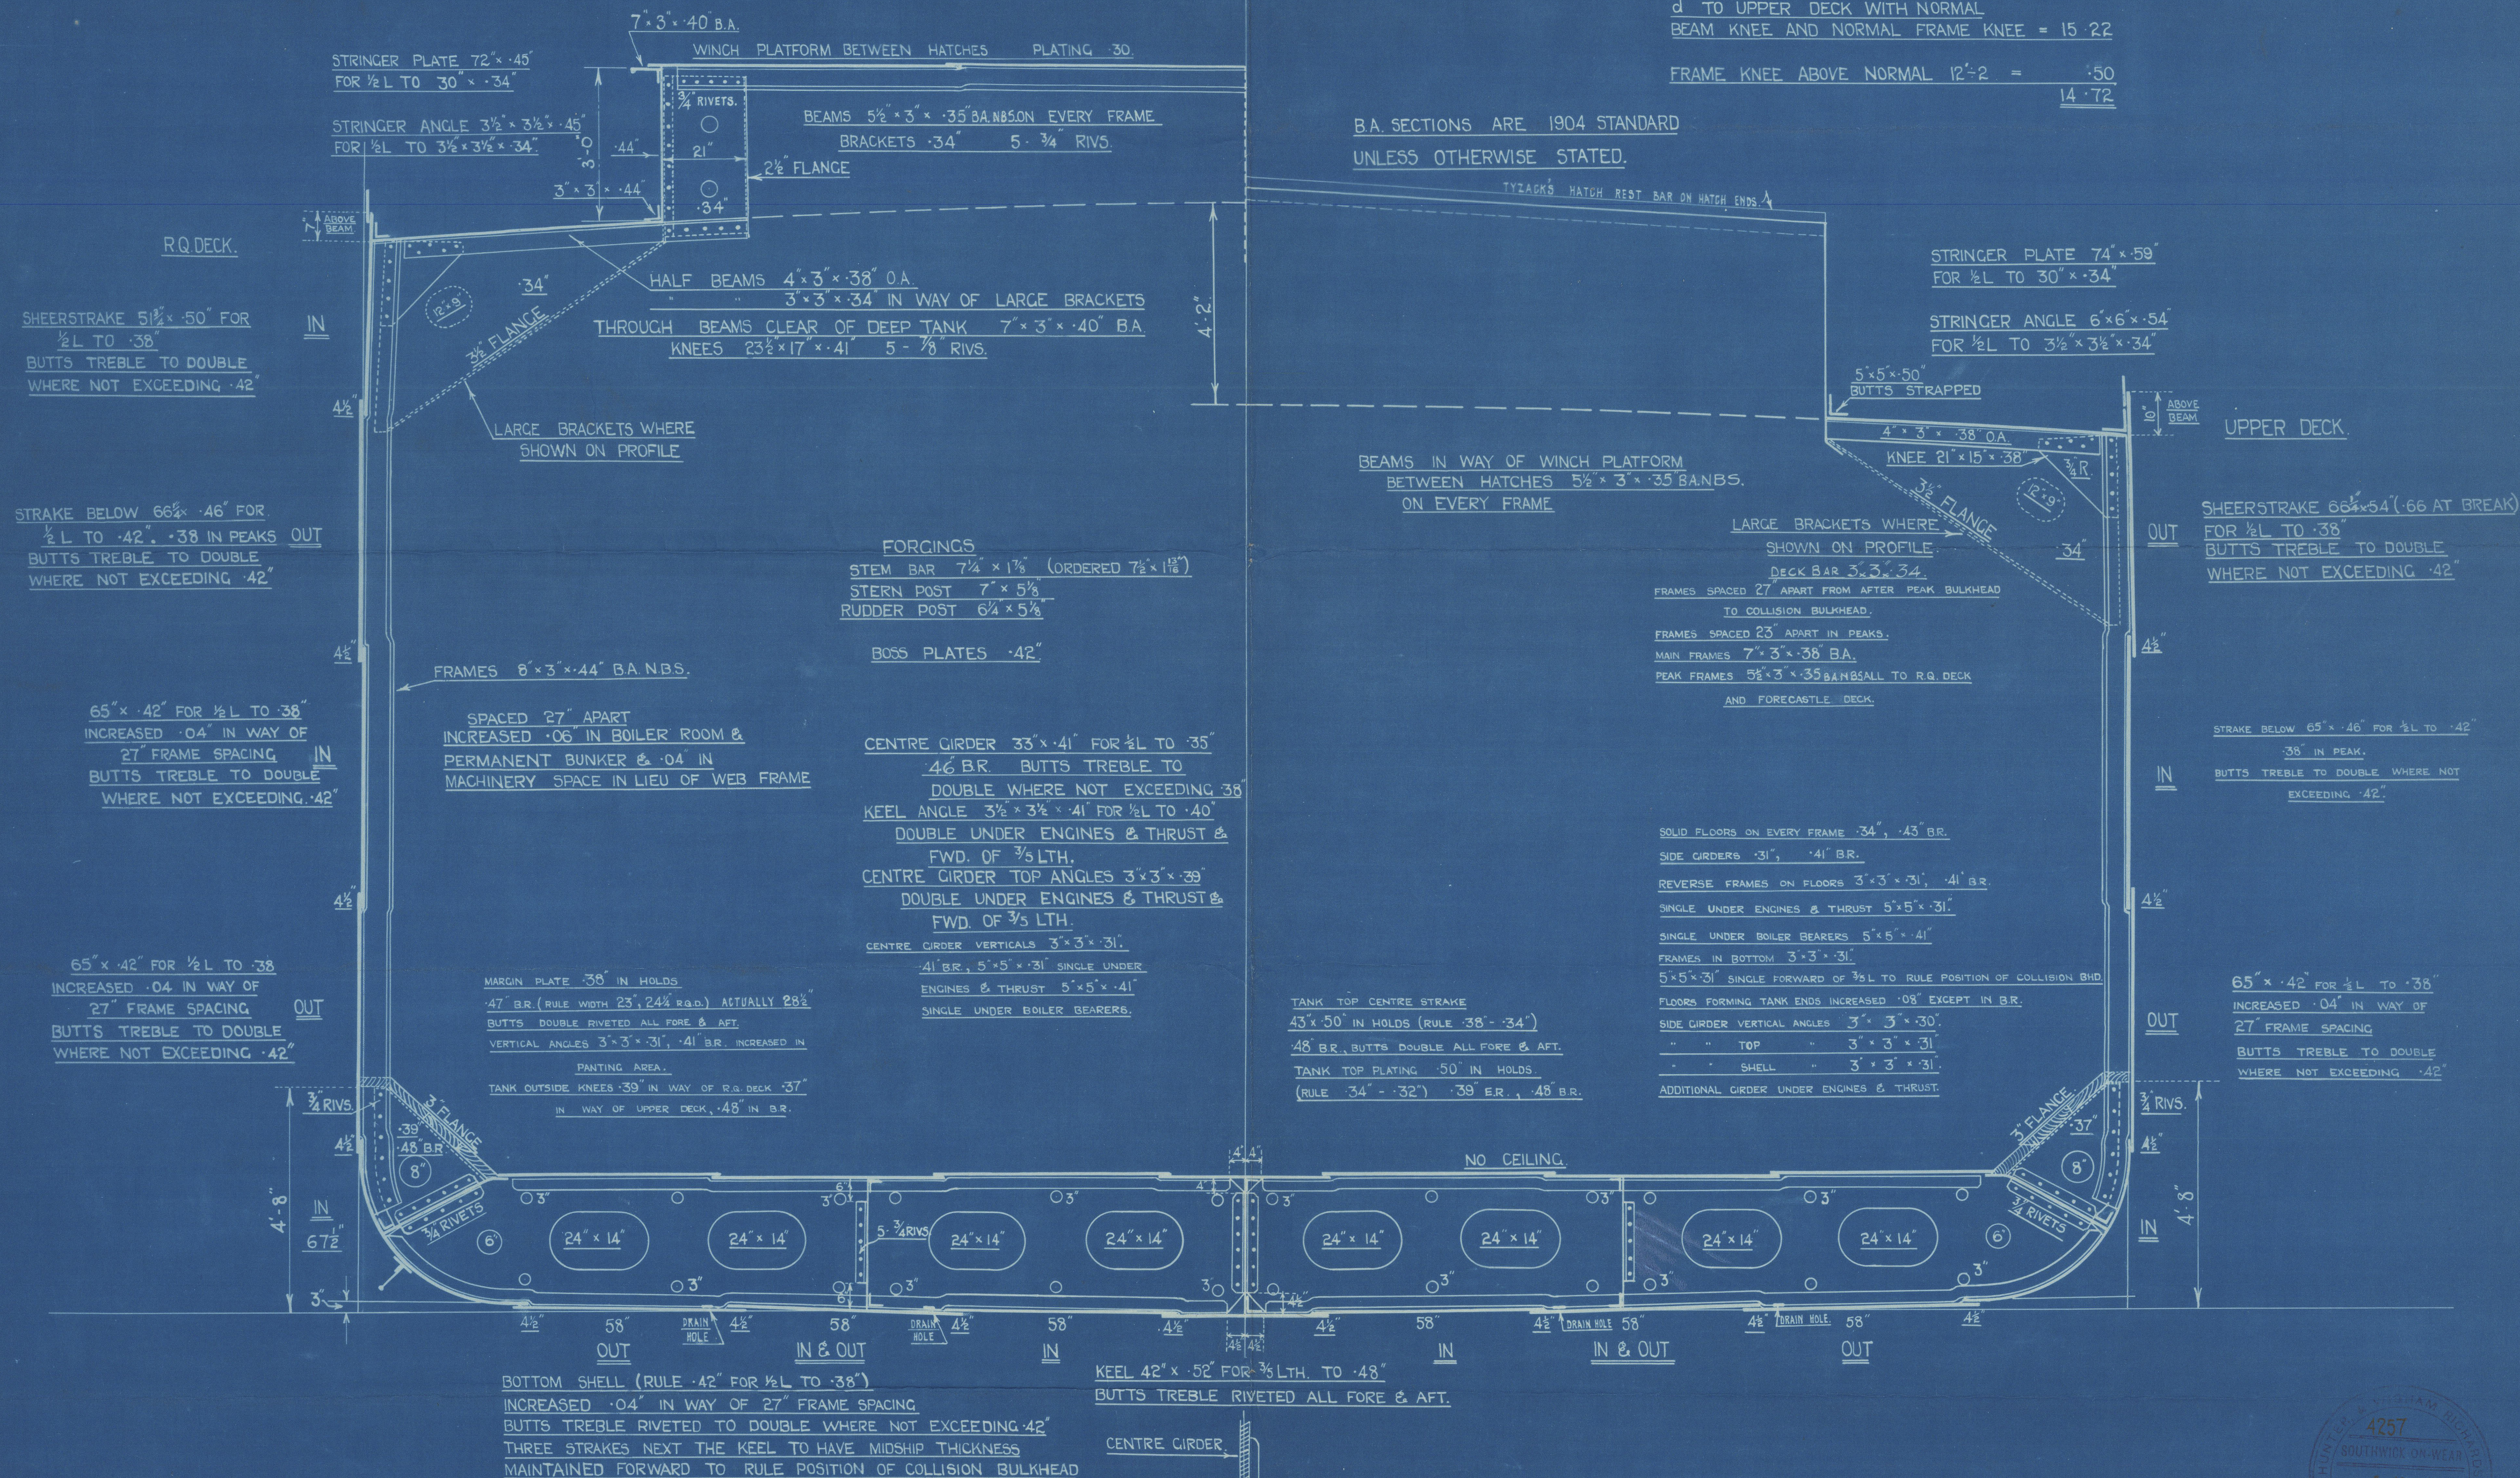



Swan Hunters

No: 1473.

Midship Section

as built.

"Glaithouse"

SUNDERLAND RPT. No. 30449



© 2020

Lloyd's Register  
Foundation

002611-002619-0109