

Kobe Rpt.


No.

8595

SHEET No.

# RESULT OF INSPECTION OR TEST

P	CHINA FIR	Job No.	R-597	Item No.	
Items:	HEEL PINTLE & GUDGEON CONSTRUCTED PLAN AS BUILT.	Date of Inspection	DEC 26 <sup>TH</sup> 1960	Unit	

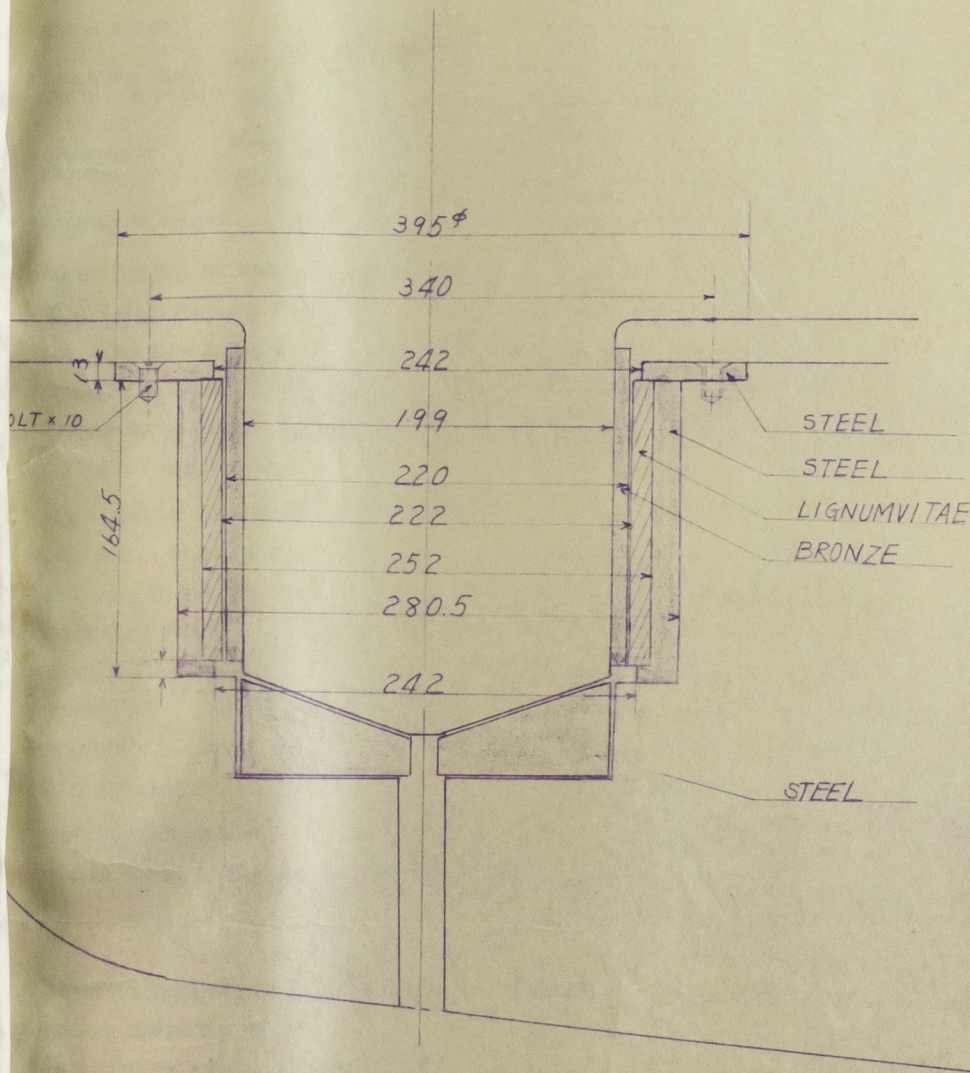

FUJINAGATA Dock Yard Co., Ltd.  
OSAKA

Inspection Dept

002647-002652-0069

30. 10. (50×50)