

DIMENSIONS


TO CLASS 100 A1 AT LLOYDS

SCALE 1/2" = 1FOOT

LONGITUDINAL N°	280 (43°04' + 22.5)	19006.6
TRANSVERSE N°	4304 + 22.5	65°54'
<i>d</i>		19' 8"
DEPTHS TO LENGTH		12.8

POOP	140 62
BRIDGE 54'5" X 75' X 3/4"	306 56
FORECASTLE 25' 75" X 75' X 3/4"	144 84
DECKHOUSES 42' 76" X 7' X 1/2"	192 50
	<u>784 52</u>
LONGITUDINAL N°	19006 60
EQUIPMENT N°	19791 12

2 BOWER ANCHORS	STOCKLESS	38 3/4 CWT EACH
1 - 00 -	- 00 -	32 1/2 - 00 -
1 STREAM ANCHOR	EX STOCK	10 CWT
240 FATHOMS	1 5/8 STUD CHAIN CABLE	
75 - 00 -	4 1/2 STEEL WIRE , STREAM	
90 - 00 -	4 - 00 - - 00 -	TOWLINE
2 - 90 FATHOMS	2 1/2 HANSEY	
2 - 90 - 00 -	2 1/4 - 00 - - 00 -	WARP

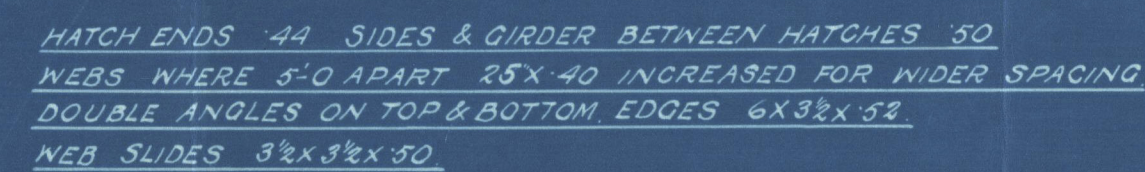

SMITHS DOCK CO LTD
SHIPBUILDERS & ENGINEERS
SOUTH BANK - ON - TEES
ENGLAND.

Smiths Dock Co Ltd

No 781

S.S. "Alacrity"

Midship Section of vessel
as built.

Mdt report No 11907

N.A. "YANIA"



© 2021

Lloyd's Register
Foundation

002690-002700-0154 1/2