
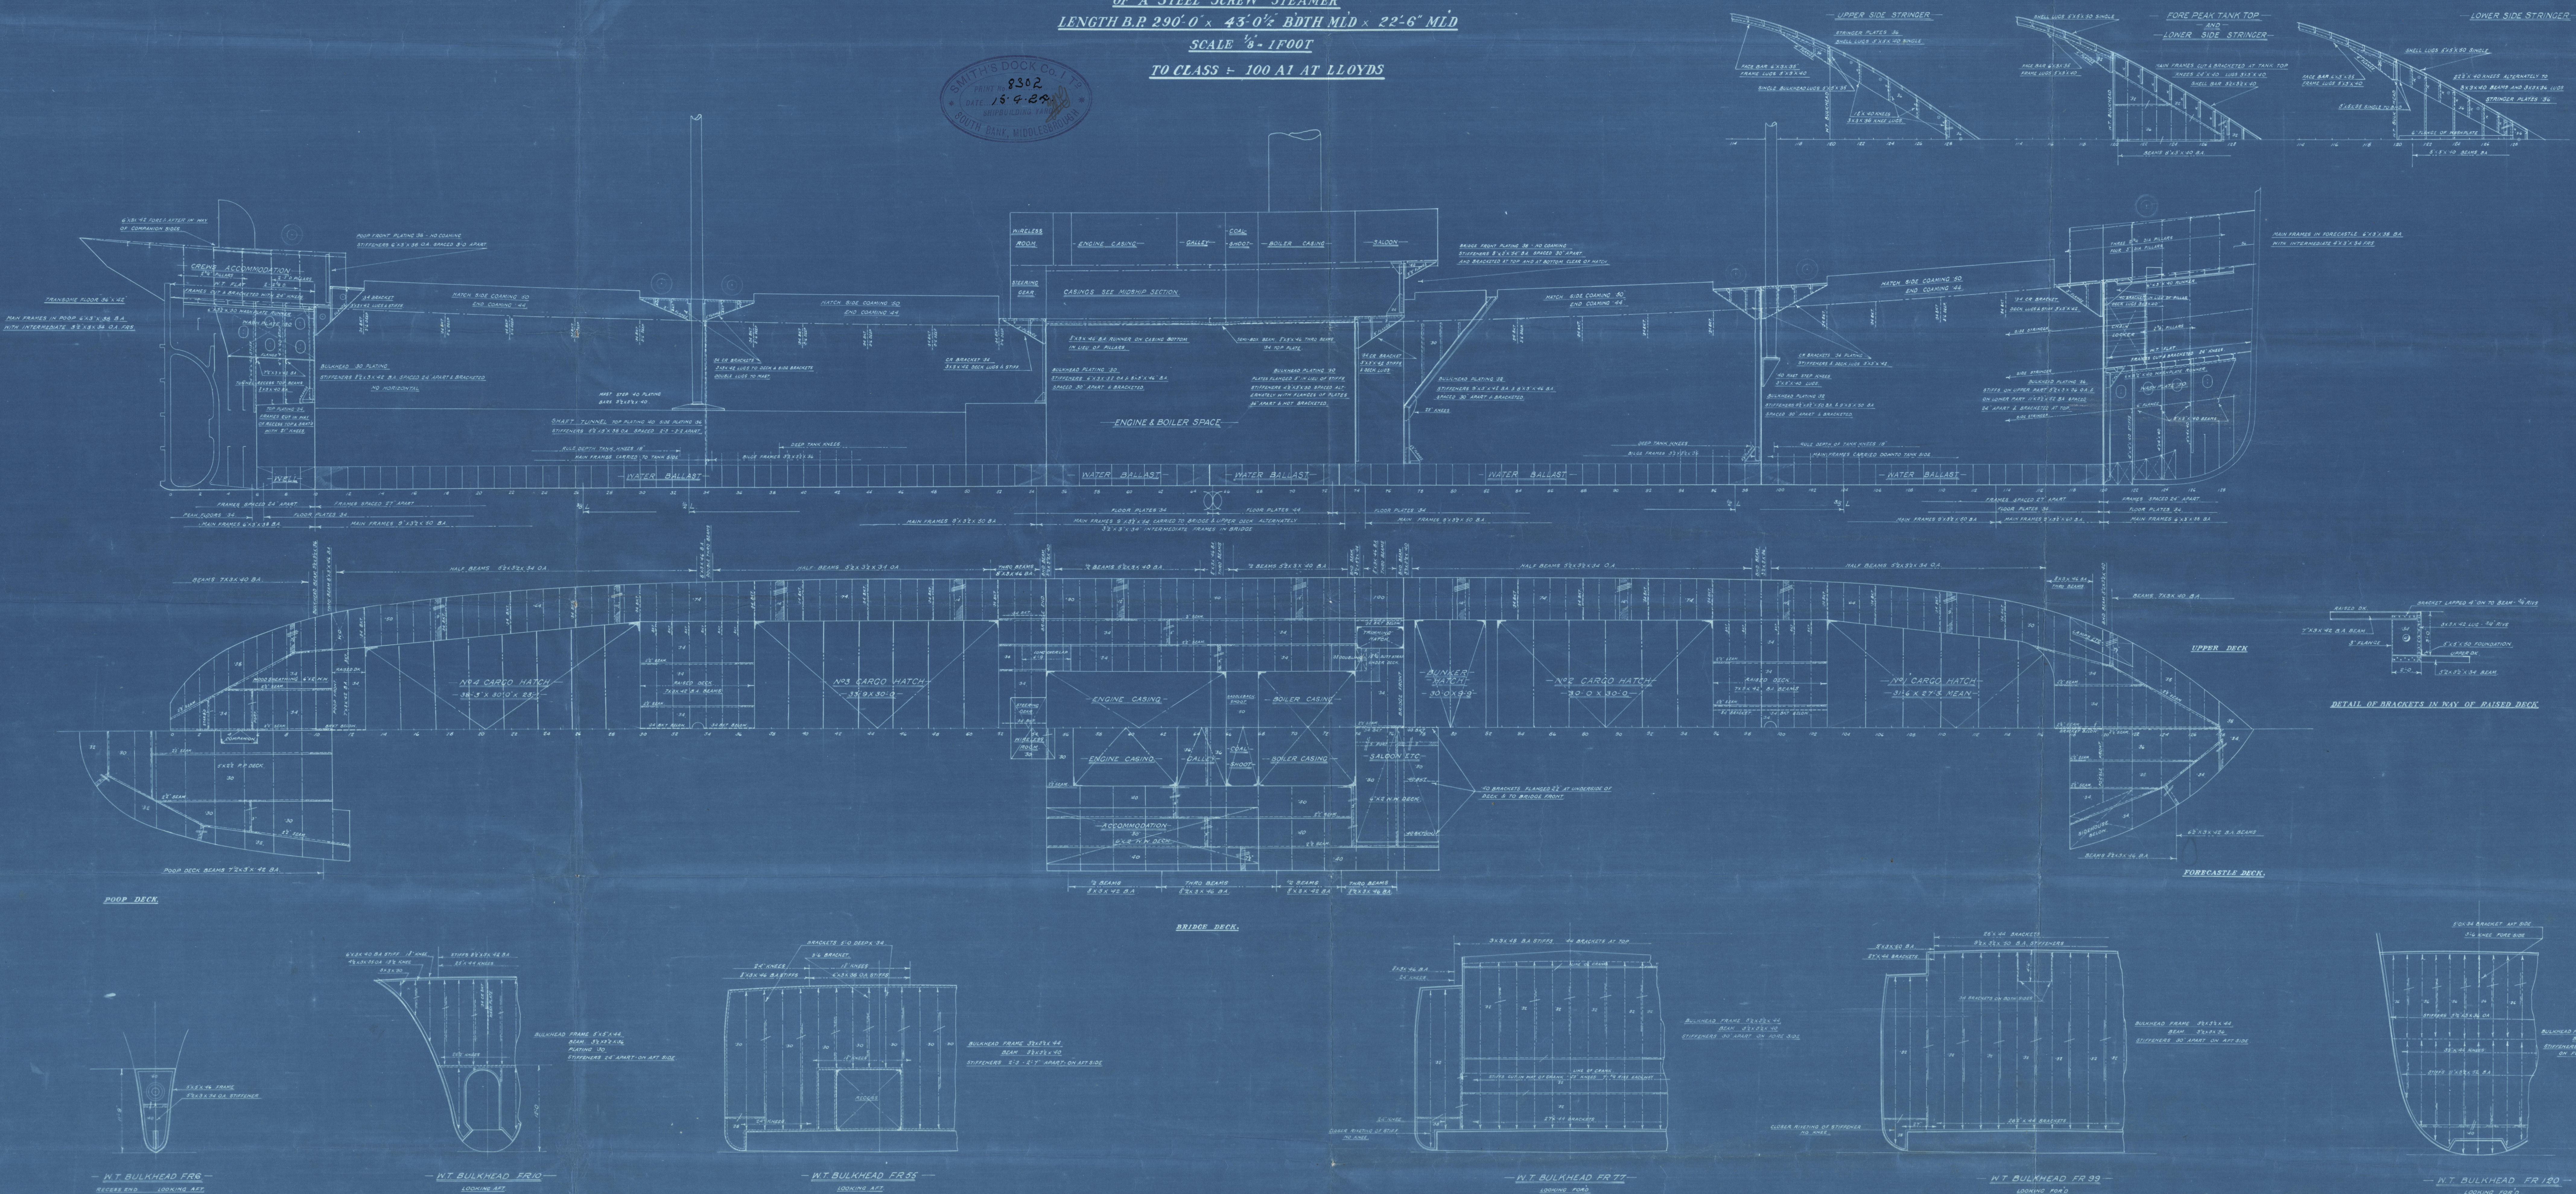


PROFILE AND DECK PLAN

OF A STEEL SCREW STEAMER
LENGTH B.P. 290'-0" x 43'-0" B'DTH MLD x 22'-6" MLD

SCALE 1/8" = 1' FOOT

TO CLASS 100 A1 AT LLOYDS

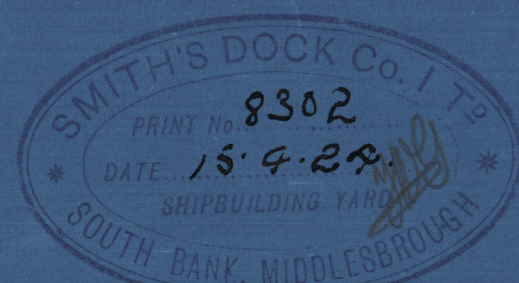

SMITHS DOCK CO LTD.
SHIPBUILDERS & ENGINEERS.
SOUTH BANK ON TEES,
ENGLAND.

Smiths Dock Co. Ltd.

No 781 Dania
(ex S.S. "Alacrity")

Deck & Profile Plan of vessel
as built.

Mdt report No. 11907



© 2021

Lloyd's Register
Foundation

002690-002700-0155 1/2