


S.S. "COPSEWOOD."

MIDSHIP SECTION (AS BUILT.)

FULL SCANTLING VESSEL CLASS 100. A.I. 1923-4 RULES.

L.B.P. 198'-0" BR. MLD. 32'-0" D.MLD 14'-7"

SCALE 1/2" = 1'-0"

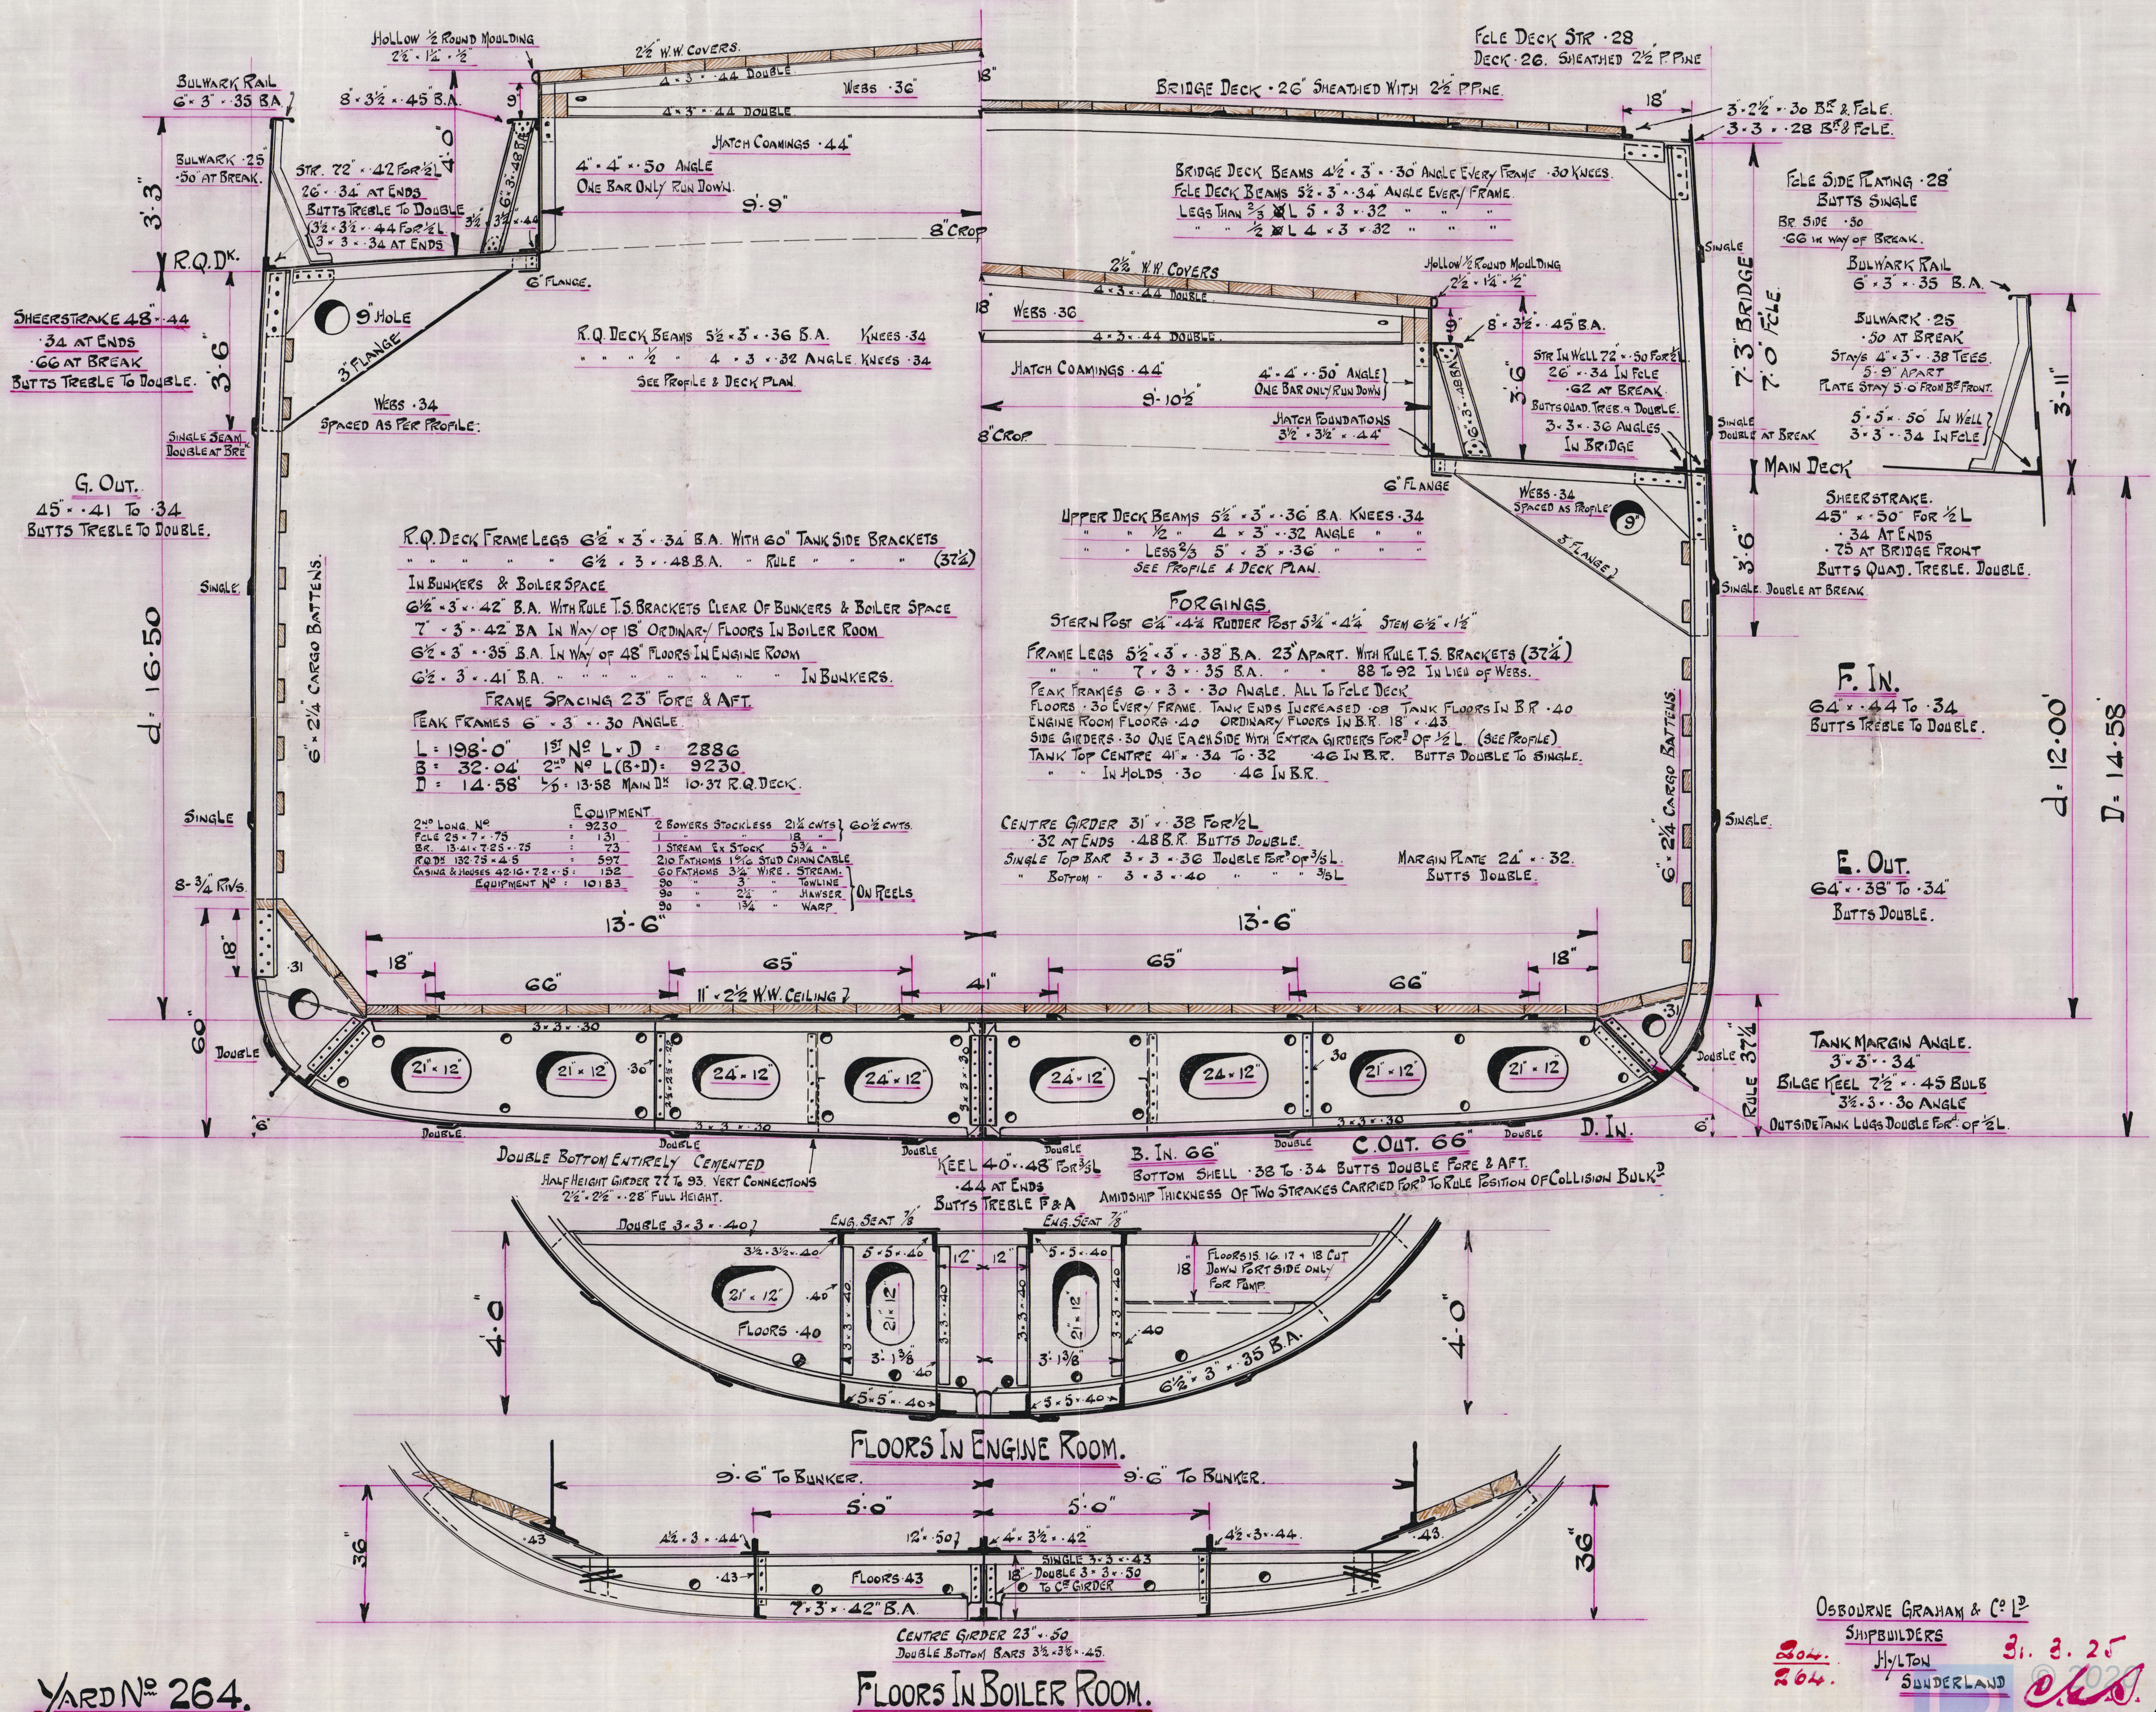

YARD No 264.

OSBOURNE GRAHAM & CO LTD

SHIPBUILDERS

HYLTON

SUNDERLAND

31. 3. 25

£/S "COPSEWOOD"

Osbourne Graham & Co's

N° 264


MIDSHIP SECTION

(as built)

KYLE BANK *

SUNDERLAND RPT. NO. 29051

Deck 26 SHEATHED 2 1/2" PLANK
False Deck 27K 28

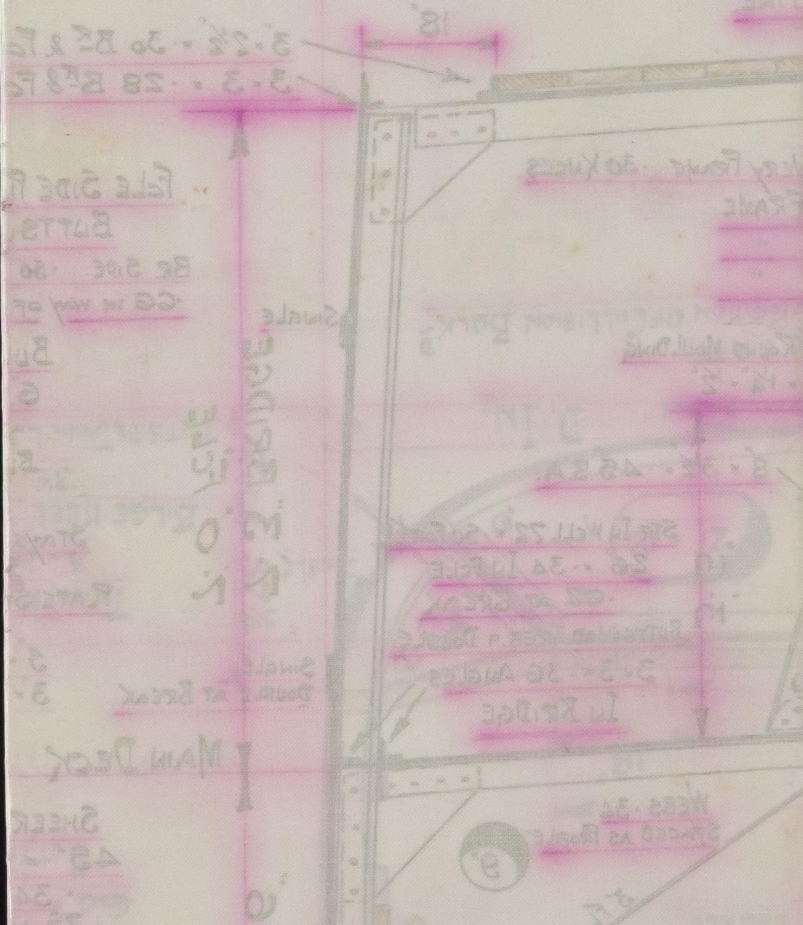

© 2020

Lloyd's Register
Foundation

002858-002869-0310