



D DECK.

D DECK.

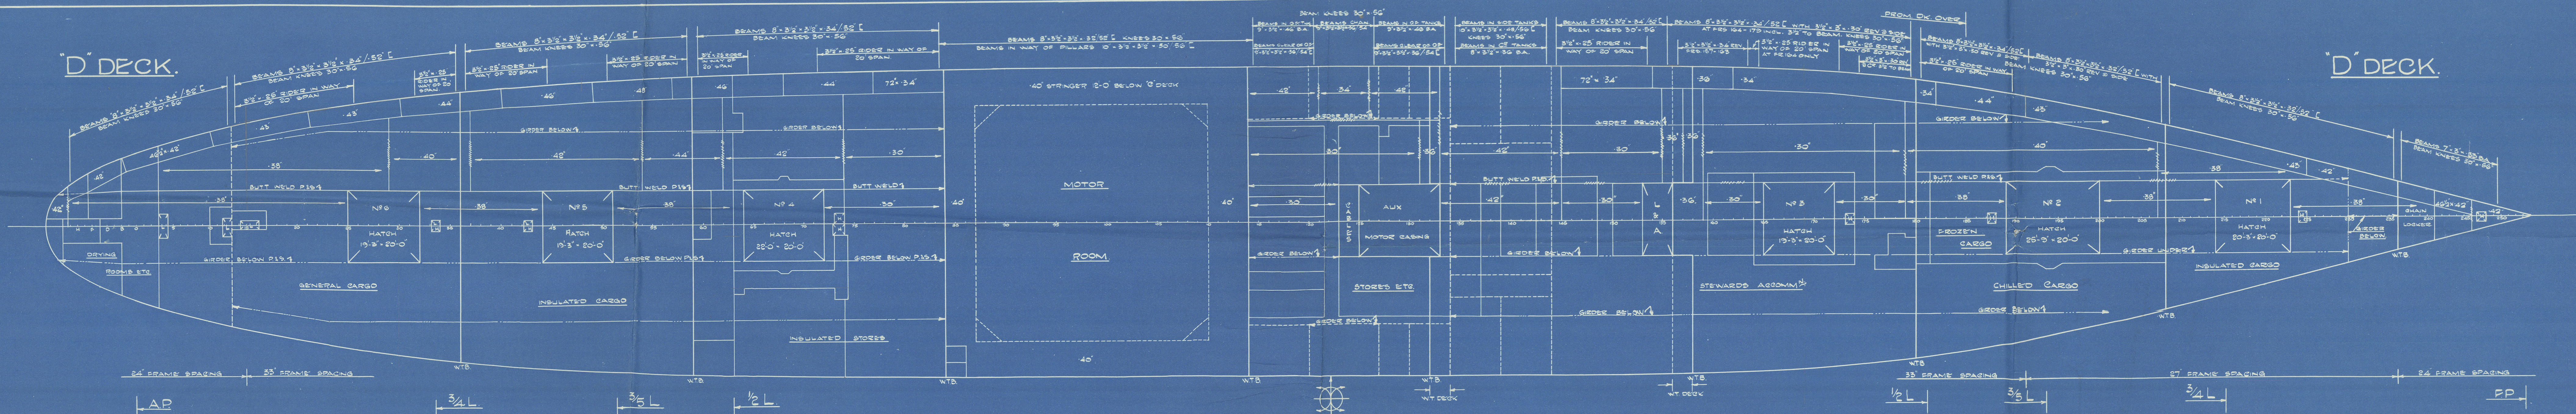

E DECK.


E DECK.

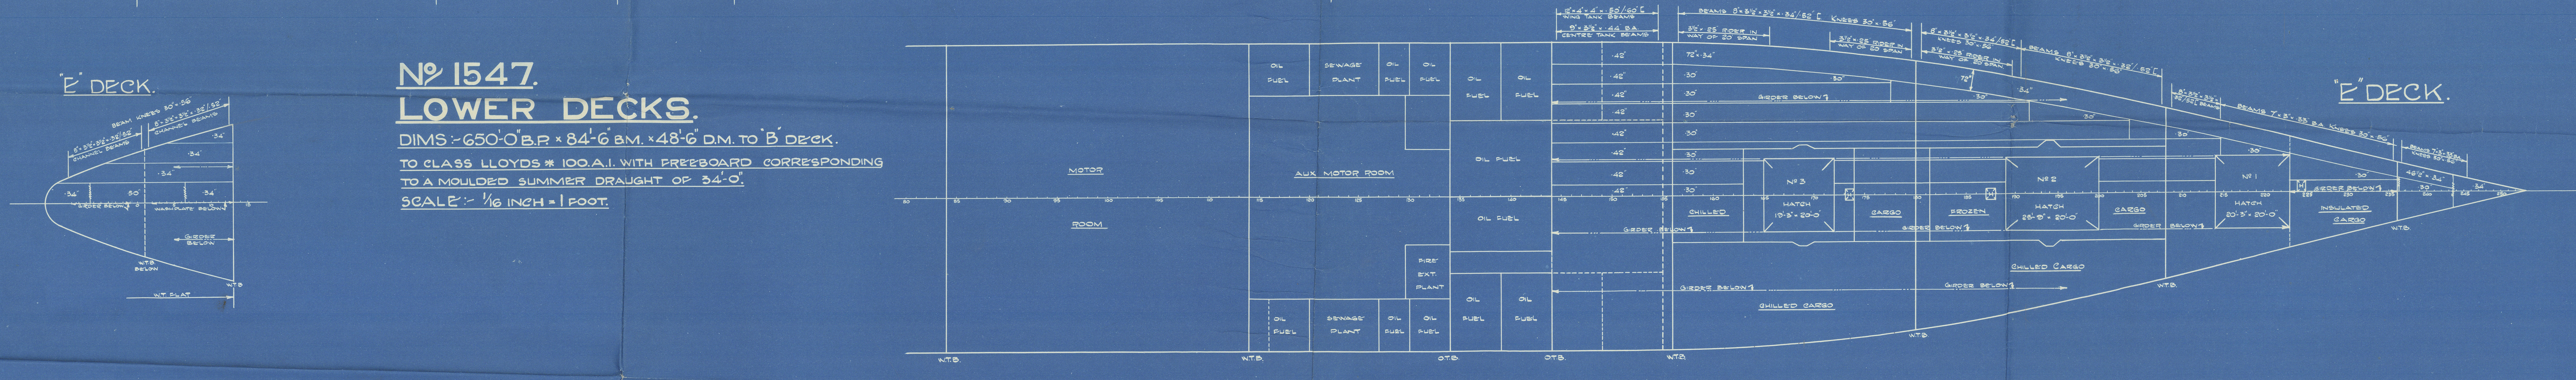


Nº 1547. **LOWER DECKS.**

DIMS: 650' O.B.P. x 84' 6" B.M. x 48' 6" D.M. TO B' DECK.
TO CLASS LLOYDS # 100.A.1. WITH FREEBOARD CORRESPONDING
TO A MOULDED SUMMER DRAUGHT OF 34'-0".
SCALE: 1/16 INCH = 1 FOOT.

TUNNEL FLAT.

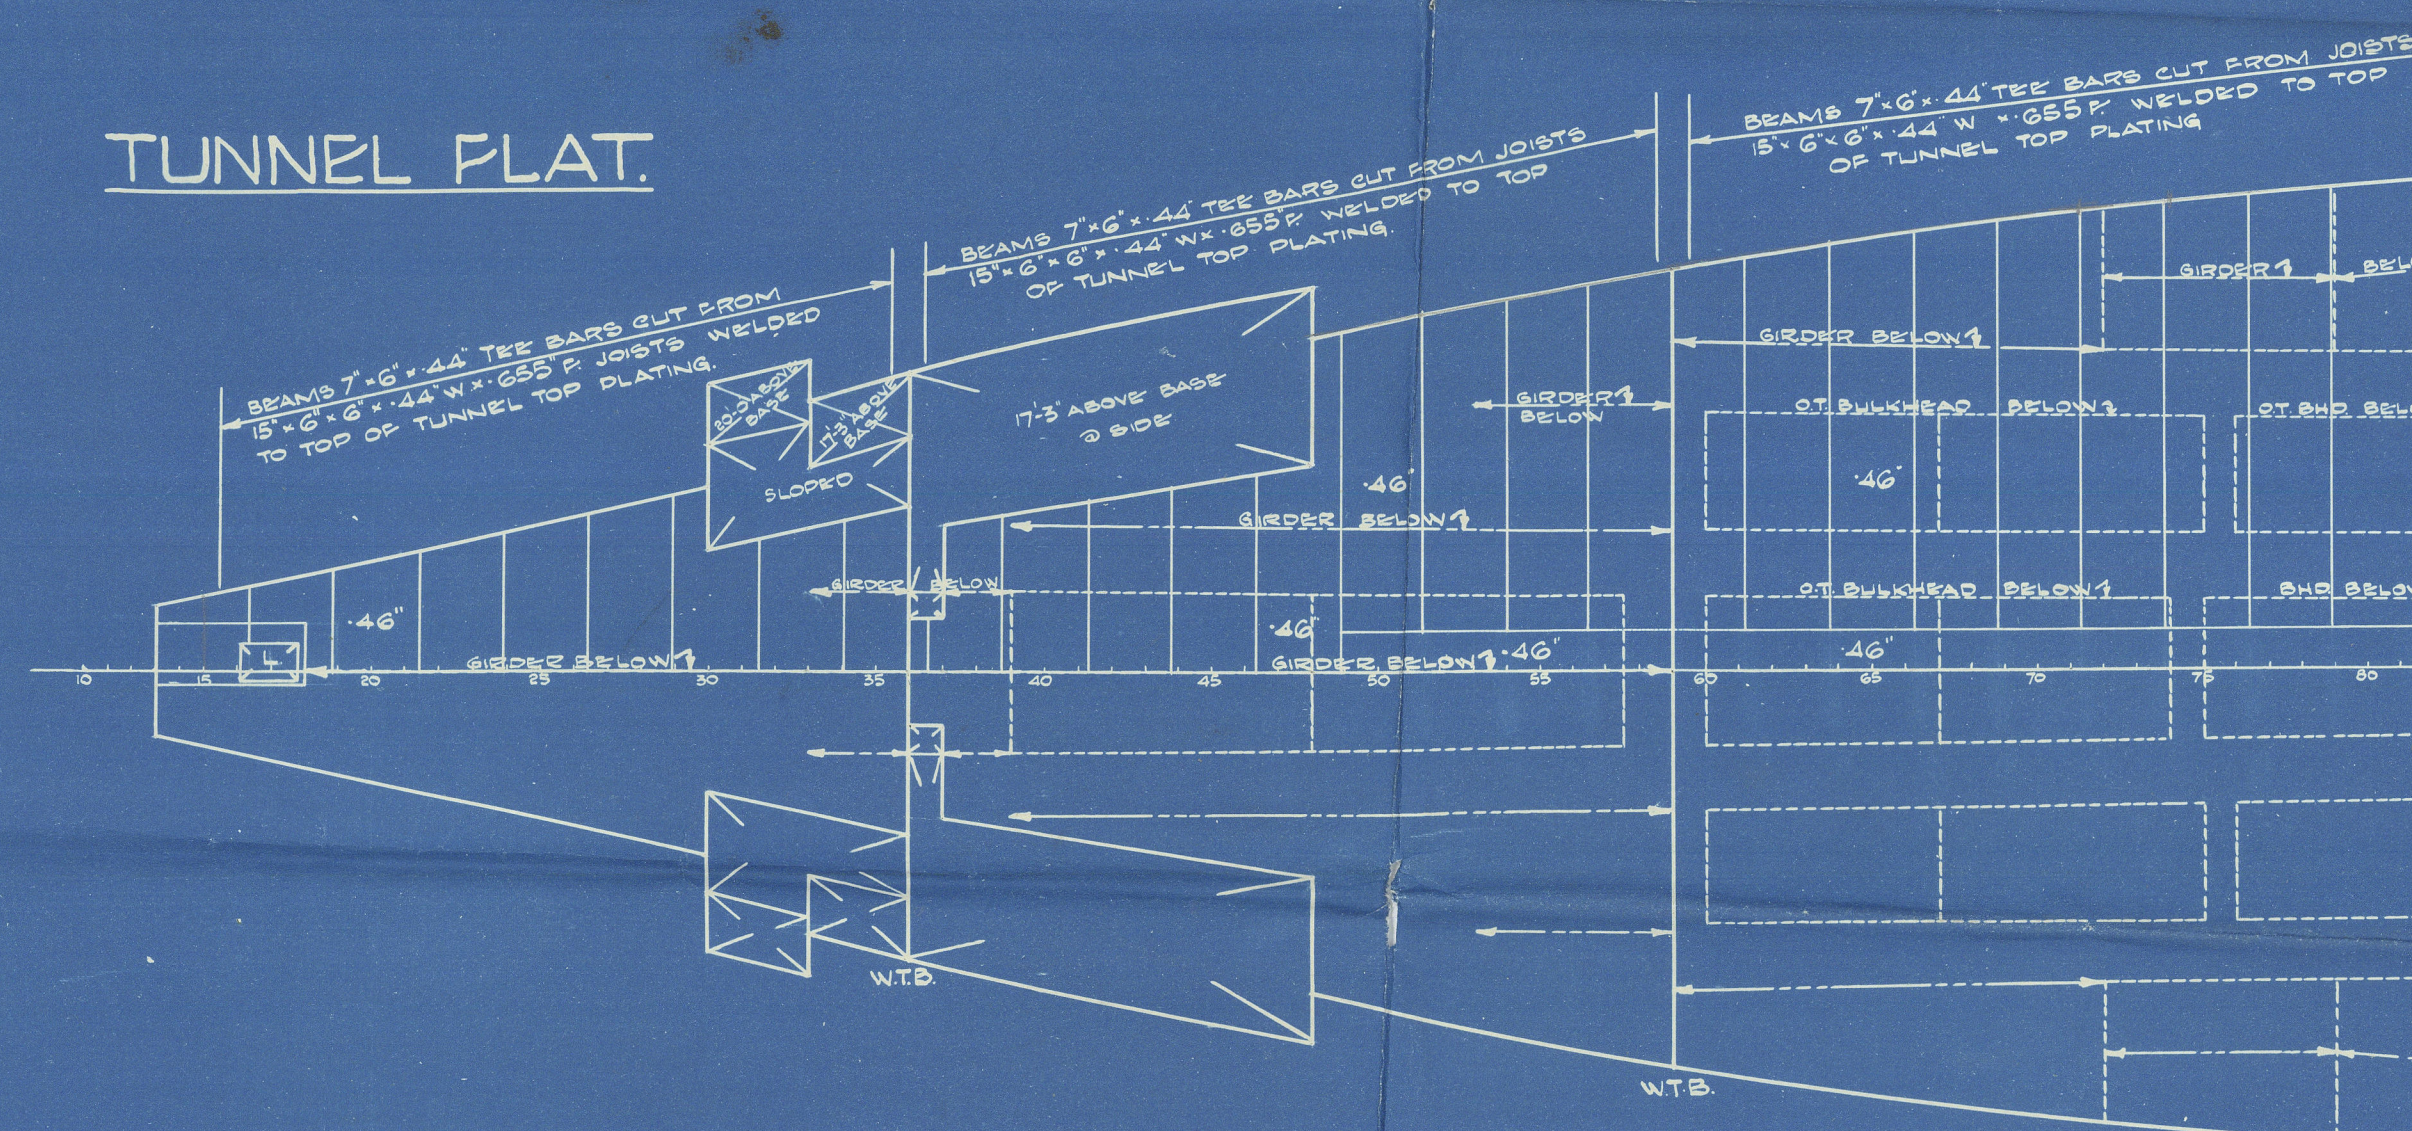


F DECK.

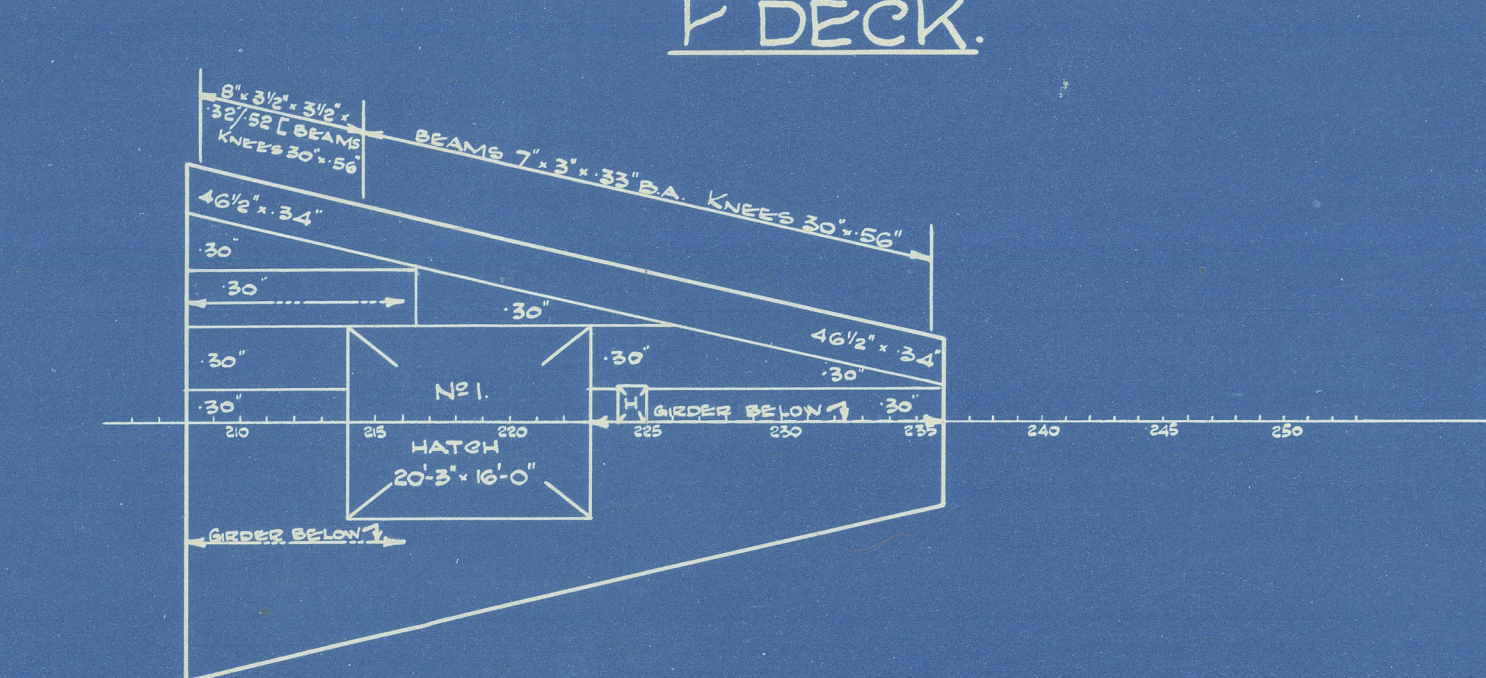

TANK TOP.

TANK TOP.

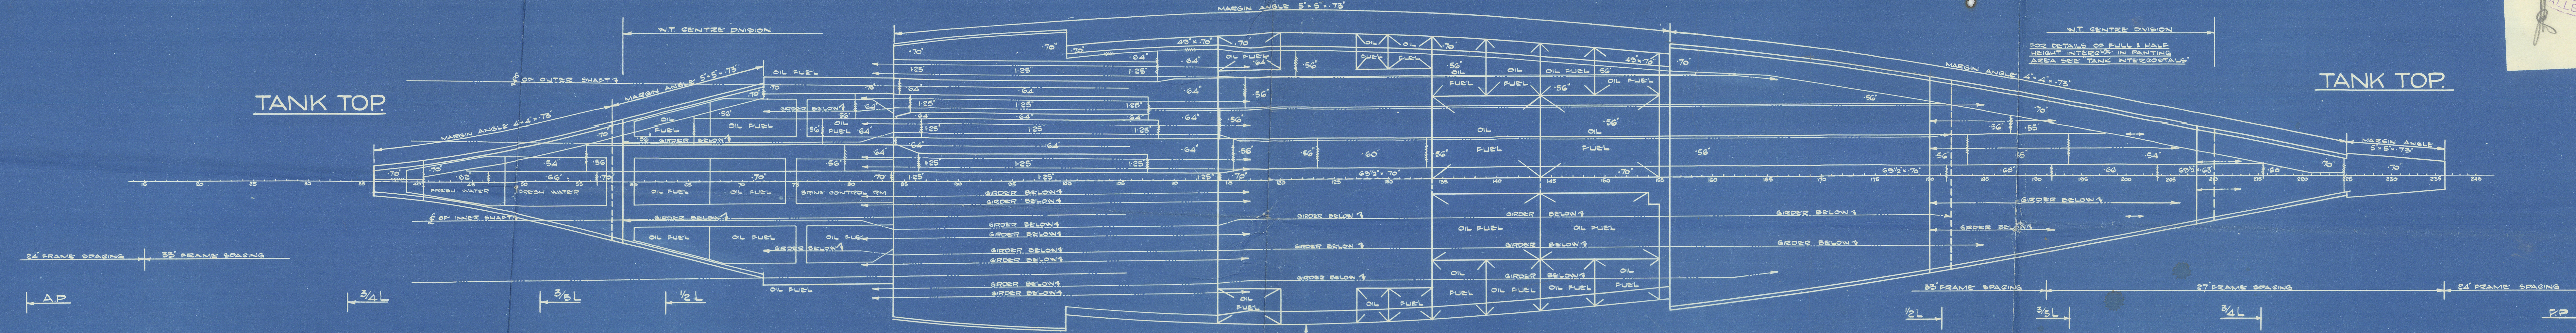

Q.S.M.V. Dominion Monarch

Swan Hunter No 1547

lower Deck
as Built

RETAIN



© 2020

Lloyd's Register

002947-002955-0225