


LENGTH BTW. PP	146.201 M. (480'-0")
BREADTH MOULDED	19.885 " (65'-9")
DEPTH MOULDED TO UPPERDECK	10.922 " (35'-10")
SCALE 1:100.	

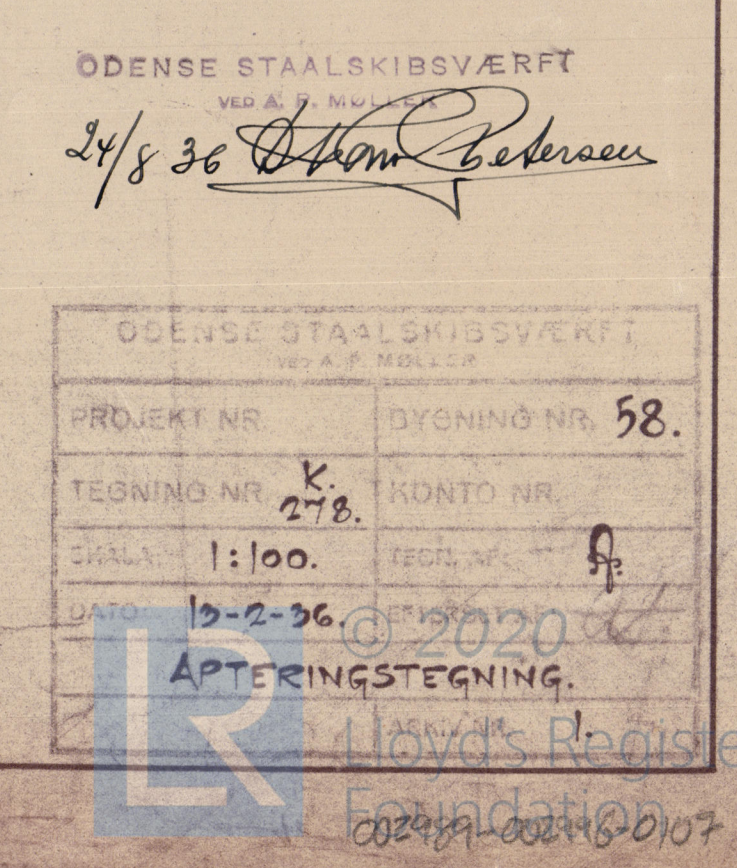

Messrs. Oude Staalskroef's

Yard No. 58.

General Arrangement
as built.

M/s. LOOSDRECHT of Rotterdam

Exp. Rpt. No. 10,002.



© 2020

Lloyd's Register

602989-002996-0107