

S.S. No 143.


# PROFILE & DECK PLAN.

SCALE:  $\frac{1}{8}" = 1 \text{ FOOT.}$

## DIMENSIONS.

LENGTH B.P. 196'-10"  
BREADTH MLD. 30'-6"  
DEPTH MLD. TO UPPER DK. 14'-3"

BULKHEAD				SCANTLING.			
Nº OF BLD.	FRAMES	LOWER PLATE	UPPER PLATE	STIFFENERS.	SPACING	BRACKETS	BOUNDARY ANGLE RIVETING.
4 W.T.	$3\frac{1}{2}" \times 3\frac{1}{2}" \times 40'$	IN LUGS 50' OF DOUBLING	.30"	BEAM PLATE $5" \times 3" \times 30'$	24"	10' X 34' 10' X 34'	SINGLE
34 W.T.	$3\frac{1}{2}" \times 3\frac{1}{2}" \times 30'$	.29"	.26"	7' X 3' X 37' B.A.	29 1/2"	17 1/2' X 40'	SINGLE
94 W.T.	$3\frac{1}{2}" \times 3\frac{1}{2}" \times 40'$	.30"	.26"	BEAM PLATE $5" \times 3" \times 30'$	24"	Nº BKTS.	SINGLE

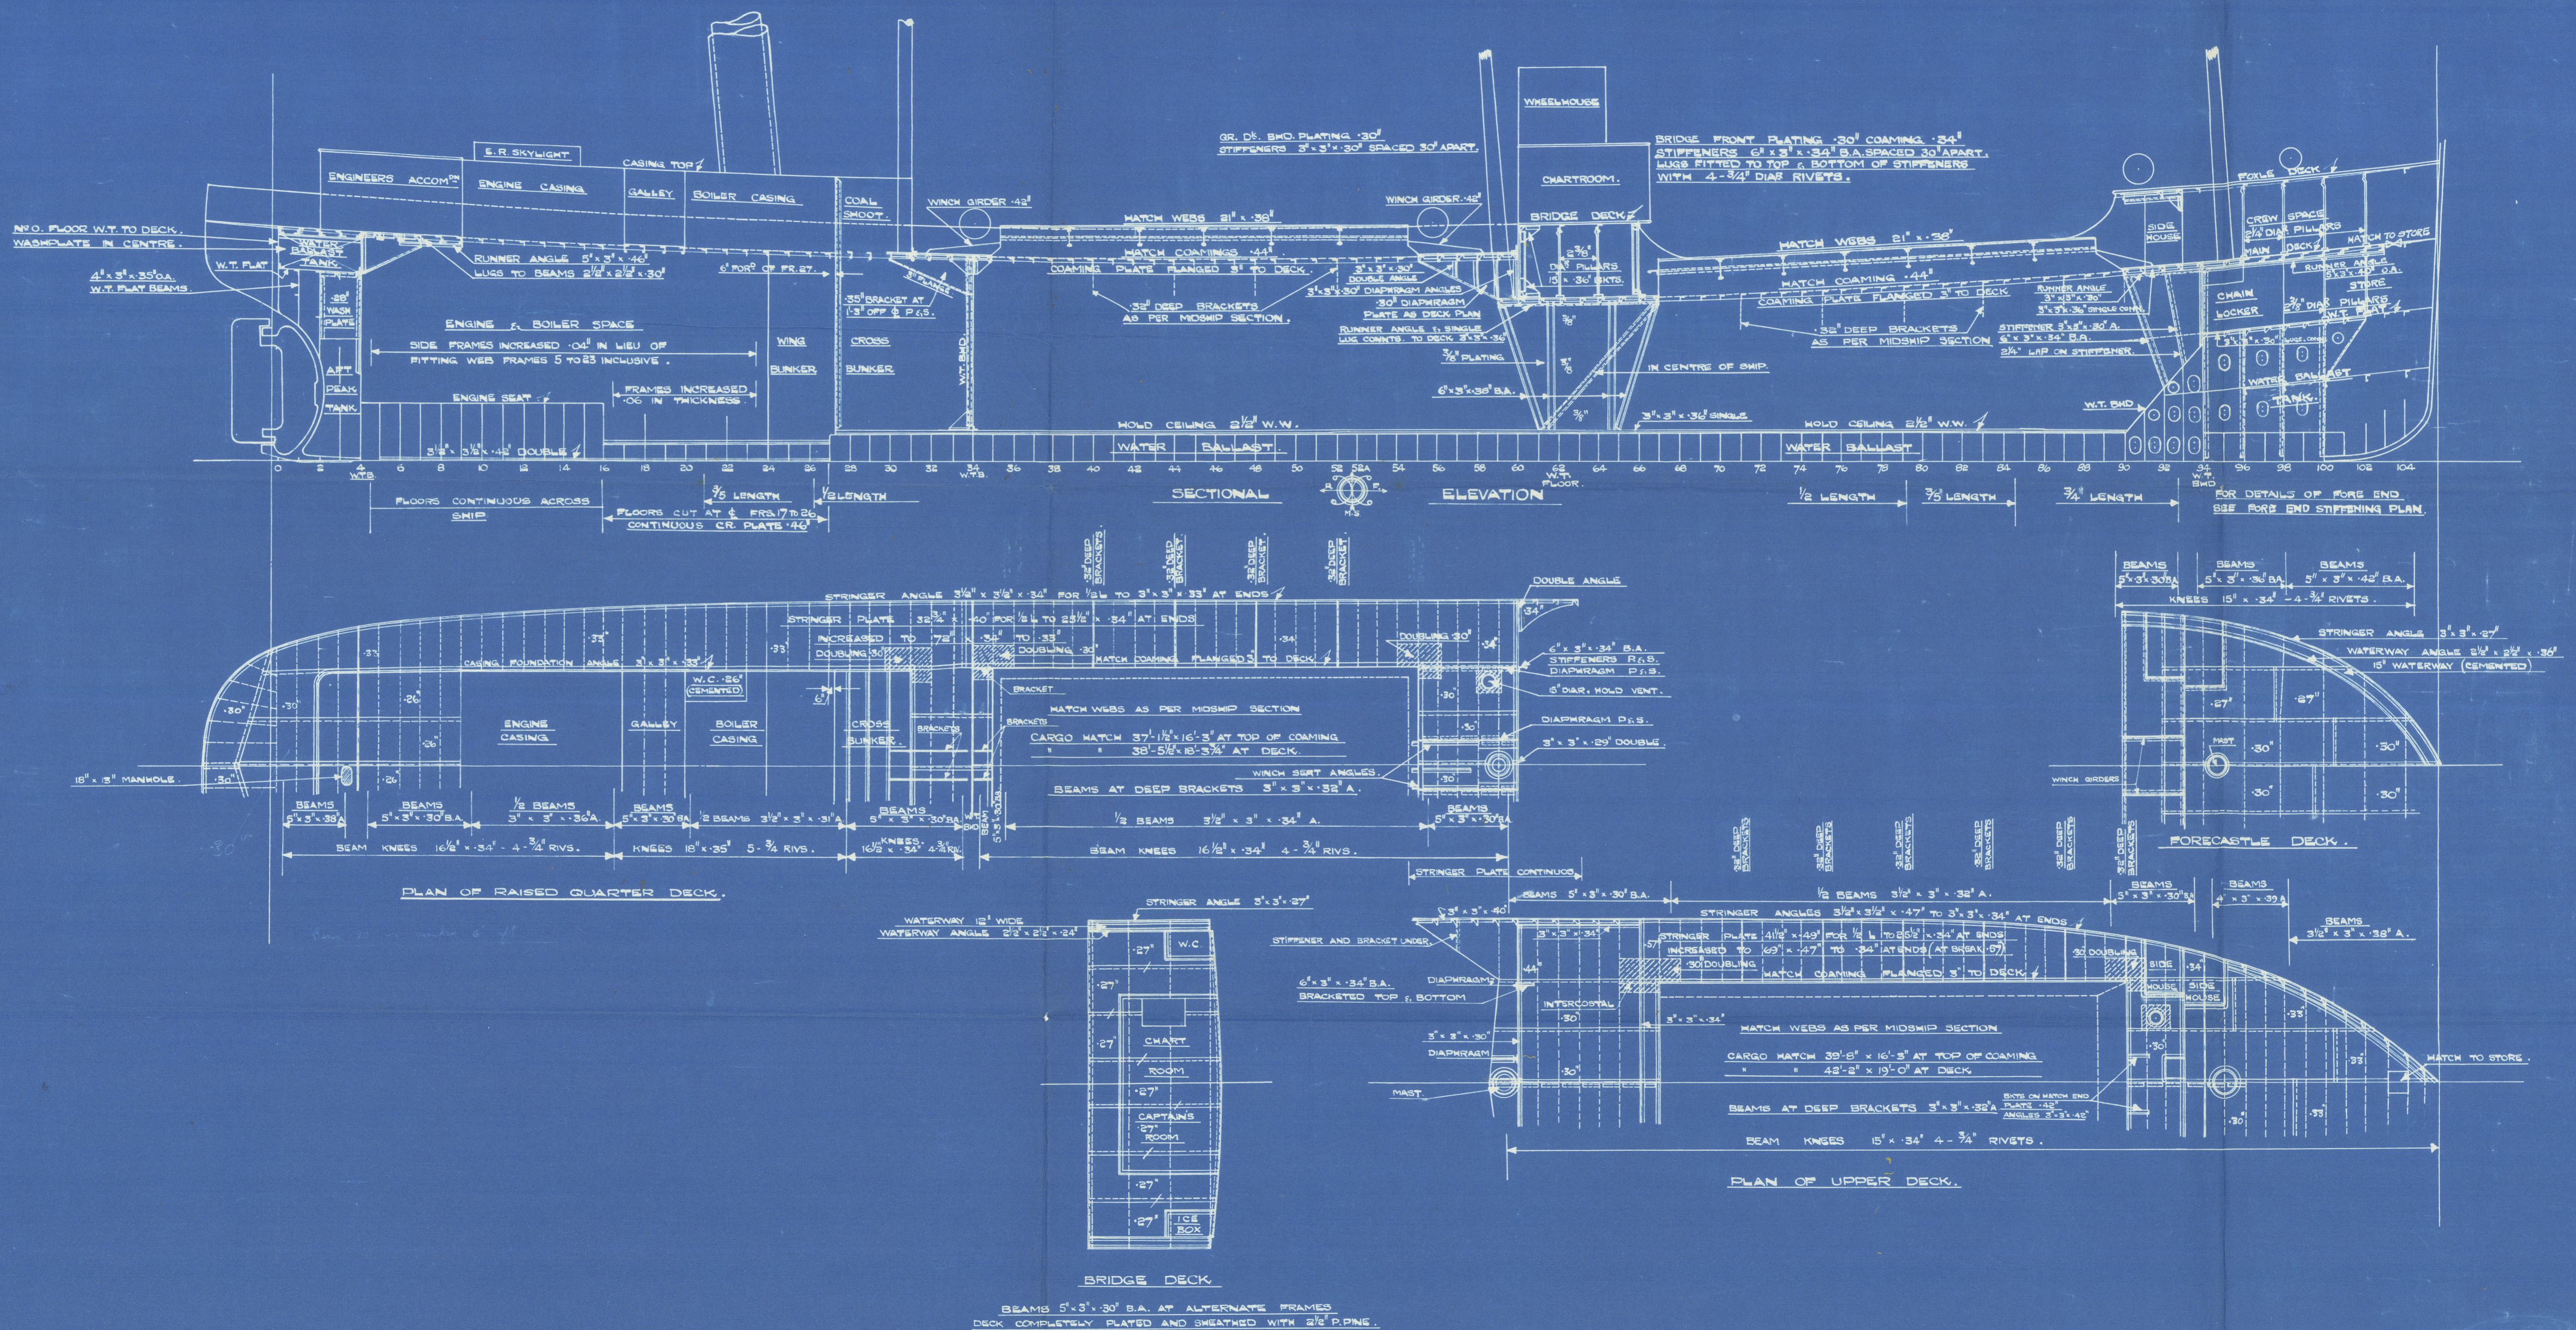

1 DEC 1937

JOHN LEWIS & SONS LTD  
24 NOV 1937  
15162  
Lloyd's Register  
Foundation

33


Profile & Deck

J. Lewis & Sons.

No. 143.

As built.



GLEN FARG.

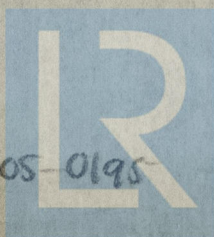

© 2020


Lloyd's Register  
Foundation

002997-003005-0195

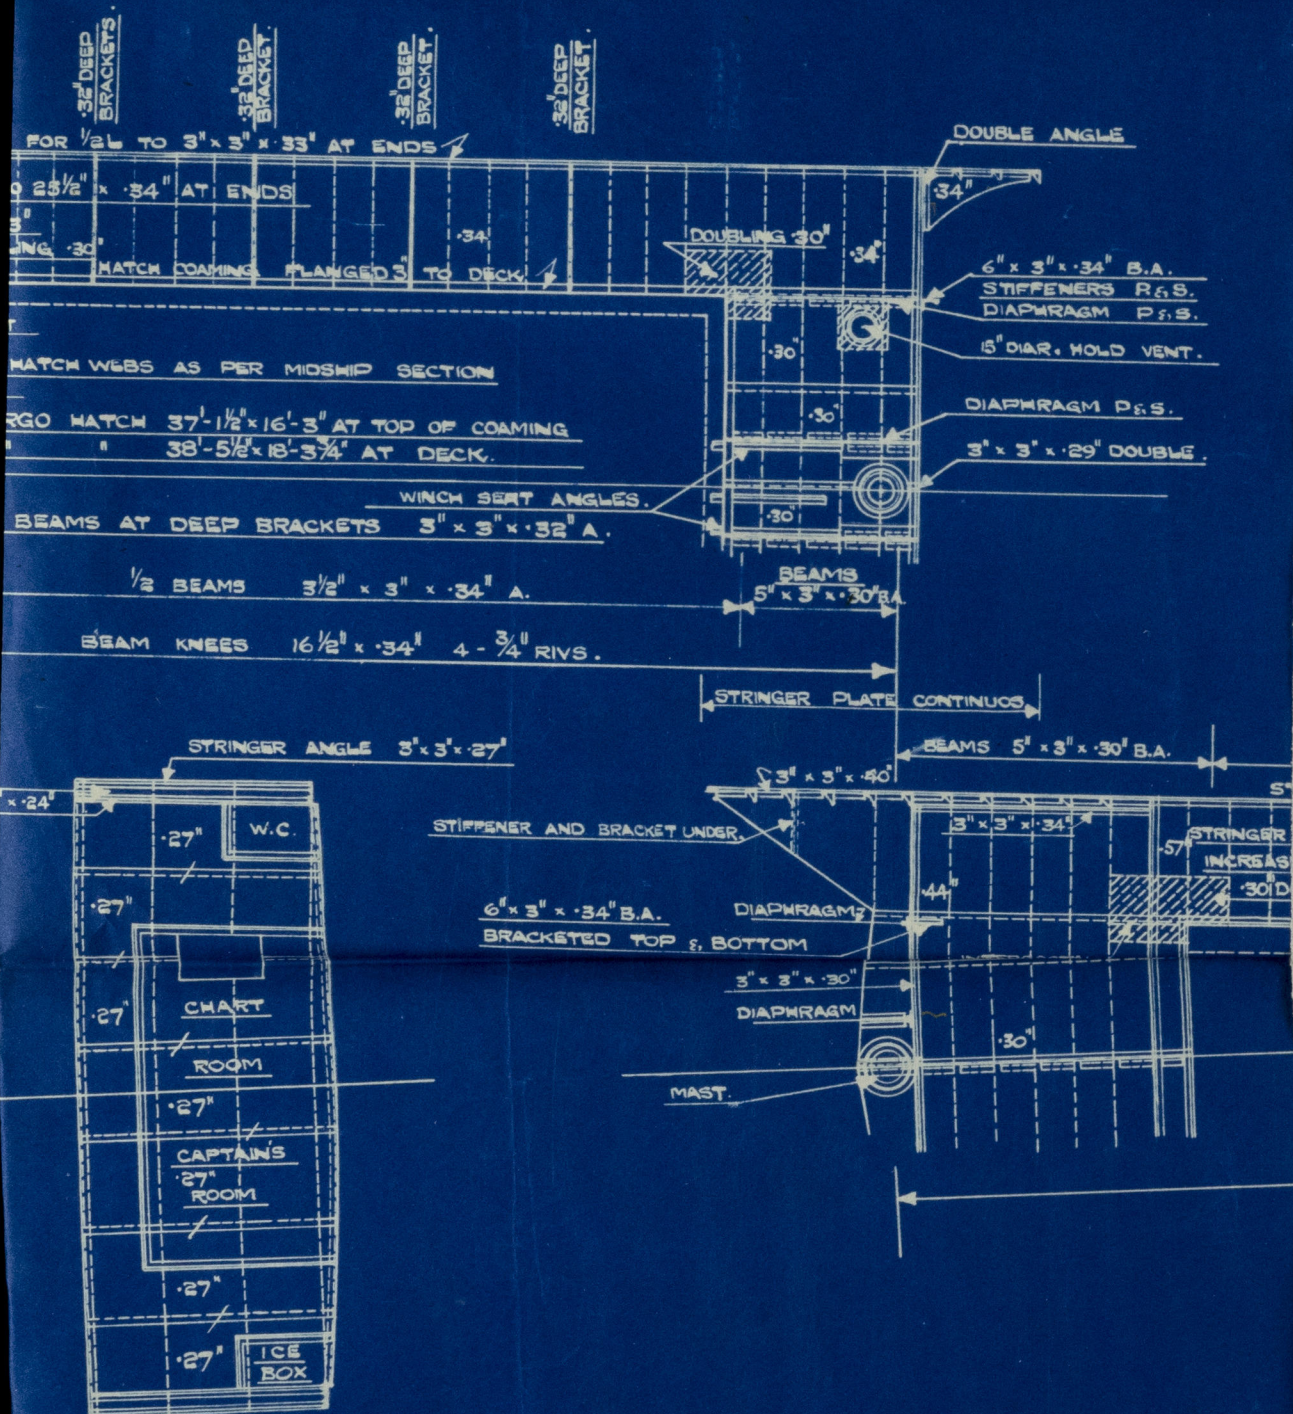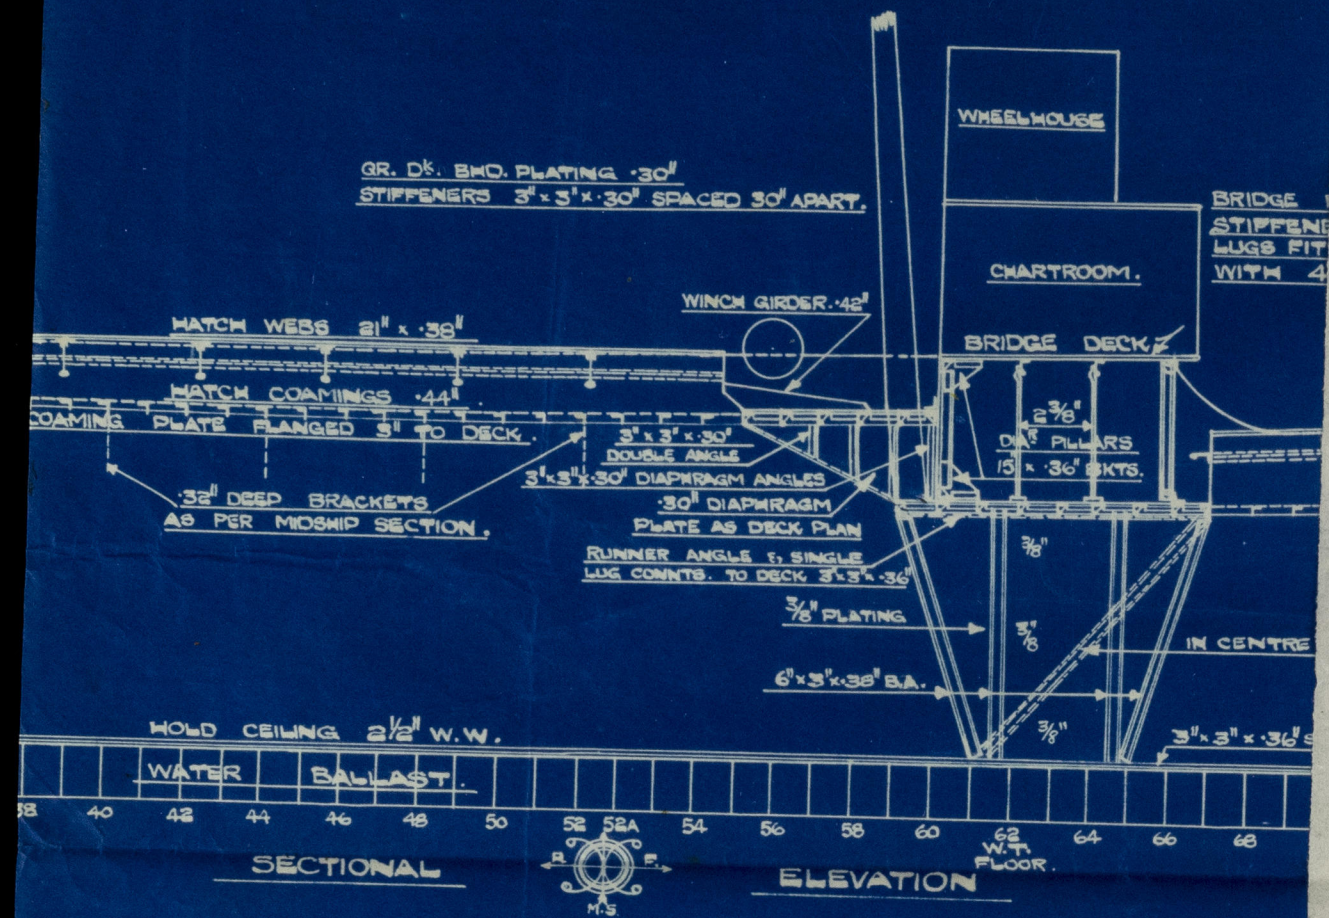

BRIDGE DECK

5" x 3" x .30" B.A. AT ALTERNATE FRAMES  
COMPLETELY PLATED AND SHEATHED WITH 2 1/2" P.PINE.

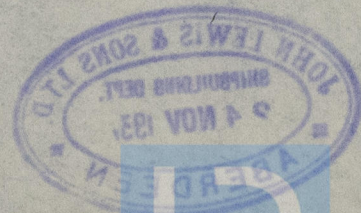

© 2020



Lloyd's Register  
Foundation