

No. 375. (As BUILT.)

MIDSHIP SECTION

R.Q.D.COASTER "CLARA MONKS."

TO CLASS + 10 A.I. LLOYD'S

DIMENSIONS:- L. 170'-0" B.P., B.M.^L 26'-0", D.M.^L TO UPPER DECK 13'-0"
D.M.^L TO QUARTER DECK 16'-7"

SCALE $\frac{1}{2}$ IN. H = 1 FOOT.

LLOYD'S NUMERALS

TRANSVERSE N^o 39 ✓

LONGITUDINAL N^o 6650 ✓

$\frac{L}{D}$ 13.07 ✓

"d" 11.54 ✓

UPPER DK. ✓

QUARTER D ✓

..... 10.25 ✓

..... 15.12 ✓


LONGITUDINAL №	6630
QUARTER DK 93.7 x 3.58	335
BRIDGE DK. 10.75 x 6.58 x .75	53
FORECASTLE DK 28 x 6.88 x .75	144
CASING 51.5 x 6.75 x .5	174
EQUIPMENT № =	7336

3 BOWER ANCHORS EACH 1 5/8 CWTs. STOCKLESS
1 STREAM ANCHOR 4 CWTs. EX STOCK
1 KEDGE ANCHOR 1 3/4 CWTs EX STOCK
195 FATHOMS 1 3/16" STUD CHAIN CABLE
60 FATHOMS 2 3/4" STEEL WIRE STREAM
75 FATHOMS 2 3/4" STEEL WIRE TOWLINE
90 FATHOMS 6" MANILLA HAWSER
140 FATHOMS 5 1/2" MANILLA HAWSER
140 FATHOMS 5" MANILLA WARP.

SCANTLINGS FOR BRIDGE-FORECASTLE DECKS

	BRIDGE	FORECASTLE
HEIGHT	6' 7"	6' 9"
ROUND OF BEAM	9"	9"
BEAMS ON ALT. FRAMES	4 1/2" x 3" 34'	6 1/2" x 3" x 40' B
BEAM KNEES	11" x 0"	15" x 30"
SIDE PLATING	3/4"	26"
STRINGER PLATE	30" x 26"	21" x 26"
TIE PLATES	18" x 26"	72" x 30"
STRINGER ANGLE	3" x 3/4" 26"	3" x 3" x 40"
WOOD DECK	4" x 2 3/4" PINE	5" x 2 3/4" P.PINE

THE SCANTLING INDICATED INCLUDE THE FOLLOWING
ADDITIONS OVER LLOYD'S REQUIRED BY SPECIFICATION:-
FRAMES IN WAY OF UPPER DECK TO BE OF BULB ANGLE IN LIEU OF ANGLE
FLOORS INCREASED .04".
FORECASTLE STRINGER ANGLE INCREASED .14".
GARBOARD STRAKE INCREASED .06" FOR 1/2 LEN. AND .08" AT ENDS.
B, C, D + E STRAKES INCREASED .02" FOR 1/2 LEN.
Q. SHEER STRAKE INCREASED .08" AT ENDS.
QUARTER DECK STRINGER PLATE INCREASED .04" FOR 1/2 LEN.

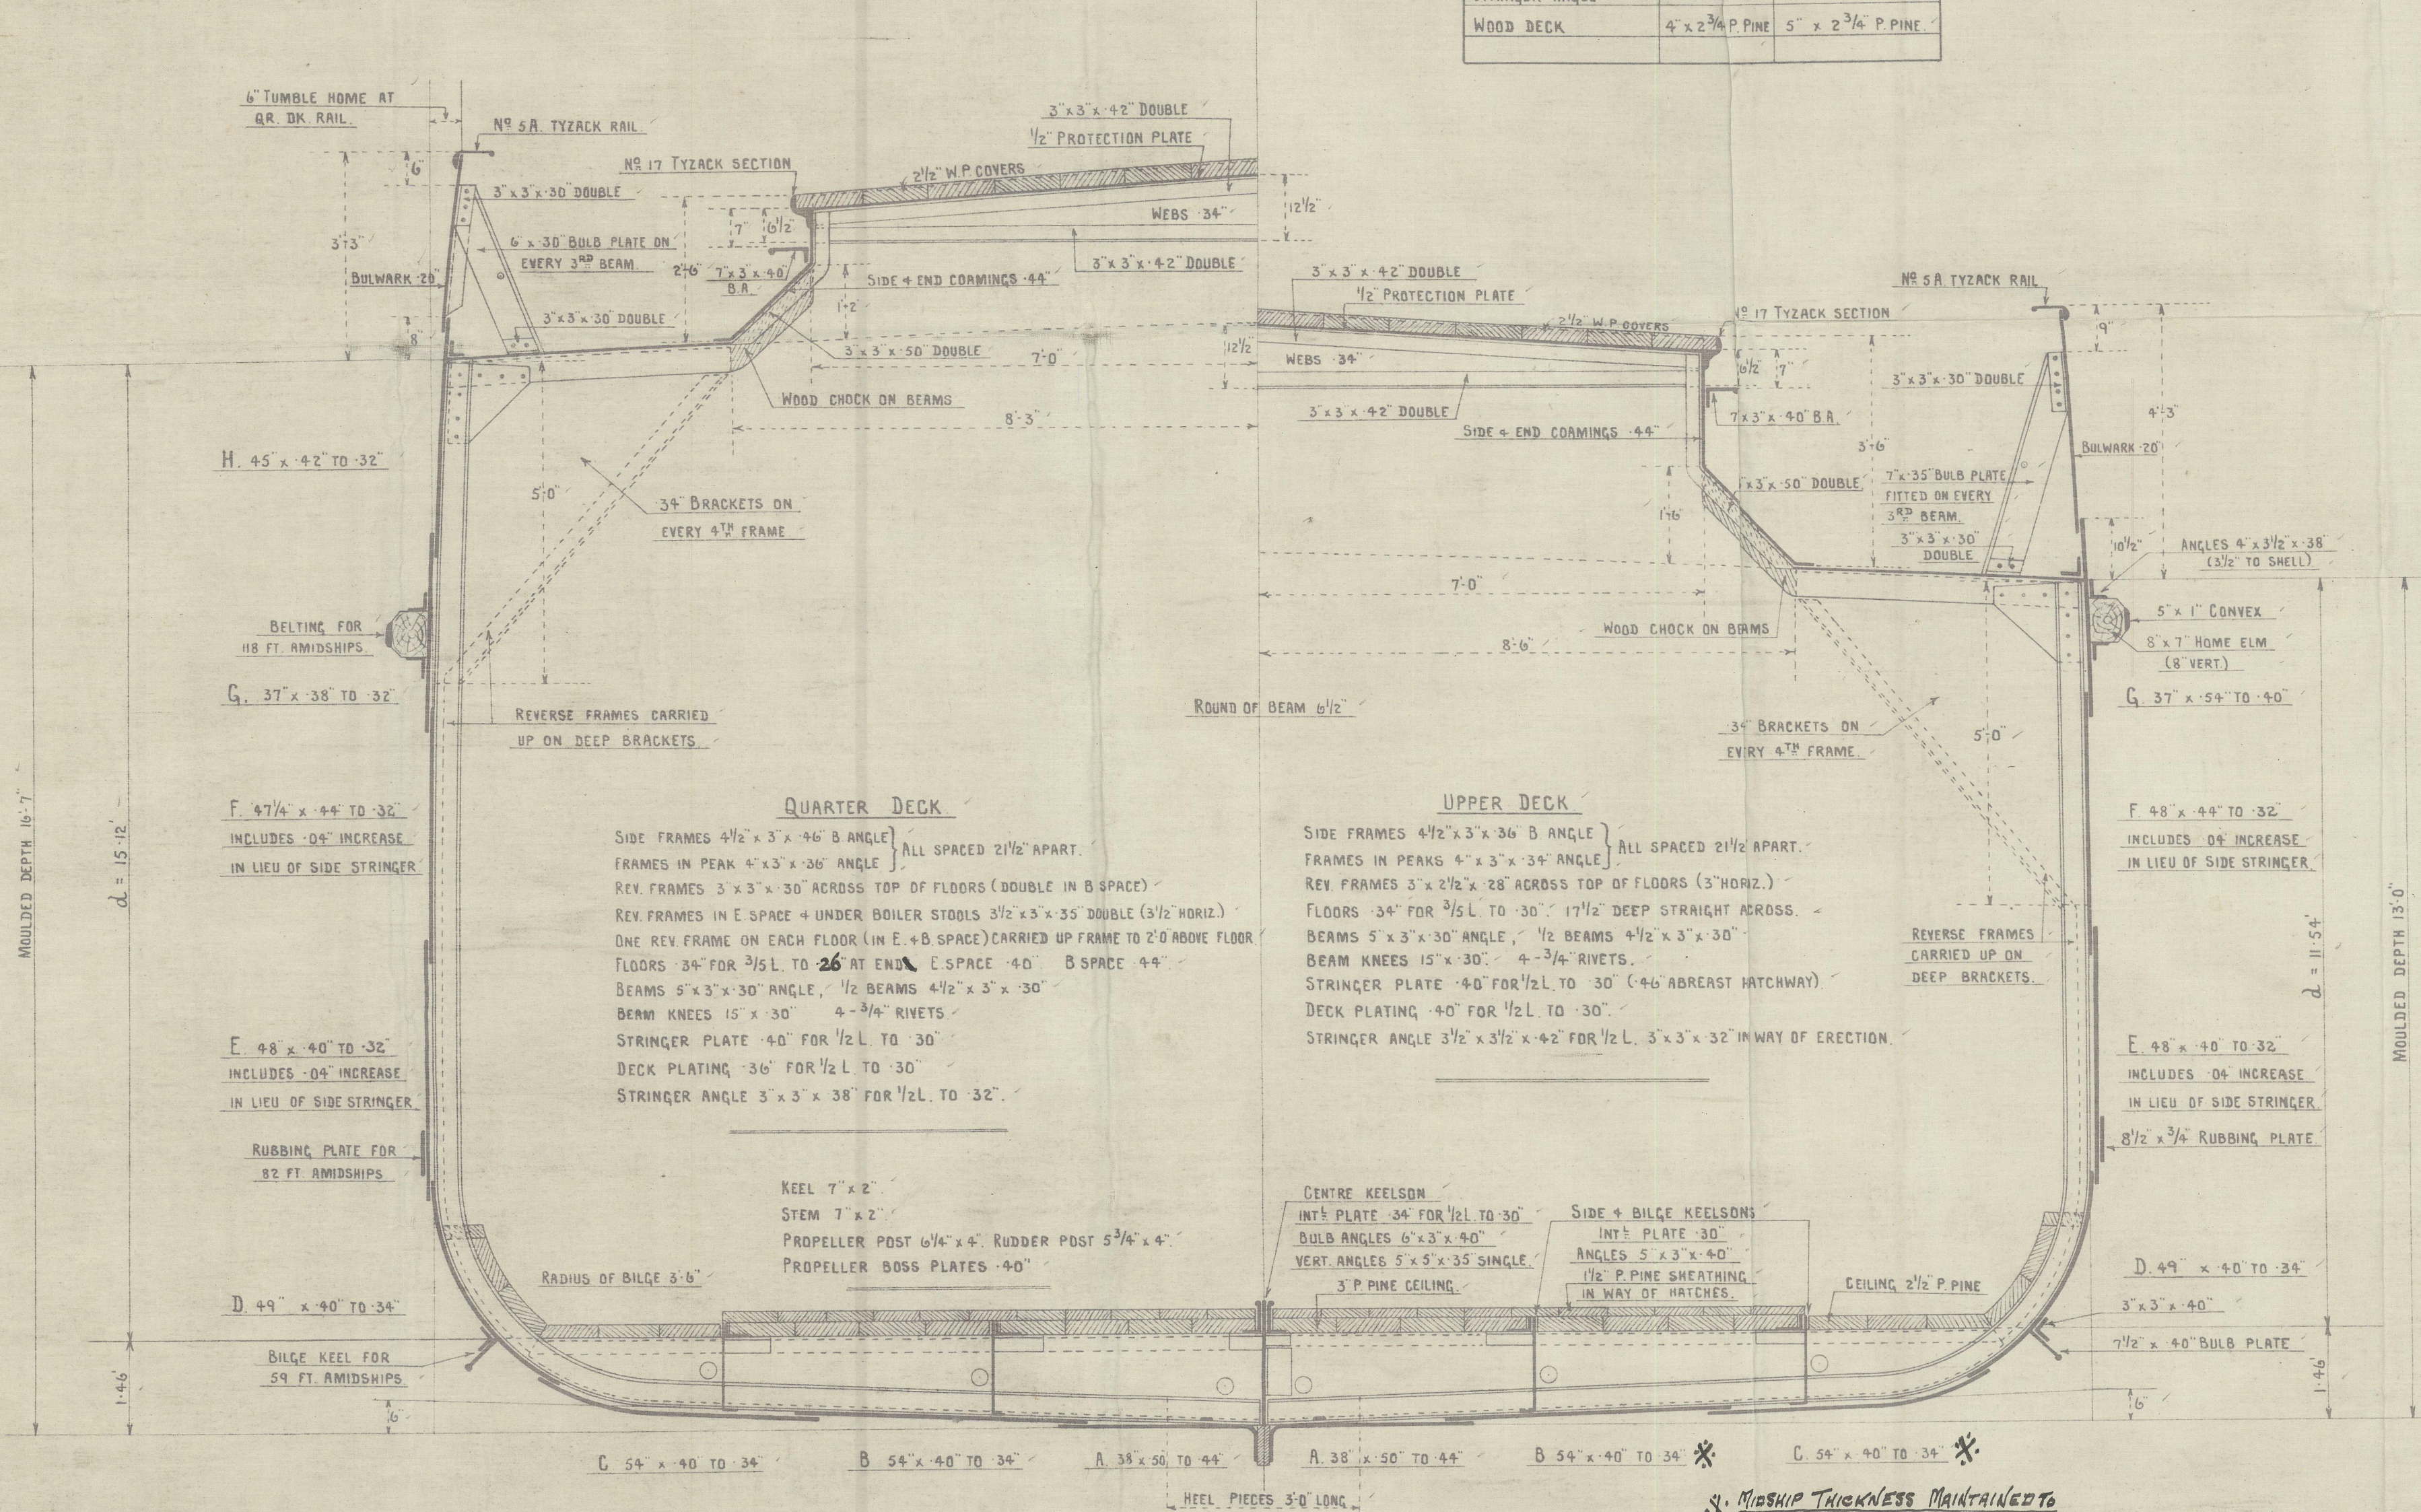

RIVETING

	FOR 1/2 LEN. JO.	AT ENDS.
UPPER DECK SHEERSTRAKE	TREBLE RIVETED STRAPS	DOUBLE RIVETED STRAPS
QUARTER " "	" " LAPS	" " LAPS
STRAKE BELOW UPPER DECK SHEERSTRAKE	" " " "	" " " "
" " QUARTER " "	DOUBLE " " " "	" " " "
SHELL PLATING GARBOARD STRAKE	TREBLE RIVETED STRAPS	DOUBLE RIVETED STRAPS
" " " " TO UPPER TURN OF BILGE	DOUBLE RIVETED LAPS	DOUBLE RIVETED LAPS
SHELL PLATING UPPER TURN OF BILGE TO STRAKE BELOW SHEERSTRAKE	" " " "	" " " "
BRIDGE & FORECASTLE SIDE PLATING	" " " "	" " " "
UPPER DECK STRINGER PLATE	TREBLE " " " "	" " " "
QUARTER " " " "	DOUBLE " " " "	" " " "
BRIDGE & FORECASTLE DECK STRINGER PLATE	" " " "	" " " "
UPPER DECK PLATING	" " " "	SINGLE " " " "
QUARTER " " " "	" " " "	" " " "
BRIDGE & FORECASTLE DECK TIES	" " " "	DOUBLE " " " "
EDGE CONNECTIONS.		
SHEERSTRAKE & GARBOARD STRAKE	DOUBLE RIVETED ALL FORE AND AFT	
REMAINDER OF OUTSIDE PLATING	" " " "	" " " "
DECK PLATING	SINGLE " " " "	

EDGE CONNECTIONS

SHEERSTRAKE + GARBOARD STRAKE	DOUBLE RIVETED ALL FORE AND AFT
REMAINDER OF OUTSIDE PLATING	" " " " " "
DECK PLATING	SINGLE " " " " "

SECTION THRD' HOLD IN WAY OF QUARTER DECK.

SECTION THRO' HOLD IN WAY OF UPPER DECK.

YARD NO 375

Aulsa Co.

No. 375

S/S. "CLARA MONKS"

Widship Section.

(As built.)

GLASGOW REPORT No. 40715.

003006-003012-0097



© 2021

Lloyd's Register
Foundation