



SINGLE SCREW STEAM TENDER

To Lloyd's Class + 100 A.I.

SCALE :- $\frac{1}{4} = 1$ Foot

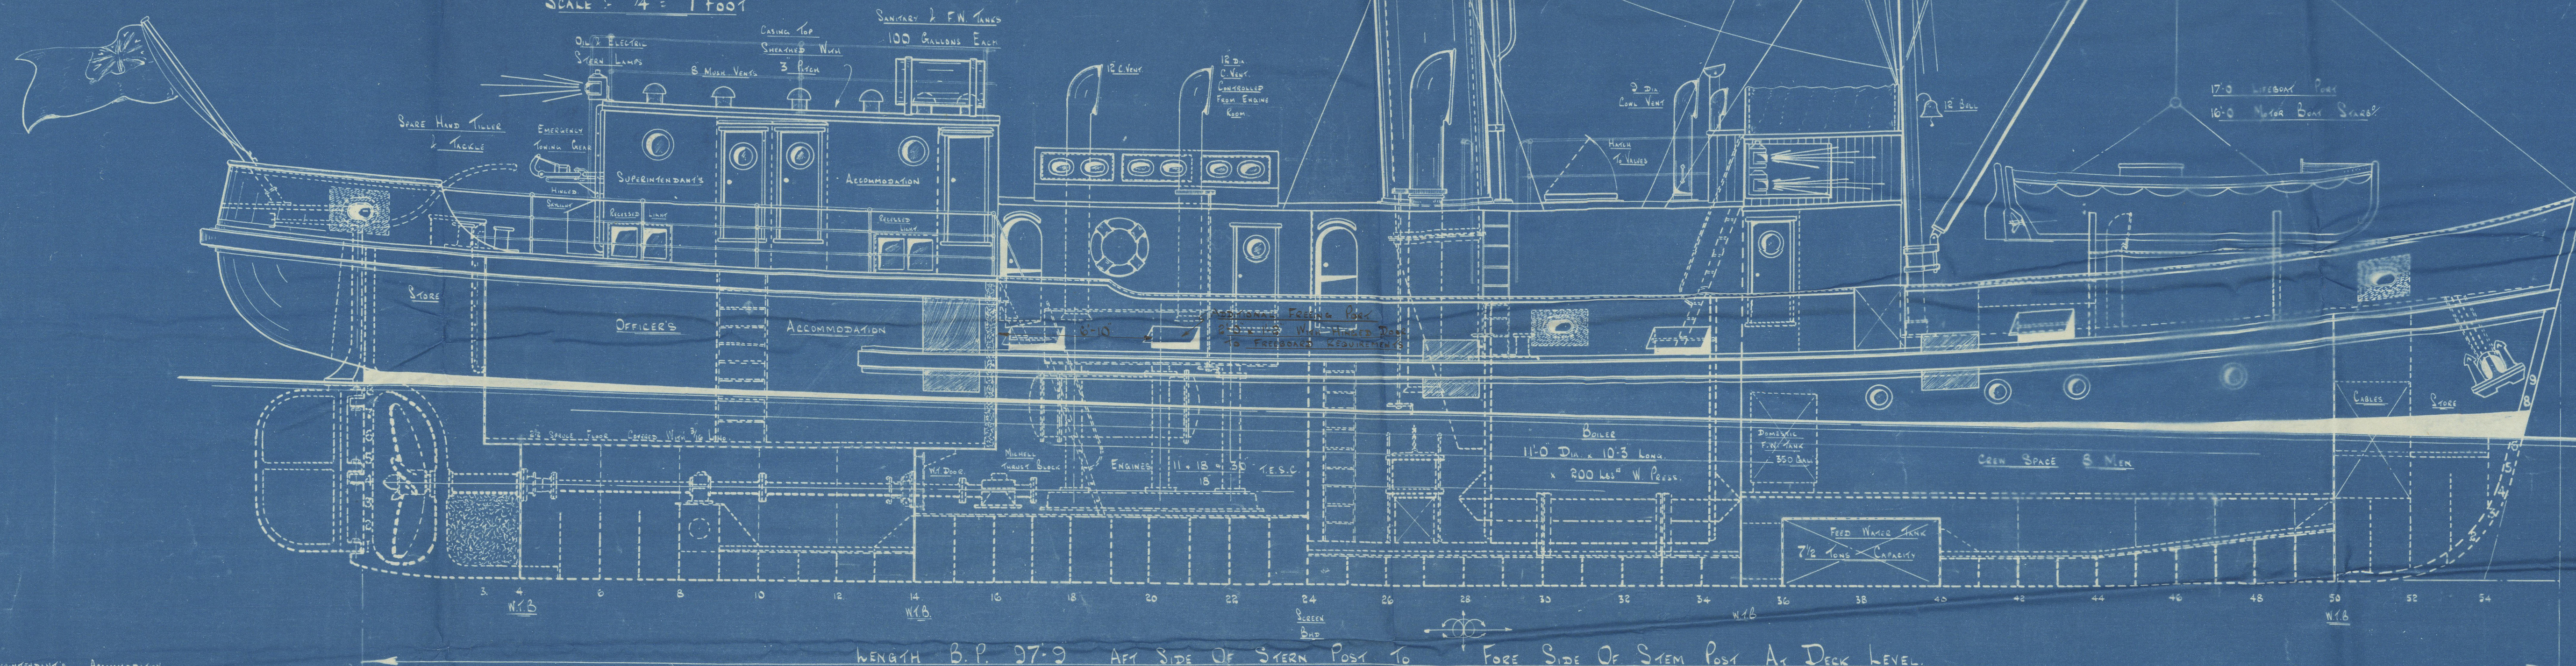


S. HARTMAN'S ALBUQUERQUE
 Day Room Feeds With Sweet Good Case
Overlain Chart Rock, Posioned Table 5-0 2-5
Sweetened Nuts Bittered Glass Mixture Abund
Reserve Chart Hard Glass 5 Bitter Case Exc
Bedroom Feeds Nuts Sweet Bed 6-6 2-6
Nuts Deep Dances Brown
Chart Of Dearest Whence Wien G. M. M. M.
Chart House Good Race
Bittered Mixer Glass 5 Bitter Race

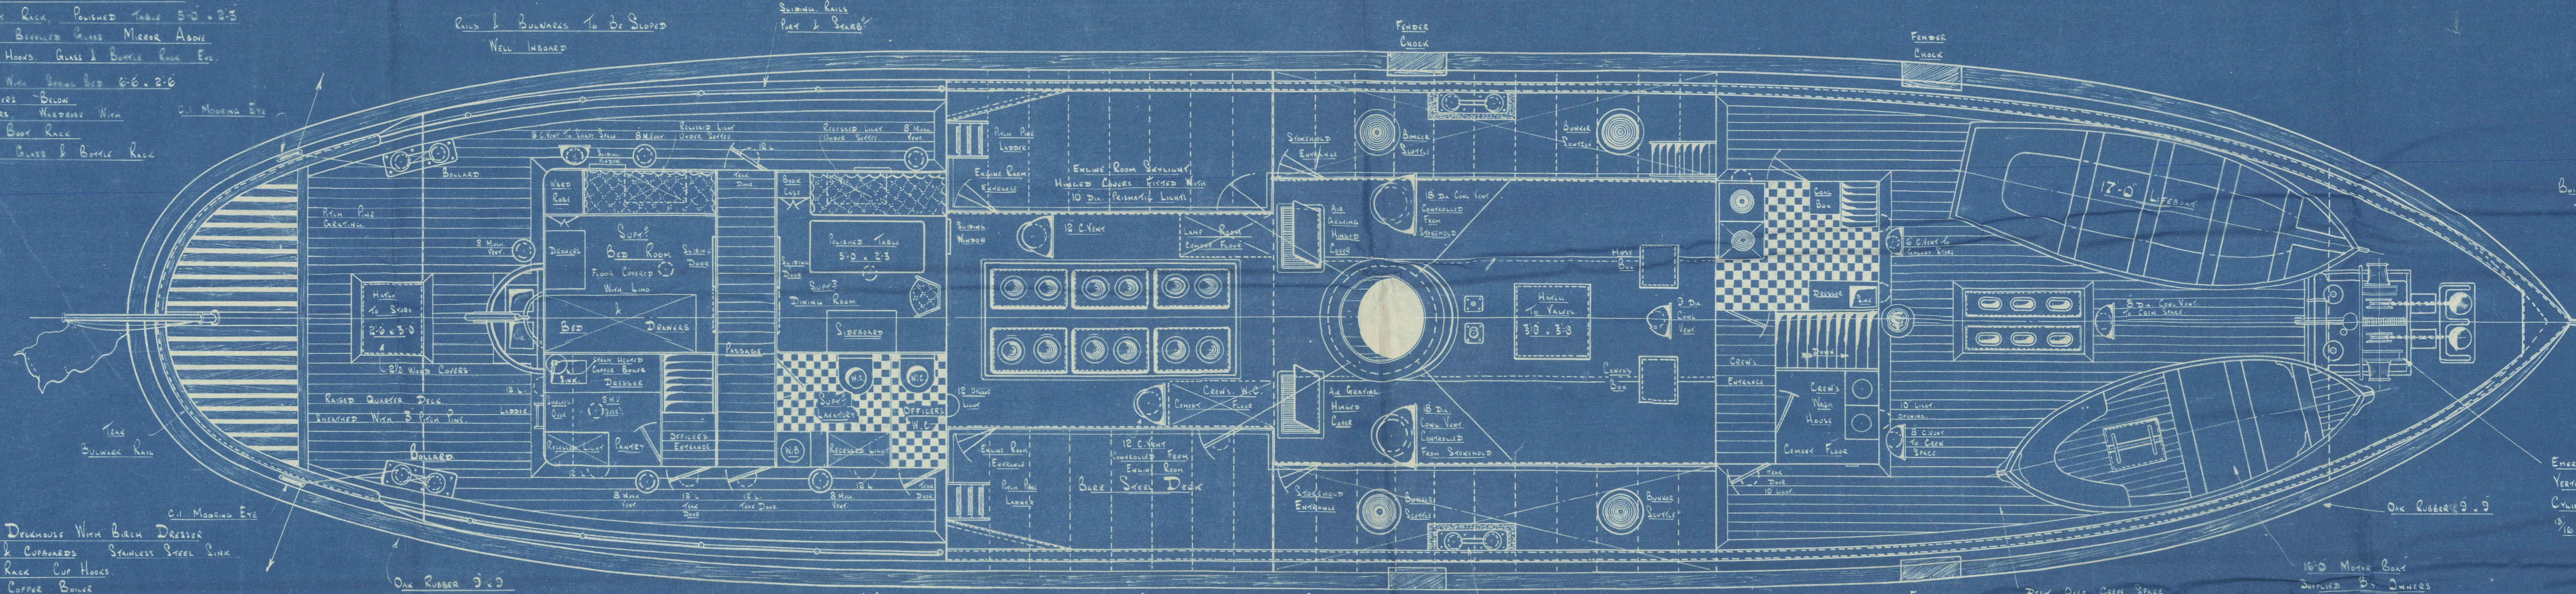

Pancrey C.I. Mooring
Fitted In Apt Deckhouse With Birch Dresser
With Drawers & Cupboards Stainless Steel Sink
Shelves Pans Rack Cutlery
Steam Heating Copper Boiler
Teak Graining On Floor

OAK RUBBER 949

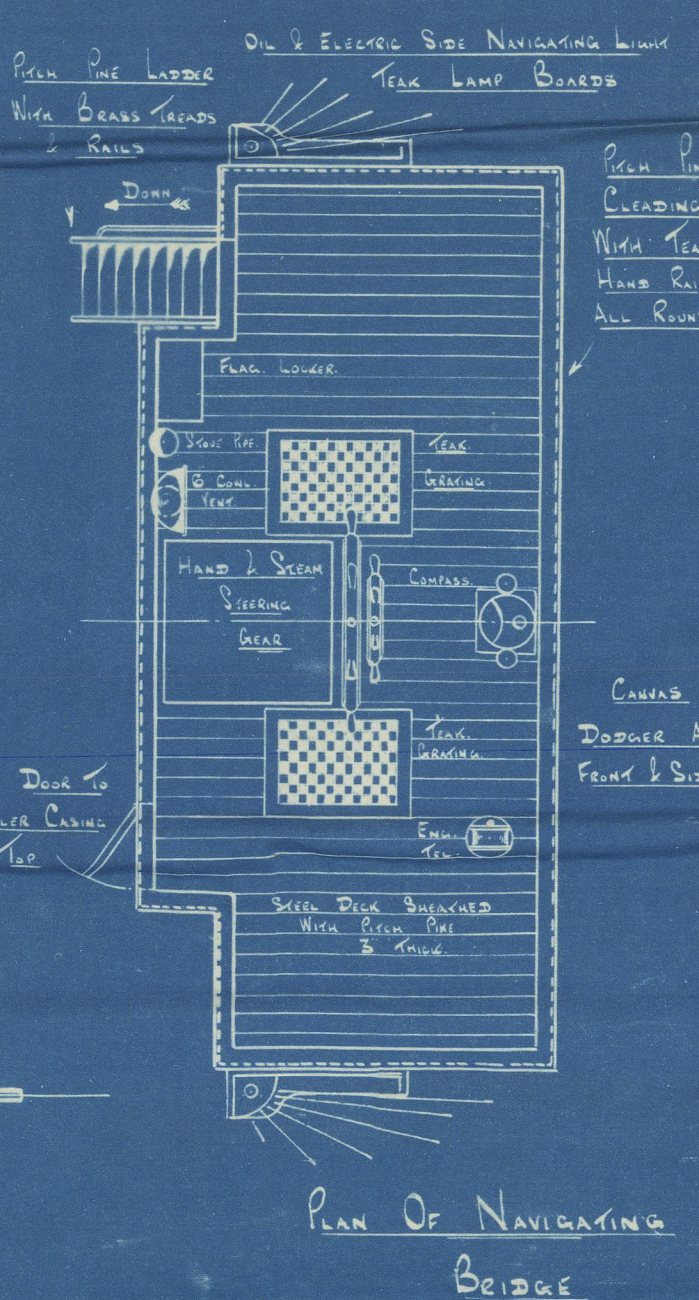

S.T. TREFOIL

W. J. YARWOOD & SONS LTD
THE DOCK
NORTHAMPTON DATED:
SHIP N° 627
DRG. N° 5041
DRAWN BY: W.H.H. CHECKED BY:
TRACED BY: W.H.H. INDEXED BY:

DIMENSIONS
LENGTH B.P. 97'-9"
BREADTH M.L.D. 22'-0"
DEPTH M.L.D. 10'-0"

Yaswood's Yard No. 624

S. S. "Yacfoil."

11

General Arrangement.

(as built)

S. S. _____

LIVERPOOL;

Report No. 112416



© 2020

Lloyd's Register
Foundation

003018-003022-0127