

EQUIPMENT NUMERAL = 3254

EQUIPMENT

- 2- 5 1/2 CWT. STOCKLESS ANCHORS
- 1- 1/2 CWT. EX. STOCK STREAM ANCHOR

120- FATHOMS OF 1 1/8" STU LINK CABLE WEIGHT ABOUT 39 CWT

75- FATHOMS OF 6 MANILLA HAWSE

90- FATHOMS OF 4 HEMP WARPS

MANILLA TOWLINE TO HAVE 3" WIRE PENNANT ATTACHED

WIRE REELS AS REQUIRED

SECURED TO DECK

STREAM WIRE 2 CIR. TEST 8.3 TONS

NOTE: DECK IN WAY OF FORW. ACCOMMODATION
TO BE SHEATHED WITH 3" PICH PINE

HEIGHT
OF
CASING
7'-0"

BULKWARK RAIL
6 x 3 x 3/8 BULG ANGLE

BULKWARKS
3'-0"

OAK RUBBER 9 x 9
RUBBER ANGLES 4 x 3 x 1/2
FENDER CHOCKS 2'-6" LONG
SHEERSTRAKE 3/4" PLATE
INCREASED TO 1/2" IN WAY OF BREAK

DEPTH
MOULDED
10'-0"

DIMENSIONS

LENGTH B.P. 97'-9"
BREADTH MLD 22'-0"
DEPTH MLD 10'-0"


PLATING

PLATING INCREASED AT BREAK OF RAISED QUARTER DECK
IN WAY OF BOSS HAWSE PIPES & SIDE LIGHTS
ALSO BOTTOM PLATING FORWARD
DOUBLING PLATES FIXED IN WAY OF MOORING EYES

LLOYD'S SCANTLING NUMERALS

L.D. = 977.5
L x (B + D) = 3128
L/D = 9.775

WIDTH OF CASING 12'-8"

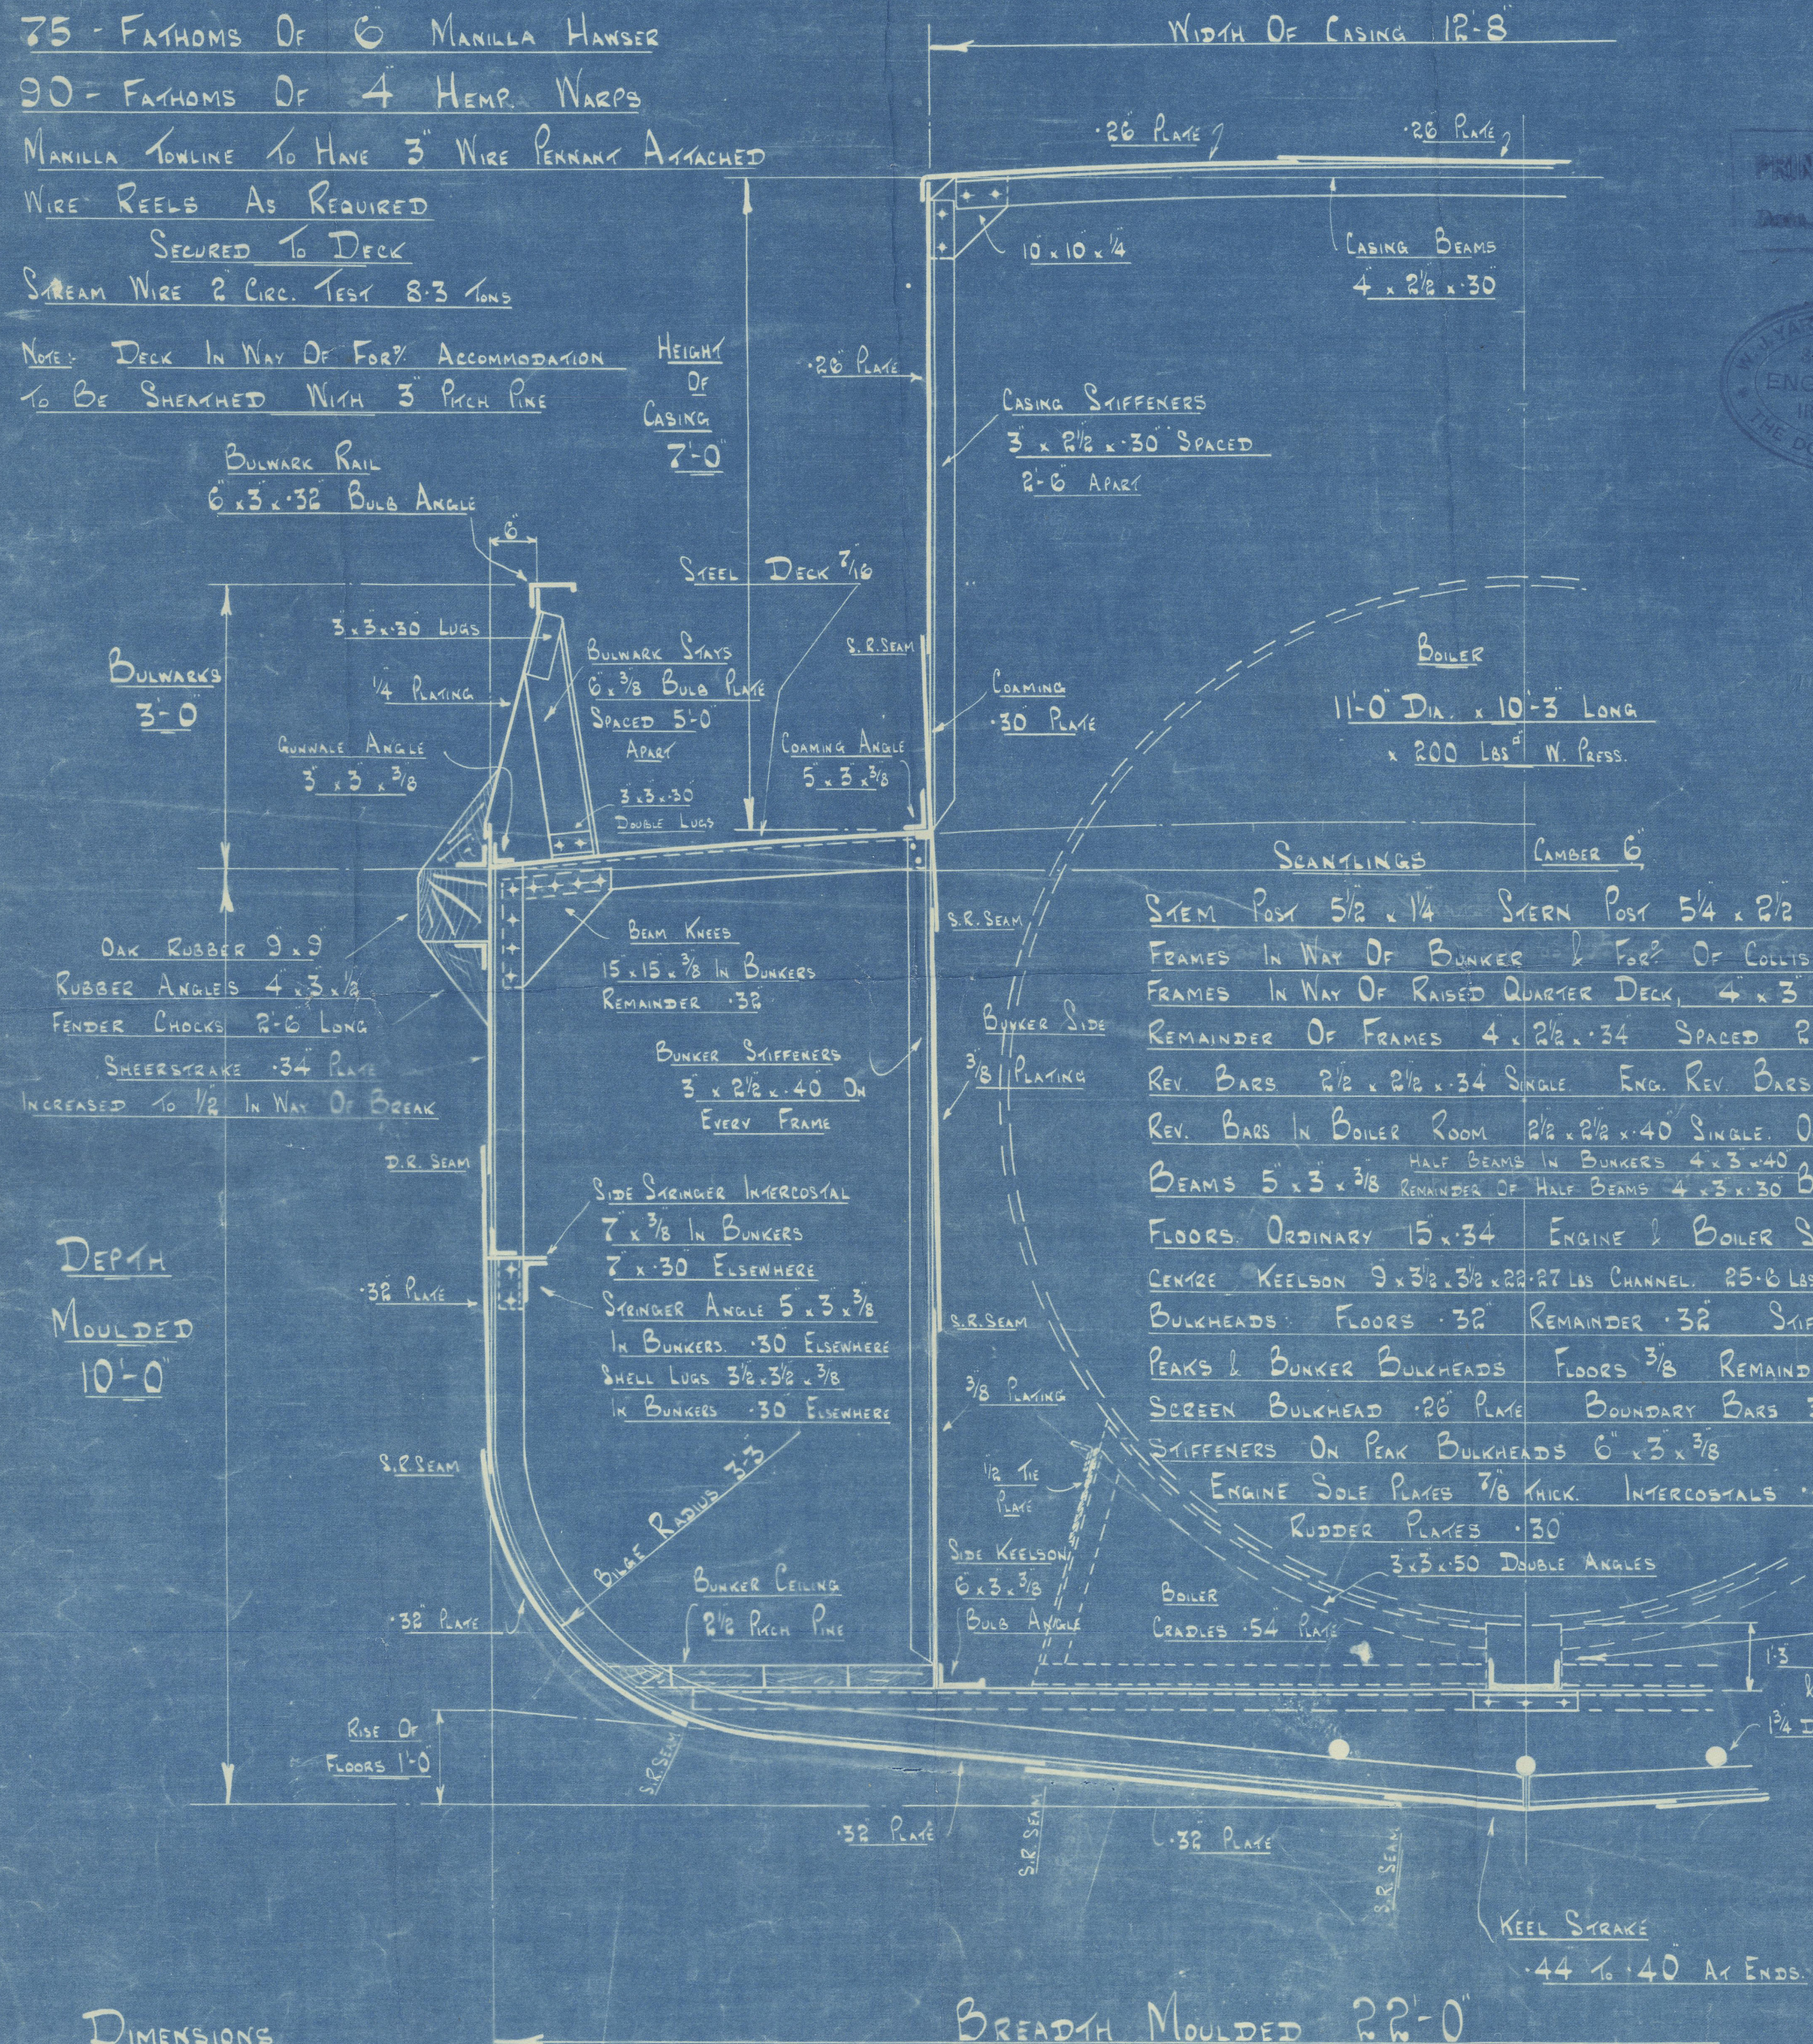

PRINT NO. 493
1-4-30


W. J. YARWOOD & SONS LTD.
SHIPBUILDERS
ENGINEERS AND
IRONFOUNDERS
THE DOCK, NORTHWICH

THE DOCK, NORTHWICH

SCANTLING

STEM POST 5/8 x 1/4 STERN POST 5/4 x 2/2 RUDDER STOCK 4/2 DIA.
FRAMES IN WAY OF BUNKER & FORW. OF COLLISION BULKHEAD 4 x 2 1/2 x 40
FRAMES IN WAY OF RAISED QUARTER DECK, 4 x 3 x 40
REMAINDER OF FRAMES 4 x 2 1/2 x 34 SPACED 21" APART
REV. BARS 2 1/2 x 2 1/2 x 34 SINGLE ENG. REV. BARS 3 x 3 x 40 DOUBLE
REV. BARS IN BOILER ROOM 2 1/2 x 2 1/2 x 40 SINGLE ON BOILER STOODS 3 x 3 x 40 DOUBLE
BEAMS 5 x 3 x 3/8 HALF BEAMS IN BUNKERS 4 x 3 x 40 REMAINDER OF HALF BEAMS 4 x 3 x 30 BEAM KNEES 15 x 15 x 3/8
FLOORS ORDINARY 15 x 34 ENGINE & BOILER SPACE 40
CENTRE KEELSON 9 x 3/2 x 3/2 x 22 27 LBS CHANNEL 25-6 LBS IN BOILER ROOM
BULKHEADS FLOORS 3/8 REMAINDER 3/8 STIFFENERS 3 1/2 x 2 1/2 x 40
PEAKS & BUNKER BULKHEADS FLOORS 3/8 REMAINDER 3/8
SCREEN BULKHEAD 2/8 PLATE BOUNDARY BARS 3 x 3 x 4
STIFFENERS ON PEAK BULKHEADS 6" x 3 x 3/8
ENGINE SOLE PLATES 7/8 THICK INTERCOSTALS 40" THICK
RUDDER PLATES 30
3 x 3 x 50 DOUBLE ANGLES
BOILER CRADLES 54 PLATE
1/2" BETWEEN BOTTOM OF BOILER & TOP OF FLOORS
3/4" DIA LINGER

BREADTH MOULDED 22'-0"

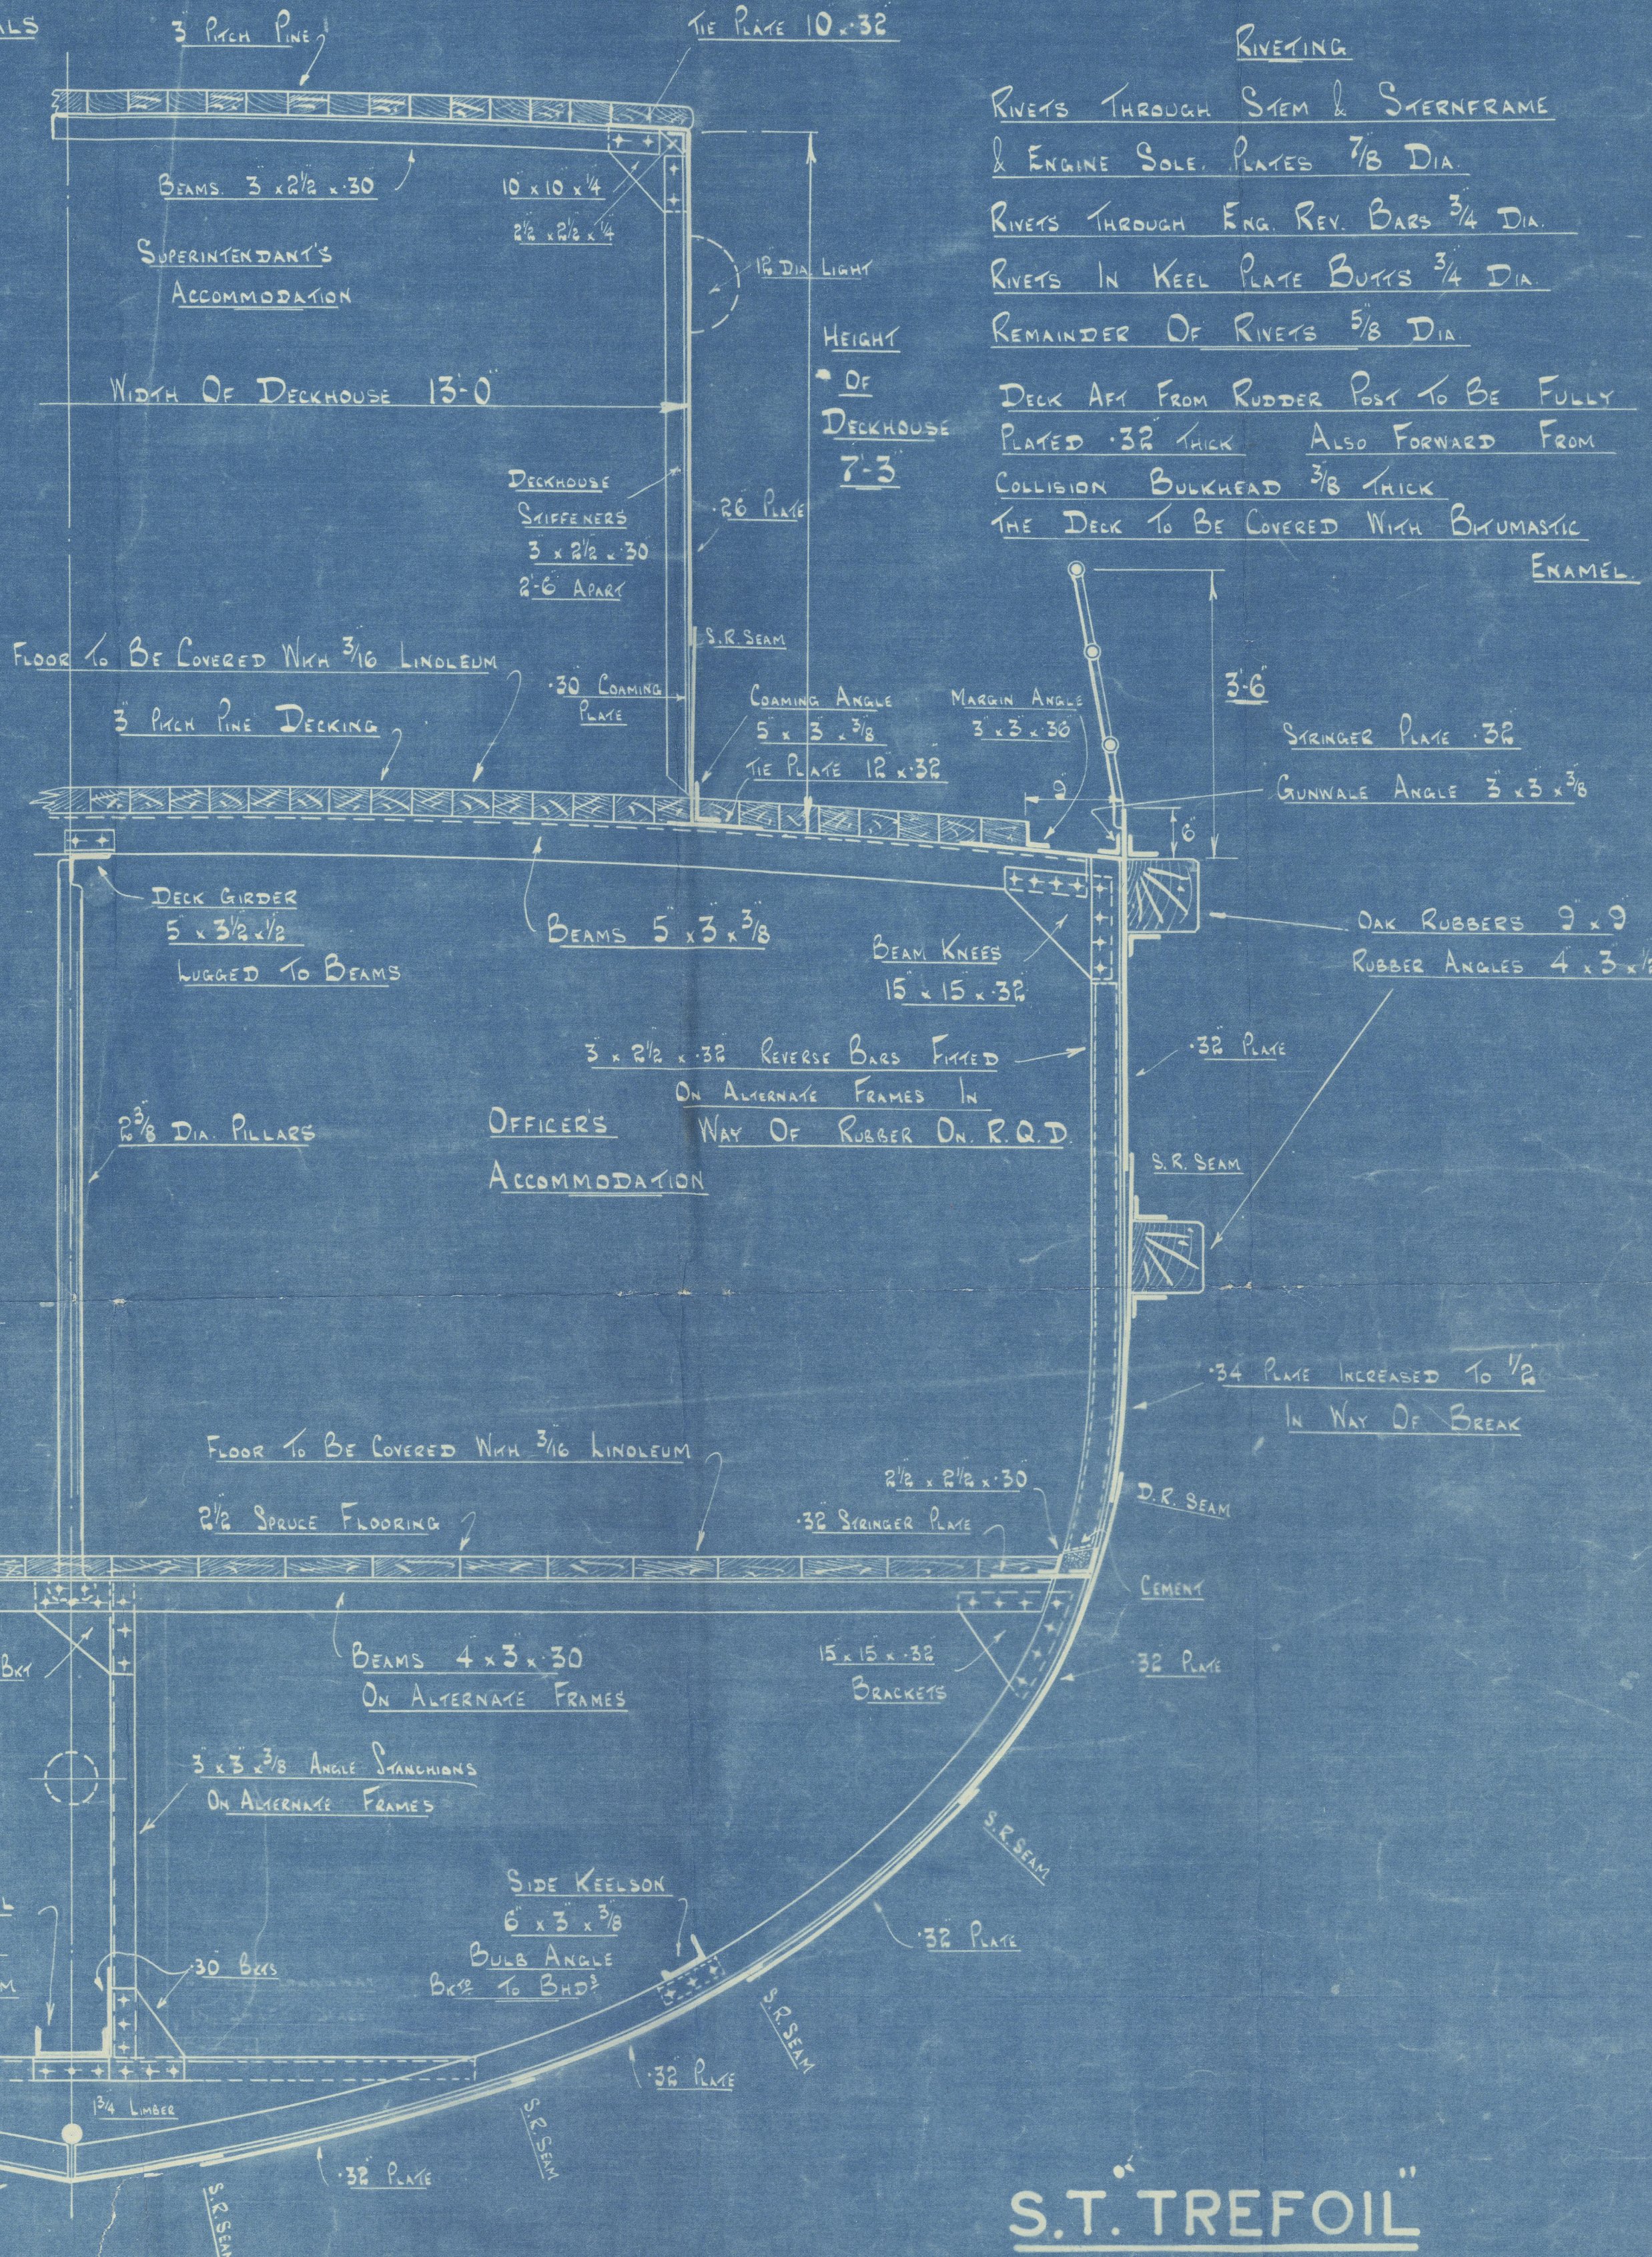

S.T. TREFOIL

SECTIONS FOR SINGLE SCREW STEAM TENDER

TO LLOYD'S CLASS + 100 A.I. FOR TENDER & TOWING SERVICES
SCALE 3/4" = 1 FOOT

APPROVED BY LLOYD'S 2-2-38

W. J. YARWOOD & SONS LTD.	
THE DOCK	NORTHWICH
DATE 11-1-38	
SHIP NO. 627	
DRG. NO. 4889	
DRAWN BY N.H.H.	CHECKED BY
TRACED BY N.H.H.	INDEXED BY

Lloyd's Register
of Shipping

Yamwoods Yard No 624.

S. S. Yrefait

1

Midship Section.
~~XXXXXXXXXXXXXXXXXXXX~~ ~~XXXXXXXXXXXXXXXXXXXX~~

(as built.)

S. S.

LIVERPOOL

Report No.

112416



© 2020

Lloyd's Register
Foundation

003018-003522-0129