

# M.V. "BENEDICK".

## MIDSHIP SECTION.

SCALE  $\frac{1}{2}$ " = 1 FOOT.

DIMENSIONS:- 430'0" x 58'0" x 22'9" MOULDED TO UPPER DECK.

### LLOYDS NUMERALS.

L x D	=	14065
L x CB + D	=	39005
L/D	=	13.14
d	=	20.96

2 TRANSVERSES IN EACH TANK SPACED 10'0" x 18'0" x 10'0"  
ORDINARY TRANSVERSE FRAMING AFT-FOOD OF MAIN OIL TANKS.

### EQUIPMENT NUMERAL.

L x (CB + D)	=	39005
POOP 99'0" x 7'5" x 7'5"	=	557
BIDGE 30'0" x 7'5" x 7'5"	=	149
FUSEL 39'75" x 7'5" x 7'5"	=	224
CASING 70'0" x 7'5" x 50"	=	264
MID. HOLE 270'0" x 7'5" x 50"	=	101
	=	40230

### EQUIPMENT

2 BOWER ANCHORS EACH 68 CWT.	}	COLLECTIVE WT. 194 1/2 CWT.
1 " " 58 1/2 " "		
1 STREAM ANCHOR 19 CWT. (EX STOCK)		
270 FATHOMS 2 1/8" STUD CHAIN CABLE		
90 FATHOMS STEEL WIRE 5" CIRC. (STREAM)		
120 " " 5 1/4" (TOWLINE)		
2 AT 90 FATHOMS STEEL WIRE 2 1/2" (ANCHORS)		
2 " 90 " " 2 1/2" (WIRDS)		

### FORGINGS ETC.

STEM BAR	10'2 1/8"
RUDDER FRAME FORGED STEEL	7'8 1/2"
STERNFRAME " "	10'2 1/8"

### RYETING:- SHELL LONGITUDINALS.

LONGITUDINALS 12, 3" x 4" RIVETS THRO' SHELL 6 DIAM. APART.  
LONGITUDINALS 5, 6, 7, 8" RIVETS THRO' SHELL AND LONGITUDINALS  
SPACED 4 1/2 DIAM. APART FOR 9 RIVETS EACH SIDE OF TRANSVERSES  
+ BULKHEADS. TO BE SPACED 6 DIAM. ELSEWHERE.  
LONGITUDINALS 9, 10, 11" RIVETS THRO' SHELL SPACED 3 1/2 DIAM.  
APART FOR 9 RIVETS EACH SIDE OF TRANSVERSES + BULKHEADS  
TO BE SPACED 6 DIAM. ELSEWHERE.  
IN LONGITUDINALS 12-22 INCLUSIVE RIVETS SPACED 3 1/2  
DIAM. APART 10 RIVETS EACH SIDE OF TRANSVERSE + 8 RIVETS  
EACH SIDE OF BULKHEADS. 6 DIAM. ELSEWHERE.  
IN LONGITUDINALS ON PLAT OF BOTTOM NO. 1 TANK  
RIVETS SPACED 4 1/2 DIAM. APART.

### CR. LINE BULKHEAD LONGITUDINALS.


IN LONG. 1-4 INCLUSIVE RIVETS THRO' BHD + LONGITUDINALS  
SPACED 6 DIAM. APART.  
IN LONG. 5-8 INCLUSIVE RIVETS THRO' BULKHEAD + LONG. 4 1/2  
SPACED 4 1/2 DIAM. APART FOR 9 RIVETS ON EACH SIDE  
OF TRANSVERSES + BULKHEADS TO BE SPACED 6 DIAM. ELSEWHERE.  
IN LONGITUDINALS 9, 10, 11" RIVETS THRO' BULKHEAD + LONGITUDINALS  
SPACED 3 1/2 DIAM. APART FOR 9 RIVETS ON EACH SIDE OF  
TRANSVERSES AND BULKHEADS. 6 DIAM. ELSEWHERE.

### BILGE KEEL.

TO EXTEND 200'0" AMIDSHIP. RIVETS THRO' TEE BAR TO  
SHELL SPACED 5 DIAM. APART. RIVETS THRO' BULB  
PLATE SPACED 6 DIAM. APART.

### NOTE:-

DRAIN HOLES 7/8" DIAM. SPACED 12" APART ARRANGED ON  
ALL LONGITUDINALS + BULKHEAD STIFFS.

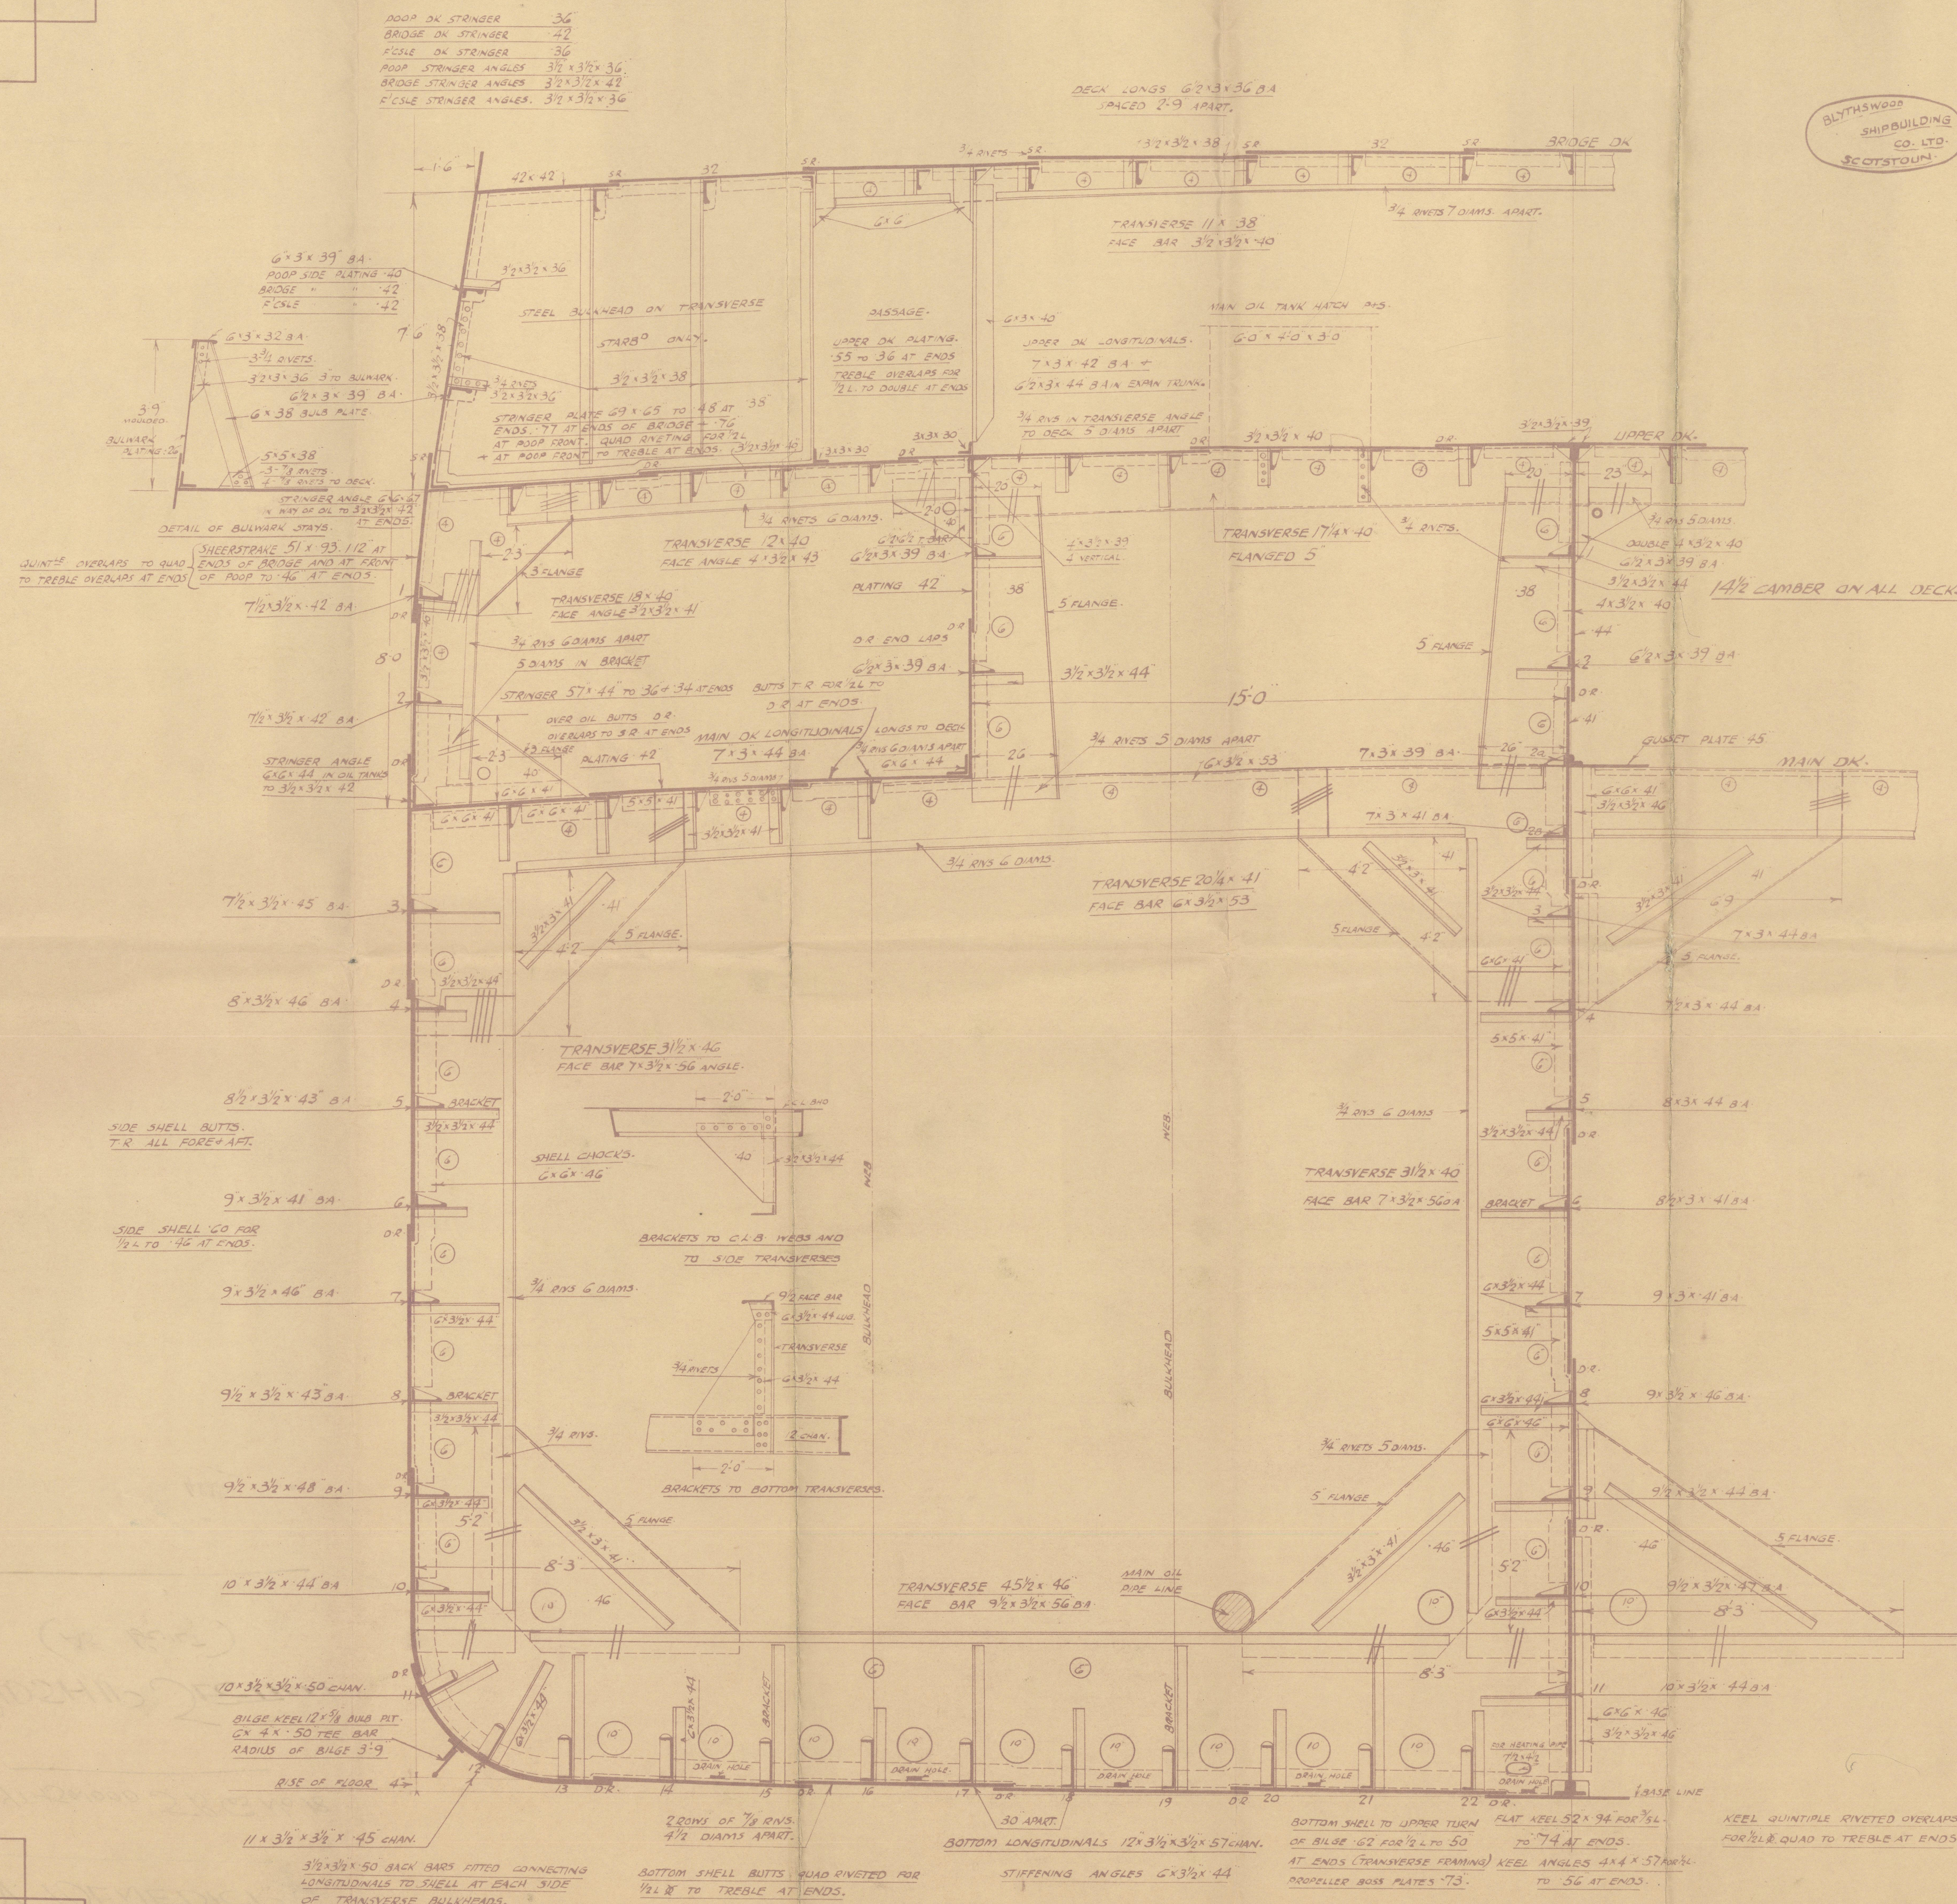

M<sup>r</sup>. BENEDICK \*

BLITHSWOOD J.R. 65 No 18

MIDSHIP SECTION.  
(AS BUILT)

---

GLASGOW REPORT No. 48335.



© 2020

Lloyd's Register  
Foundation

003046-003055-0001