

FART ICKE ÖVERSTIGANDE 14,5 KNOP.
 TOTAL RÖDERAREAN = ~~17,410~~ m²
 TYNGDPUNKTÅNSTÅND = ~~713~~ mm
 100 × A/D = 100 × ~~11,4~~ × 0,713 = ~~1335~~

KOPPL. TILL	
M/S "FORMOSA".	
ÄNDRING AV RÖDER.	
RIT. 1 GR	SKALA 1:20 1/5
KOP. 1 GR	19.5.49
ERIKSBERGS MEK VERKSTÄDS AB	
GÖTEBORGS	
BEST.N.	RIT.N. 48,741

19.5.49.

"FORMOSA"

RPT. No. GOT 16711



© 2021

Lloyd's Register
Foundation

003065-003074-0090


Surv. copy

GOTHENBURG REPORT No. 16711.

gothenburg report n

*Alks. b Rudder,
m/s 'Formosa'*

Ericksbergs Mek. Verkst. AB

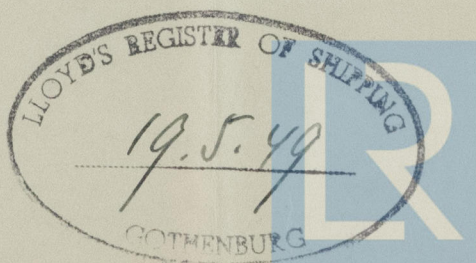

© 2021

Lloyd's Register
Foundation