

# MIDSHIP SECTION.

S. S. "BAC TRIA".

LLOYDS 100 A.I. CLASS.

SCALE 1/2" = 1 FOOT.

## PRINCIPAL DIMENSIONS.

LENGTH B.P. 272'0"  
BREADTH EXTREME 46'0"  
" MOULDED 44'6"  
DEPTH MID UPPER DK. 22'6"  
DEPTHS TO LENGTH (UPPER DK.) 12'98"  
" " (BRIDGE) 9'65"


## NUMERALS.

D. 22'5" d. 11'8"  
D.L. = (22.5 x 272) = 6570.  
(B+D) x L = (44'5" + 22'5") x 272 = 19637.  
ERECTOR'S = 55% OF L

## EQUIPMENT NUMERALS.

(B+D) x L = 19637.  
BRIDGE 18'6" x 7'15" x 75 = 748.  
FORECASTLE 18'25" x 7'15" x 75 = 164.  
CASING ETC 7'45" x 7'5" x 5 = 268.

EQUIPMENT NO 20817.

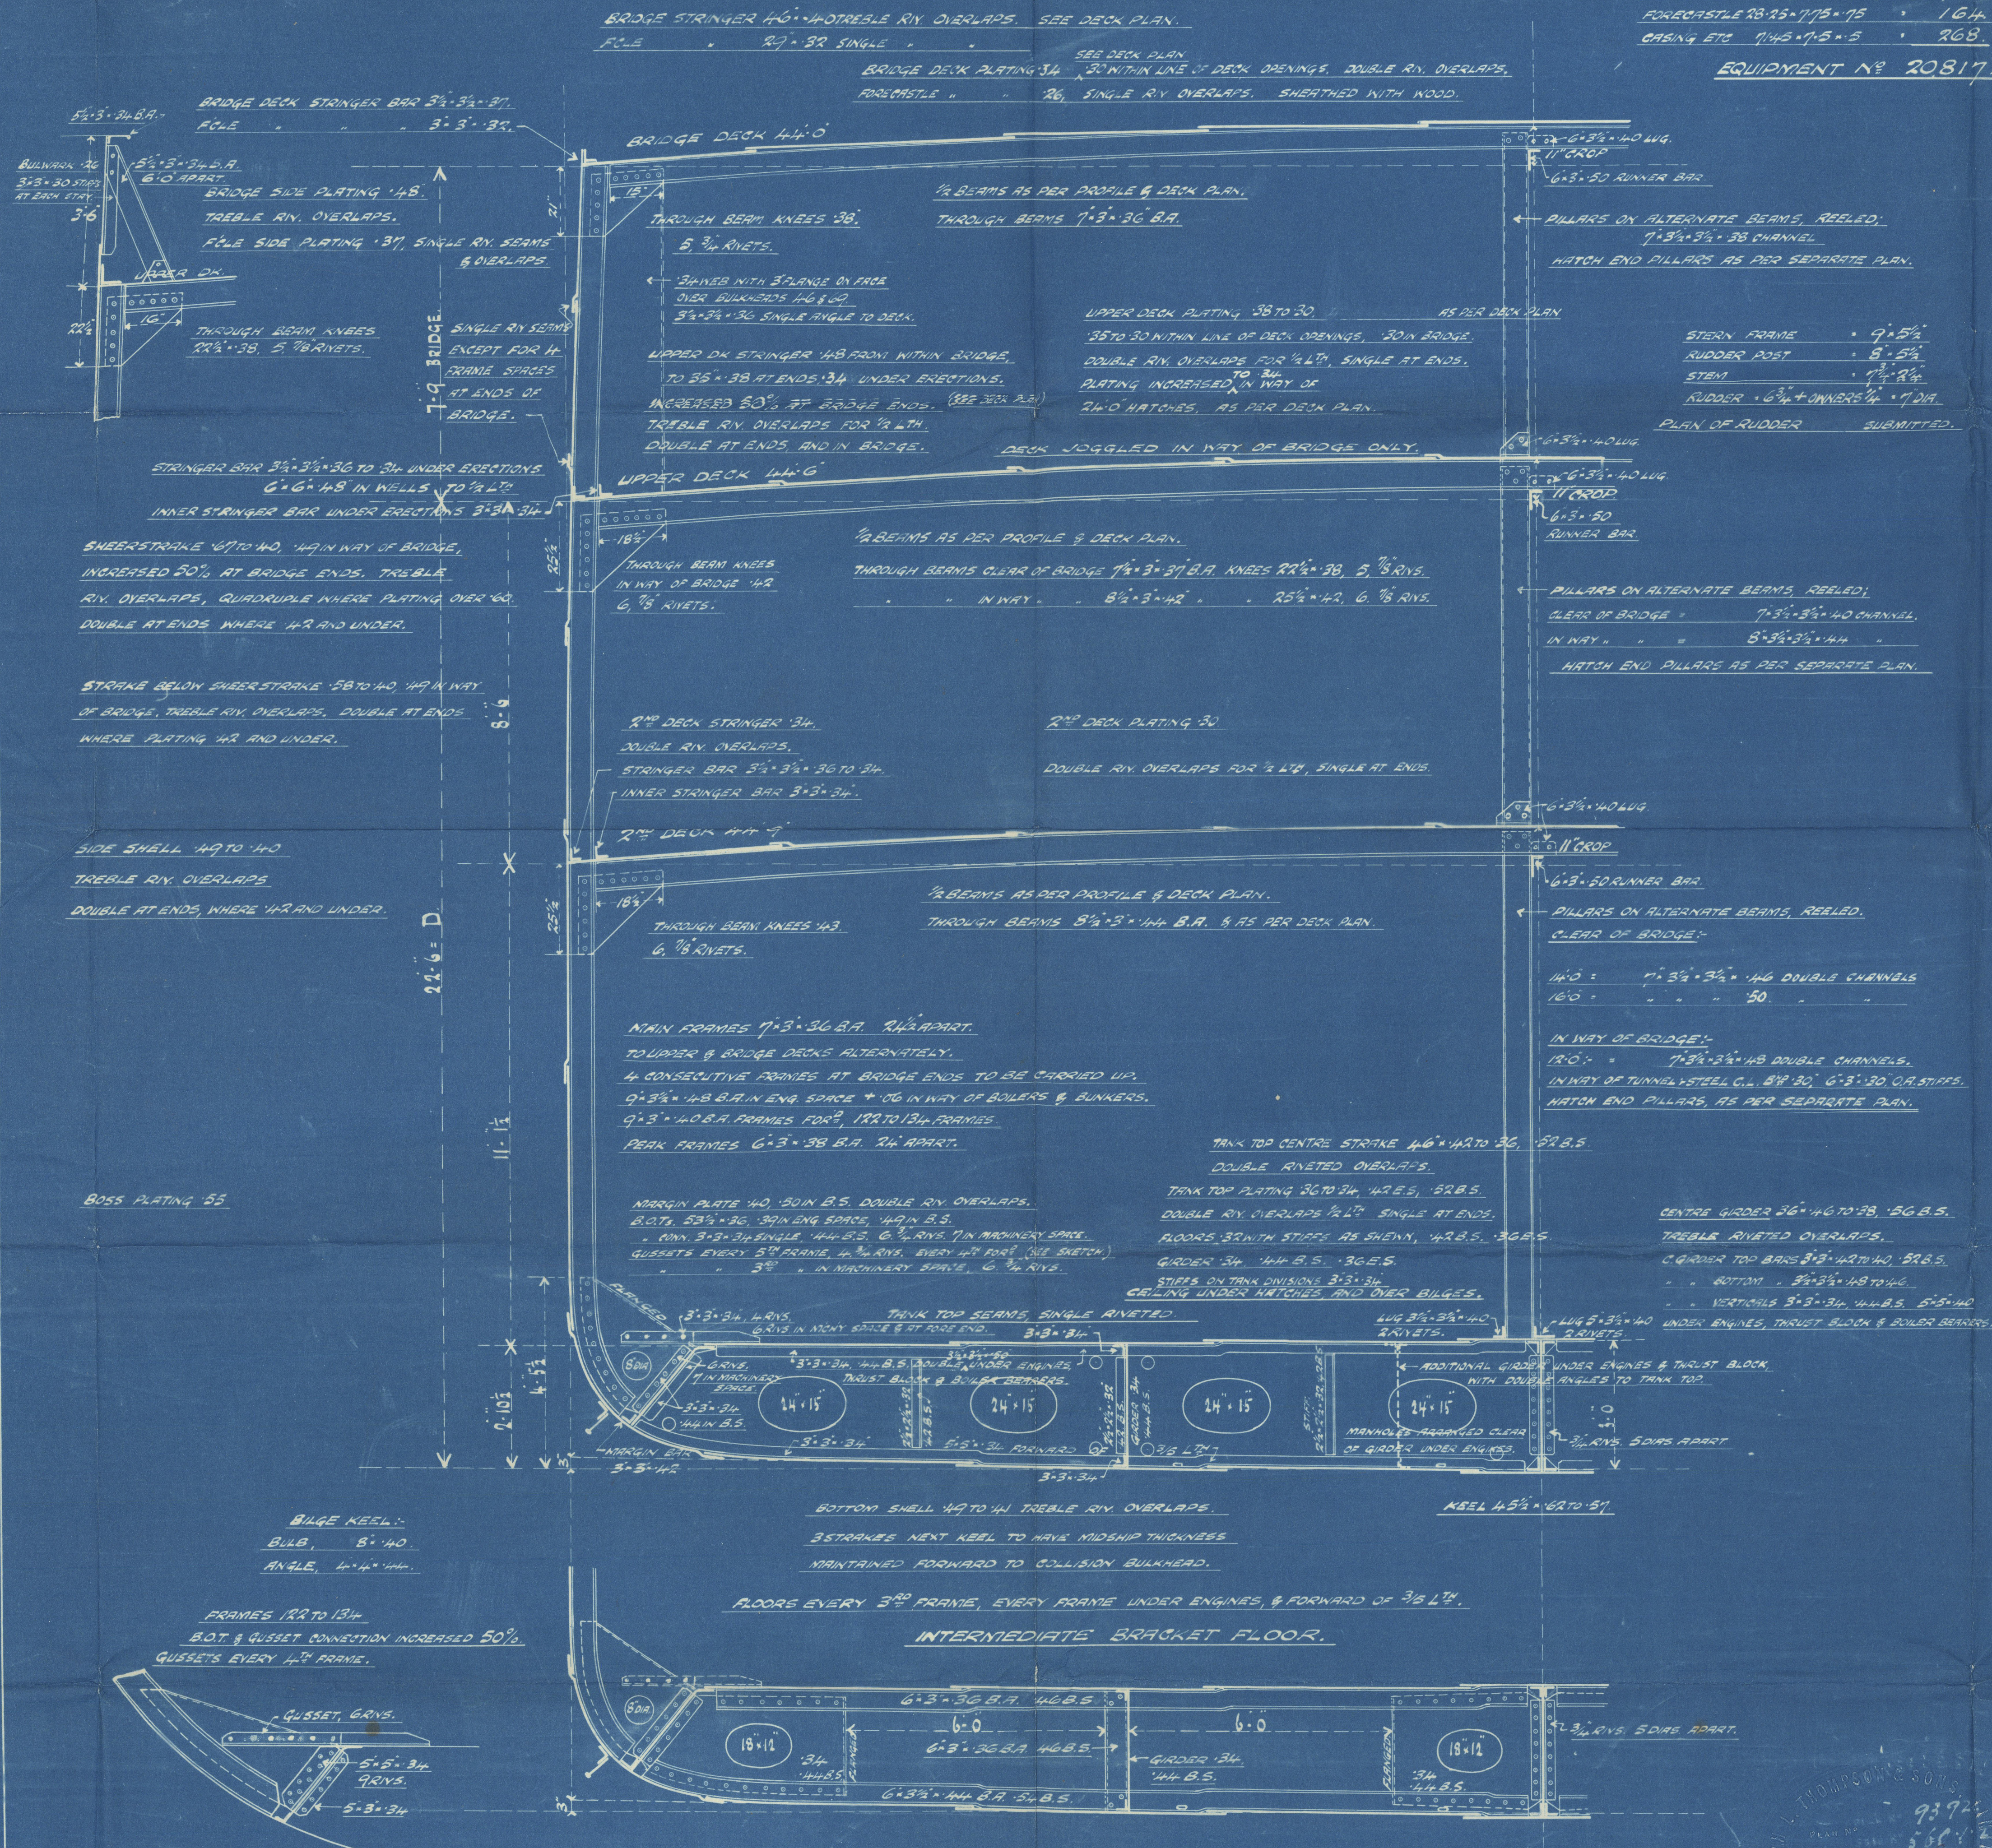

THOMPSON'S  
9372  
PLAN NO. 560.12.3  
SHIP NO. 774129-25  
DATE 1912  
SUNDERLAND



Sunderland.

J. L. Thompson & Sons.

- N<sup>o</sup>. 561 - M/M 3336

S.S. "BACTRIA."

Midship Section.

(-as built)



SUNDERLAND RPT. NO: 29710.

~~PLANS TRANSFERRED  
TO SISTER VESSEL~~

~~Capetan~~

~~Manolis~~



© 2020

Lloyd's Register  
Foundation

005333-005340-0073