

S.S. ROBILLANTE  
EX.  
**S.S. WAR PROJECT.**

# MIDSHIP SECTION.

411' 6" B.P. x 55' 5 1/2" M.L.D. x 38' 1 1/2" M.L.D. TO SHELTER DECK.

TO CLASS 100 A.I. LLOYDS 'SHELTER DECK'  
WITH SPECIAL NOTATION DESIGNATING TYPE OF BILGE.

£ B.S. \* BRITISH CORPORATION.

SCALE 1/2" = 1 FOOT.

## EQUIPMENT NUMBER.

HULL	- 35216
TWEEN DECK 411' 5" x 8' 7 1/2" =	2270
CASING 65' 10" x 7' 5" x 5" =	245
HOUSE 38' 11" x 8' 0" x 5" =	126
FOUL 40' 3" x 7' 5" x 7 1/2" =	2276
EQUIPMENT	40335
2 BOWER ANCHORS 68 CWTs STOCKLESS	
1 " 58 1/2 " STOCKLESS	
1 STREAM " 19 " EX. STOCK	
270 FATHOMS 2 5/16" STND CHAIN CABLE	
90 " 1 5/8" STREAM CHAIN OR 5" S.W. ROPE	
120 " 15" HEMP OR 5 1/4" S.W. ROPE TOWLINE	
2 OFF 90 " 8" HEMP HAWSERS OR 2 3/4" S.W. ROPE	
2 OFF 90 " 7" " 2 1/2" S.W. ROPE	

## LLOYD'S NUMBERS.


B = 55' 5 1/2"  
D = 30' 1 1/2"  
85' 7" = 85.583 - TRANS. N°  
L = 411' 6" = 411.5  
35216 = LONG. N°

L { SHELTER DECK = 10.78  
D { UPPER DECK = 14.3

38' 1 1/2" DEPTH MILD.  
9' 4 3/4" TWEEN DECKS.  
28' 8 3/4" " "  
3' 7 3/4" TANK.  
25' 1" " "  
- 7 1/2" { 1/2" DIFF. OF RULE  
3 APP'D TANK BRACKET  
24' 5 1/2" " "

## SECTIONS USED.

0.4	B.4.
7' x 7'	10' x 3 1/2"
5' x 5'	9' x 3 1/2"
OR 4 1/2' x 4 1/2'	
9' x 4'	
4' x 4'	
6' x 3 1/2"	
3 1/2' x 3 1/2"	
3' x 3'	

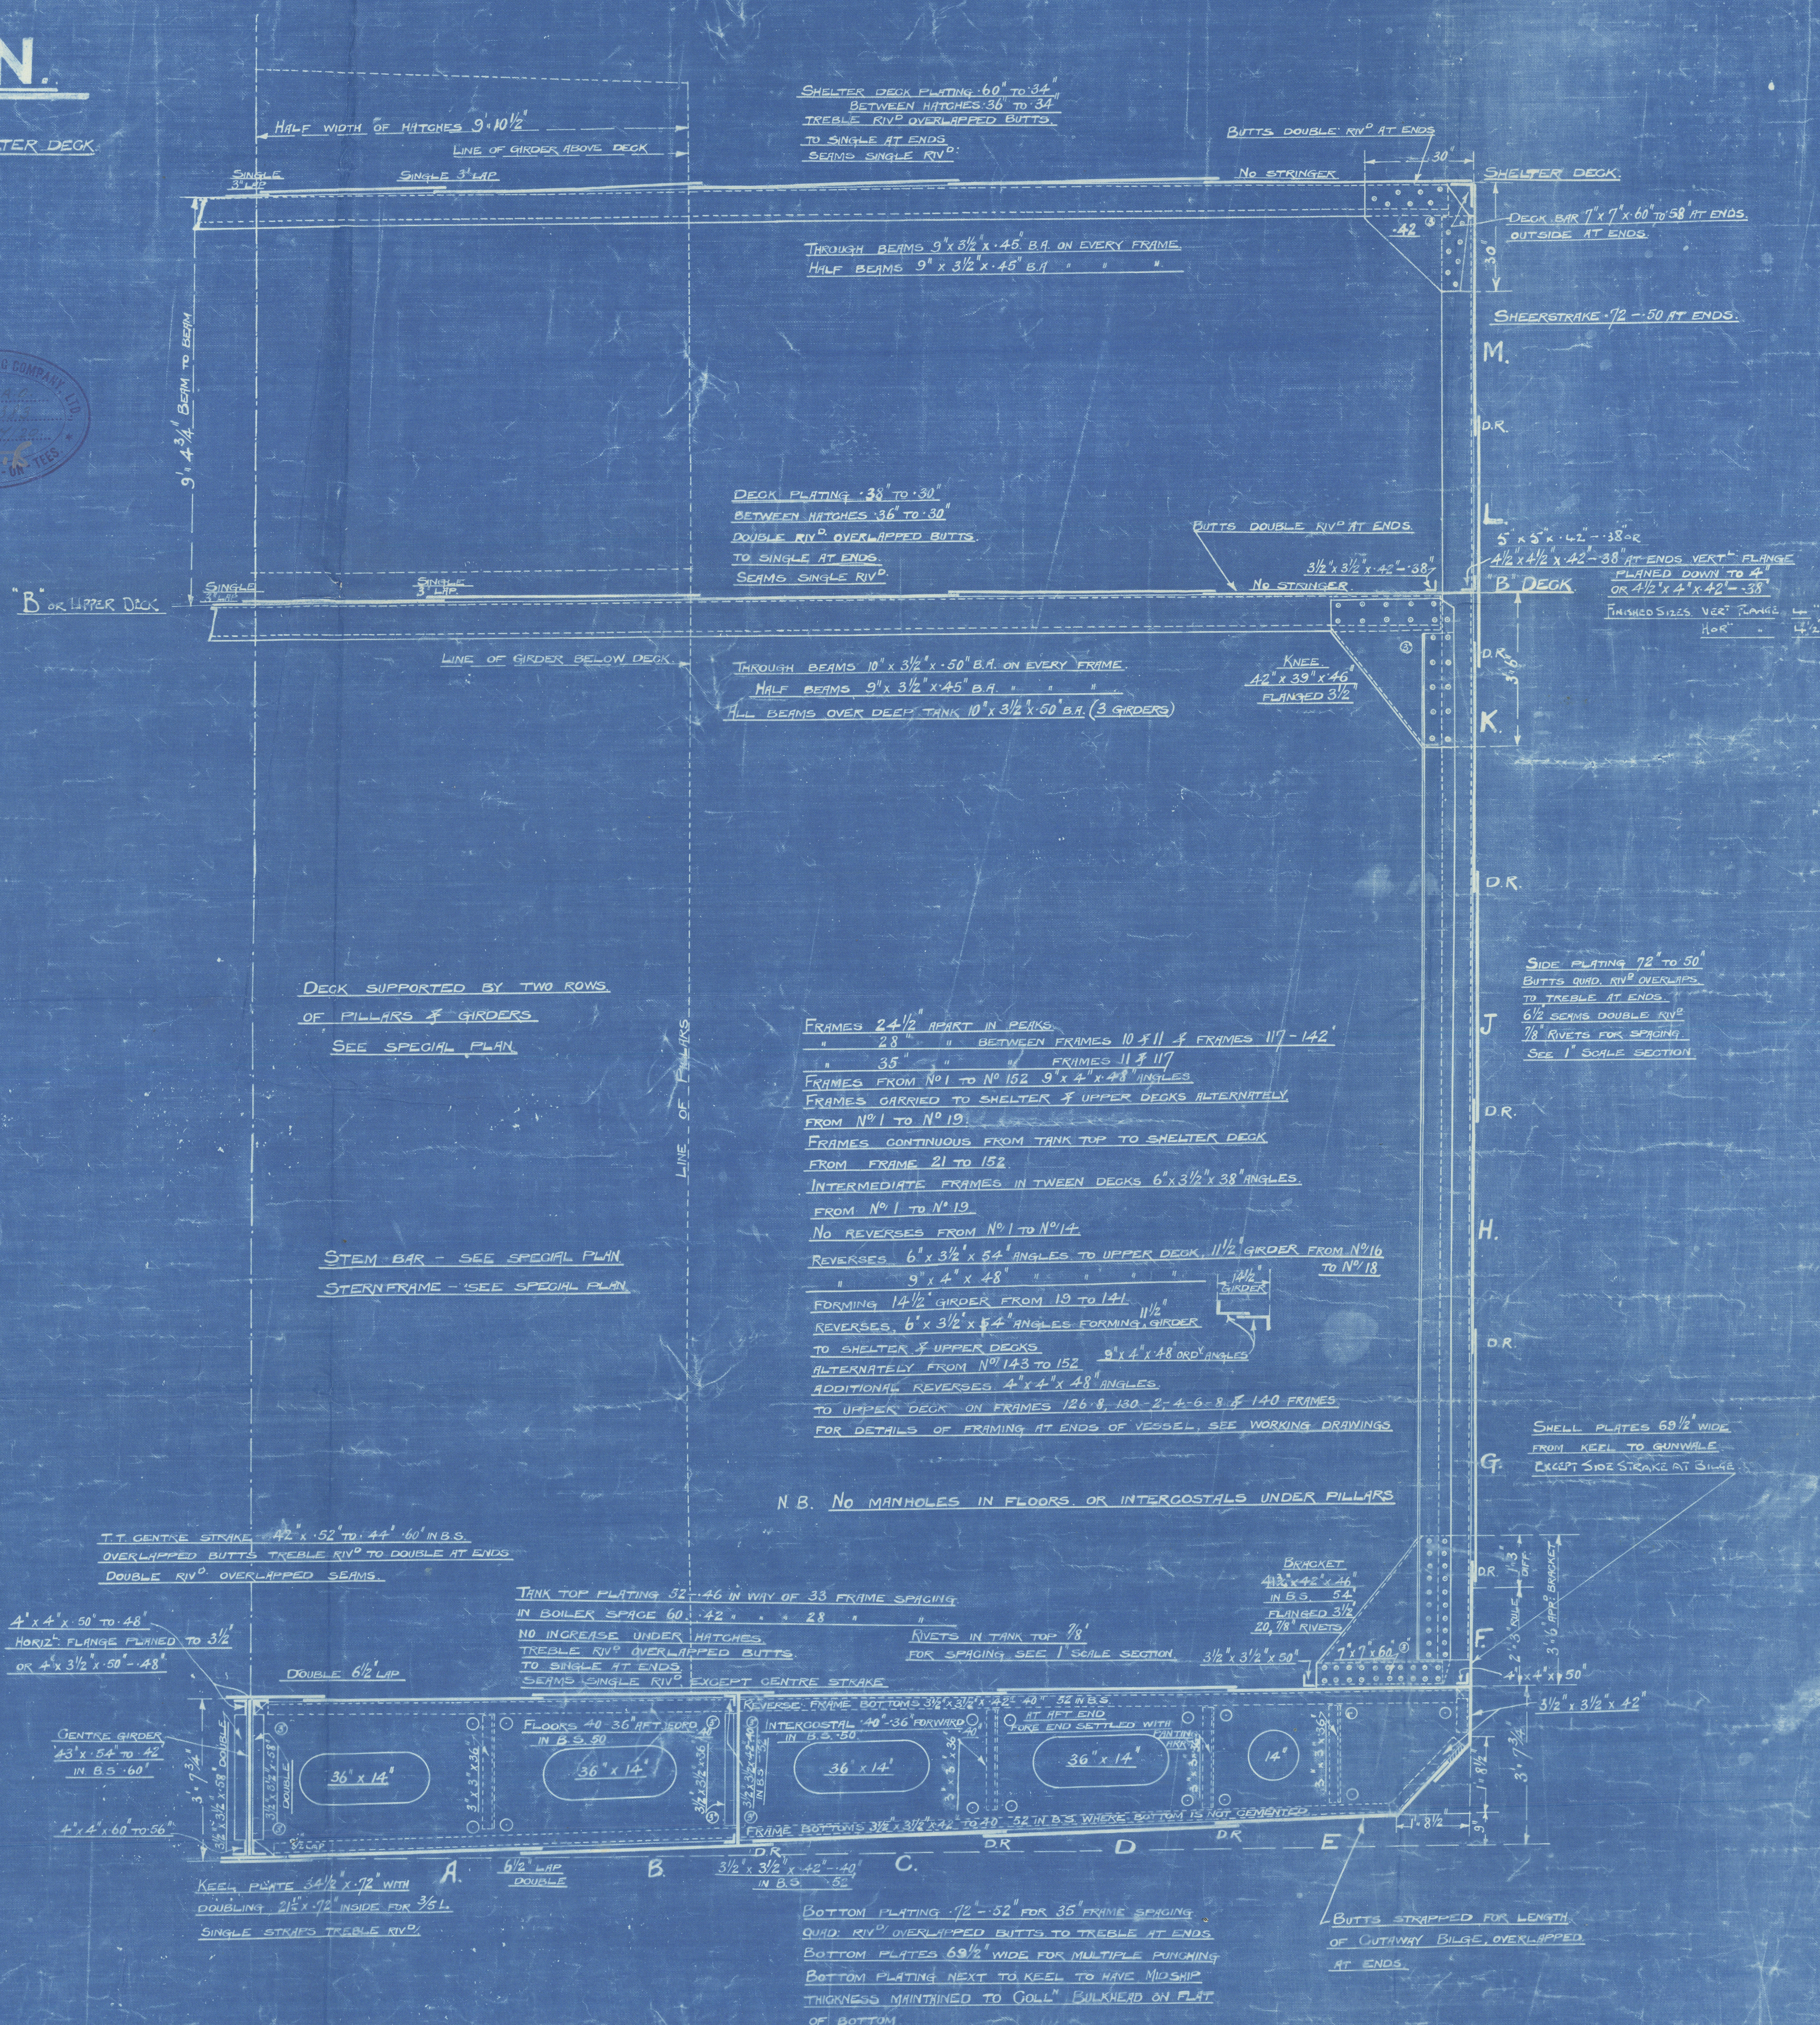



Arch. Junes 1868

Nº 14.

MIDSHIP SECTION

AS BUILT

S.S. WAR PROJECT

NOW NAMED

"ROBILANTE"

Arch Rpt. No 10763.

© 2020  
FOR ENCLOSURE TO

*Hayes*

*Middlesbrough*

From FURNESS SHIPBUILDING CO. LD.  
HAYERTON HILL-ON-TEES.

0001 3/4