


S.S. No 252. MIDSHIP SECTION.

LENGTH B.P. 331'-0", BREADTH M.P. 46'-6", DEPTH M.D. 25'-6"

CLASS 100 A.L. LLOYDS

SCALE 1" = 1' FOOT.

	POOP	FORECASTLE
SIDE PLATING	36"	38"
STRINGER PL.	32" x 32"	32" x 32"
" ANGLE	3" x 3" x 32"	3" x 3" x 32"
DECK PLATING	25"	30"
BEAMS	7" x 3" x 36 BA	8" x 5" x 44 BA
BEAM KNEES	20" x 40"	20" x 40"
PILLARS	2 3/4"	2 3/4"

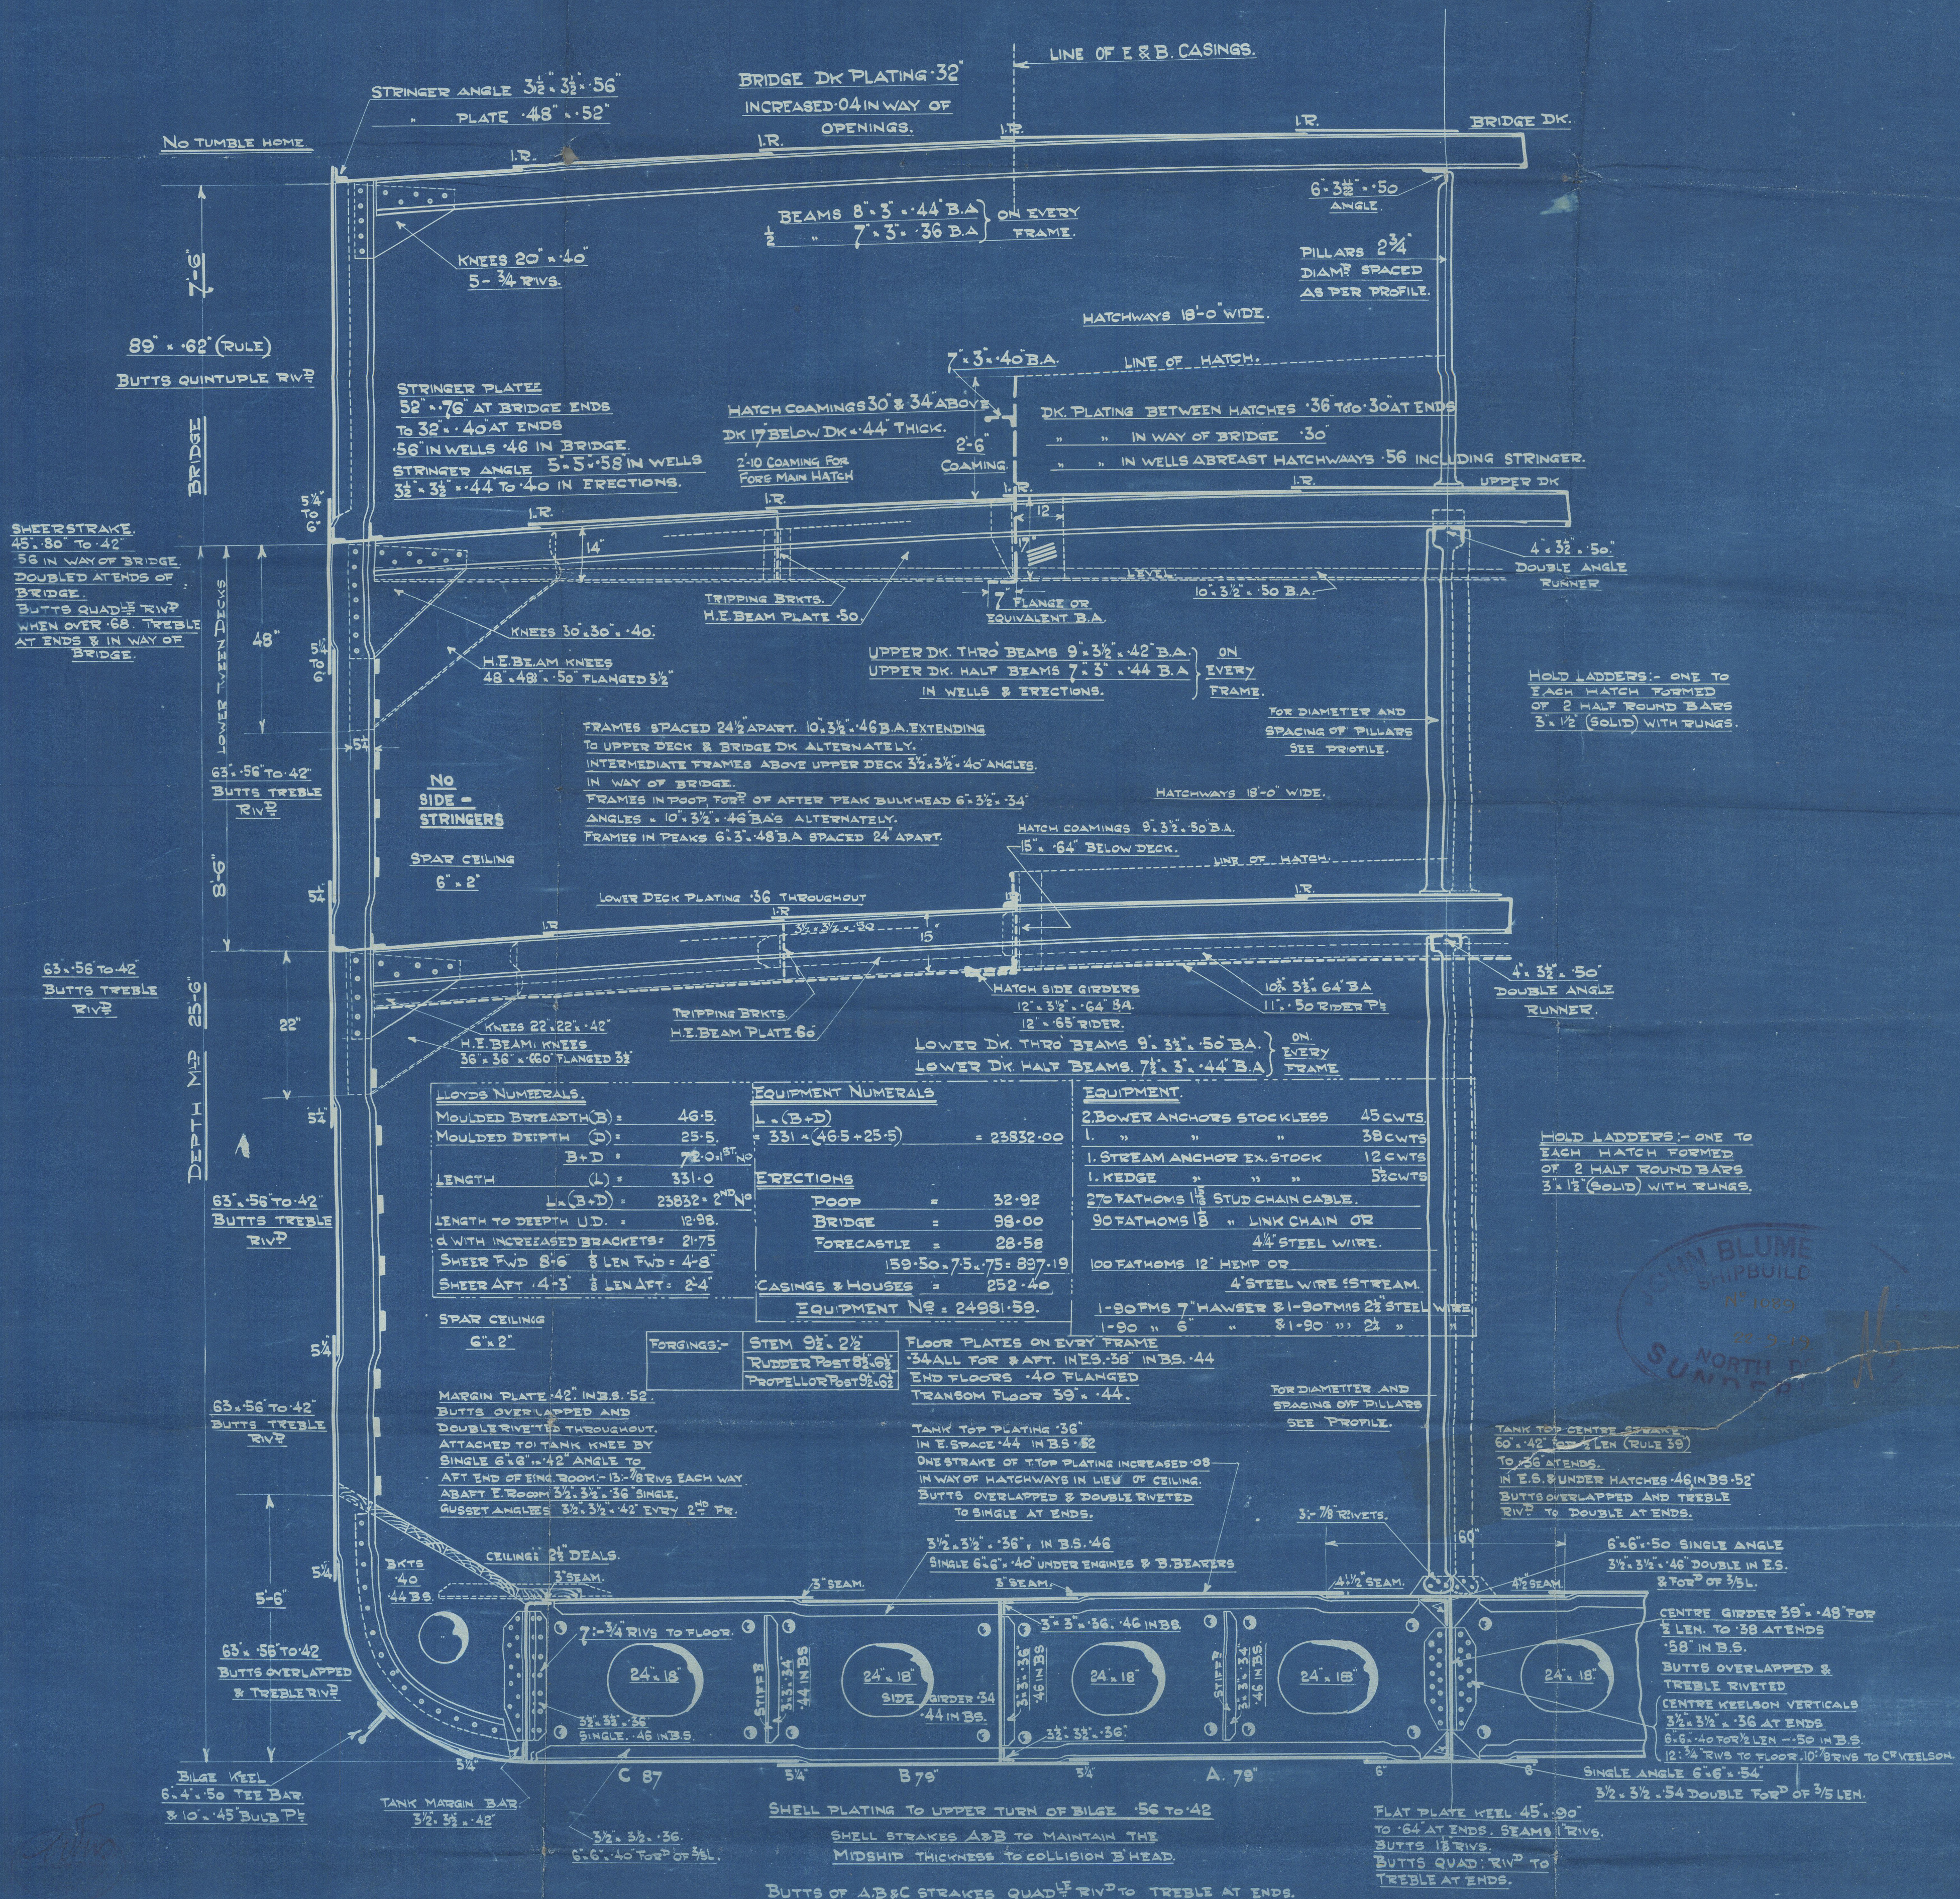

LLOYD'S NUMERALS.	
Moulded Breadth (B) =	46.5
Moulded Depth (D) =	25.5
B + D =	72.0
LENGTH (L) =	331.0
L x (B + D) =	23832.2
LENGTH TO DEPTH U.D. =	12.98
CL WITH INCREASED BRACKETS =	21.75
SHEER FWD 8' 6" 8' LEN FWD =	4'-8"
SHEER AFT 4' 3" 8' LEN AFT =	2'-4"


EQUIPMENT NUMERALS	
L x (B + D)	= 23832.00
POOP	= 32.92
BRIDGE	= 98.00
FORECASTLE	= 28.58
159.50 x 75 x 75	= 897.19
CASINGS & HOUSES	= 252.40
EQUIPMENT No	= 24981.59

EQUIPMENT.	
2 BOWER ANCHORS STOCKLESS	45 CWTs
1 " " " "	38 CWTs
1 STREAM ANCHOR EX STOCK	12 CWTs
1 KEDGE " " "	52 CWTs
2 7/8 FATHOMS 1 1/2" STUD CHAIN CABLE.	
90 FATHOMS 1 1/2" LINK CHAIN OR	
4 1/2" STEEL WIRE.	
100 FATHOMS 12' HEMP OR	
4" STEEL WIRE 19 STRAND.	
1-90 FMS 7" HAWSER & 1-90 FMS 2 1/2" STEEL WIRE	
1-90 " 6" " 2 1/2" " "	

HOLD LADDERS:- ONE TO EACH HATCH FORMED OF 2 HALF ROUND BARS 3 x 1 1/2 (SOLID) WITH RUNGS.

HOLD LADDERS:- ONE TO EACH HATCH FORMED OF 2 HALF ROUND BARS 3 x 1 1/2 (SOLID) WITH RUNGS.

HOLD LADDERS:- ONE TO EACH HATCH FORMED OF 2 HALF ROUND BARS 3 x 1 1/2 (SOLID) WITH RUNGS.

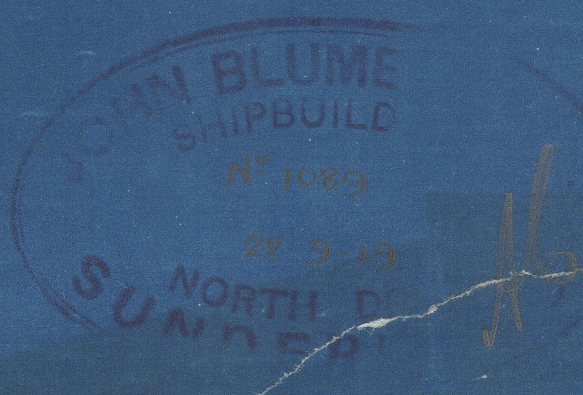

CENTRE GIRDER 39' x 48" FOR 2 LEN. TO 58 AT ENDS 58" IN B.S. BUTTS OVERLAPPED & TREBLE RIVETED CENTRE KEELSON VERTICALS 3 1/2 x 3 1/2 x 36 AT ENDS 6' x 40 FOR 1/2 LEN - 50 IN B.S. 12' 1/2 RIVS TO FLOOR 10' RIVS TO CR KEELSON.

SINGLE ANGLE 6' x 6' x 54 3/2 x 3/2 .54 DOUBLE FOR 1/2 OF 3/5 LEN.

SUNDERLAND


MESSRS J. BLUMER & Co.

S/S CYPRIAN PRINCE

No 252 Gloucester City

MIDSHIP SECTION
(AS BUILT)

SLO RPT. No 27616

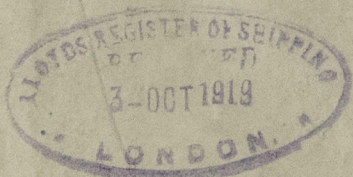

Ex
Namerquaband
N.N. KADER BAKSH



© 2020

Lloyd's Register
Foundation

003377-003384-0124