

005401-005408-0216 13

Insert Character of Ship and Machinery precisely as in the Register Book.

a Certificate required? If so, to be sent to...

BS 12,52

003401-003408-0276 13

SS "GLESSULA"

SHEET 2.

Now done. Damage (Continued).

Sketch on following Sheet No 3 Shows details of all fractures found, including those repaired earlier.

All fractures now repaired by "METALOCK"

Crankshaft deflections checked. All main bearings opened out, examined and re-metalled and adjusted as required and satisfactory alignment of crankshafts and thrustshafts obtained.

Upon completion of these repairs the main engines were examined under working conditions during mooring trials and left in good working order.

It is further recommended that the repairs effected to the Port and Starboard Main Engine Bearings be further examined before the end of December 1953

Considered efficient measure. Owners advised.

Now done. Docking.

Vessel placed in drydock, propellers, stern bushes and outside fastenings examined.

All sea valves, opened out, examined and found or placed in an efficient condition.

Wear down as above.

Minor repairs effected.

B.S.

Port and Starboard Boilers opened out and examined in their entirety together with their safety valves and boiler mountings. Safety valves afterwards adjusted under steam to the pressure stated above.

Minor repairs to boiler mountings and furnace refractory.

Oil fuel unit examined under working condition and found in good working order.


Fuel Tank Valves and deck controls examined and tested and found in good working order.

The oil pressure pipes between the pumps and the furnaces are in a good condition, accessible, visible and well lighted along their entire length and the joints are tight.

Steam Smoothing gear tested and found in good order.

W. J. G. Wilson
SURVEYOR TO LLOYD'S REGISTER
NEWCASTLE-ON-TYNE.

Continued on Sheet 3.

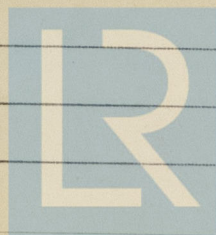

© 2020

Lloyd's Register
Foundation

0276 2/3


SS. 'GLESSULA'

SHEET No 3


SKETCH SHOWING CRACKS IN MAIN ENGINE BEDPLATES

CRACKS SHOWN IN RED

PORT ENG.

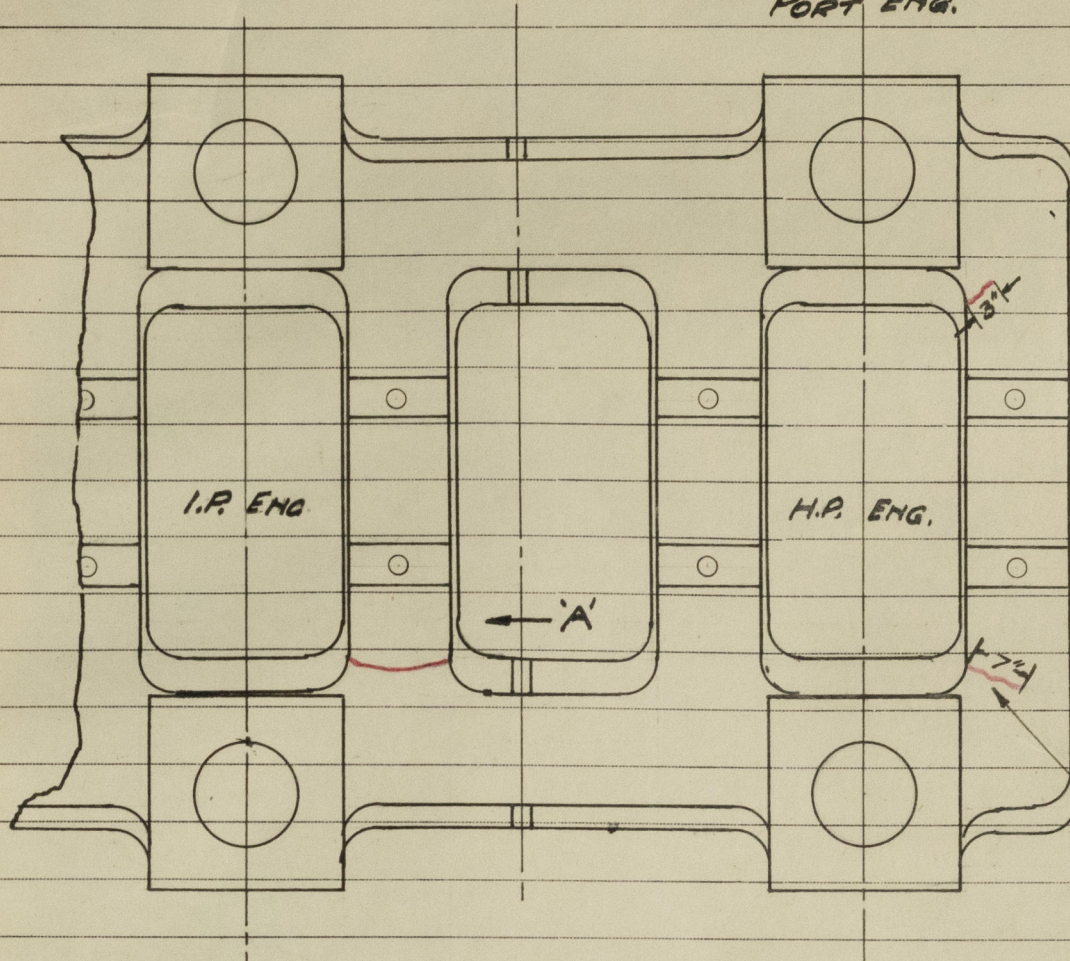

STARBOARD ENG.

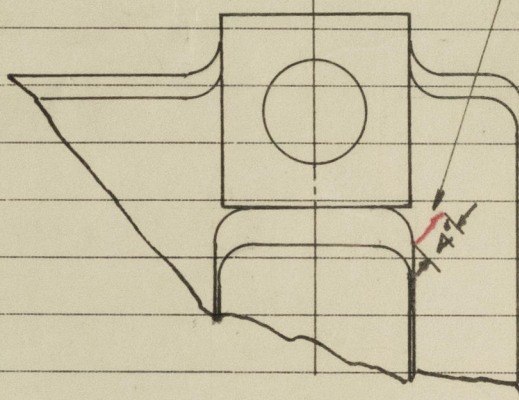

VIEW LOOKING AFT IN DIRECTION OF "A"

