


s.s. "DIADEM".

— PROFILE. NO 317. —


PRINCIPAL DIMENSIONS.
LENGTH B.P. 390'-0" BREADTH MLD. 53'-8" DEPTH MLD. 27'-0"

SCALE $\frac{1}{8}$ " = 1 FOOT.

SUNDERLAND SHIPBUILDING CO. LTD.
DRAWING OFFICE.
No. 25662 25 SEP 1920
SUNDERLAND.

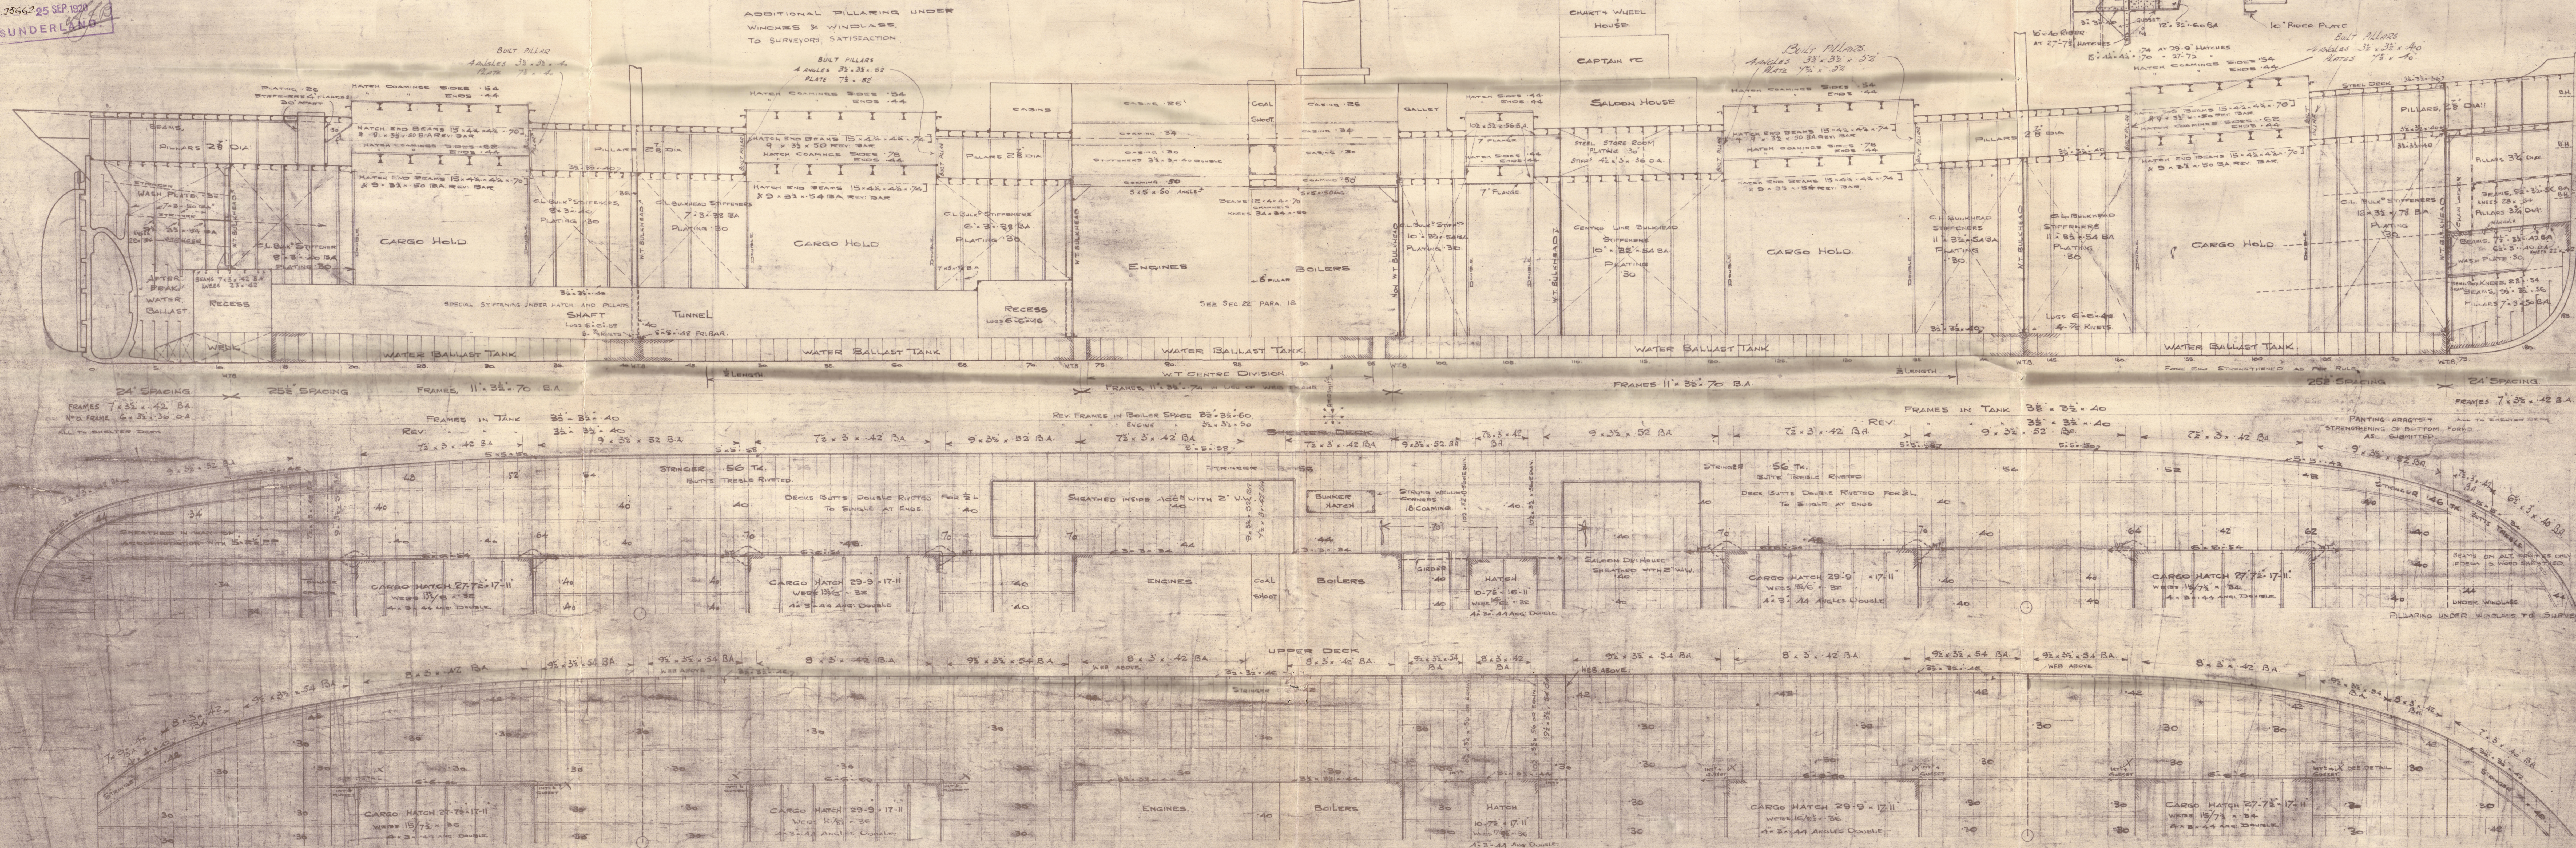

DETAIL OF HATCH CORNERS AT UPPER DECK.

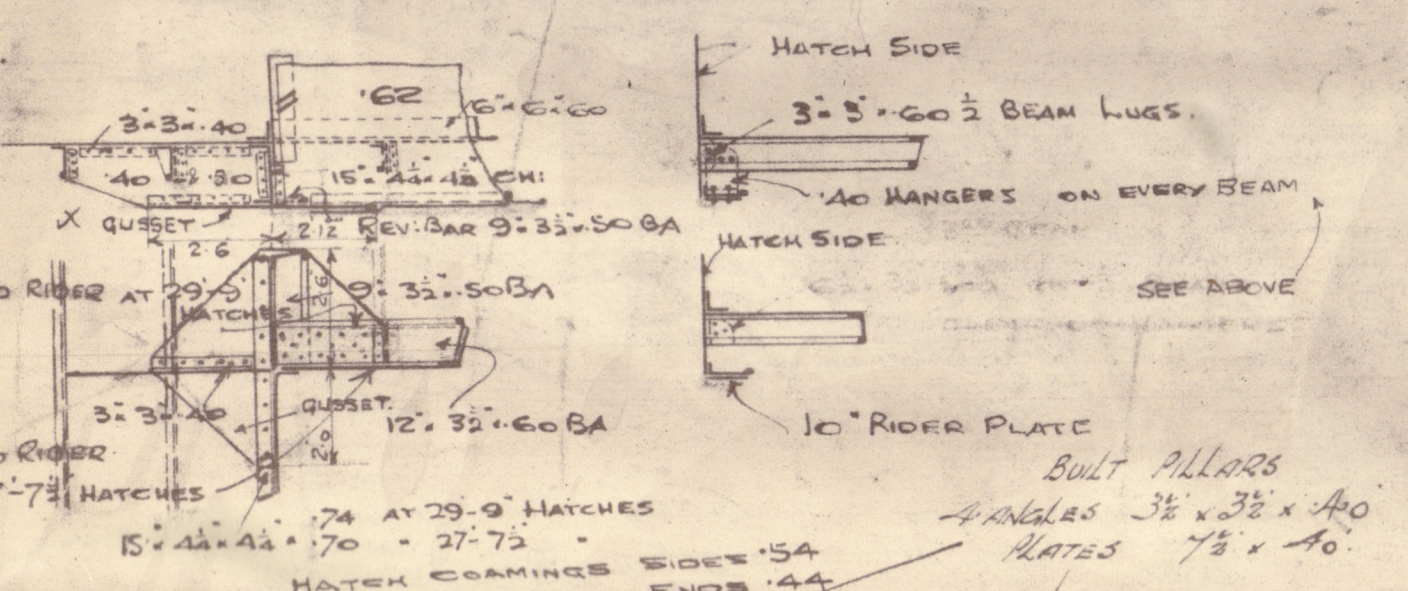

S/S "DIADEM"


PROFILE & DECK PLANS

AS BUILT

SUNDERLAND S. Co

317

SUNDERLAND RPT. No. **27940**

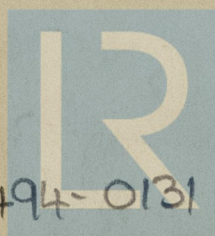

© 2020

Lloyd's Register
Foundation

003487-003494-0131