

Single Se. Motor Vessel "PROWESS"


— No. 154 —
OIL TANK VESSEL

DIMNS. 105'0" - 23'0" - 9'0" MLO.

SCALE: 1/2" = 1 FT.

TO CLASS 100 A1 CARRYING PETROLEUM IN BULK

Length on W.L. 104'3"

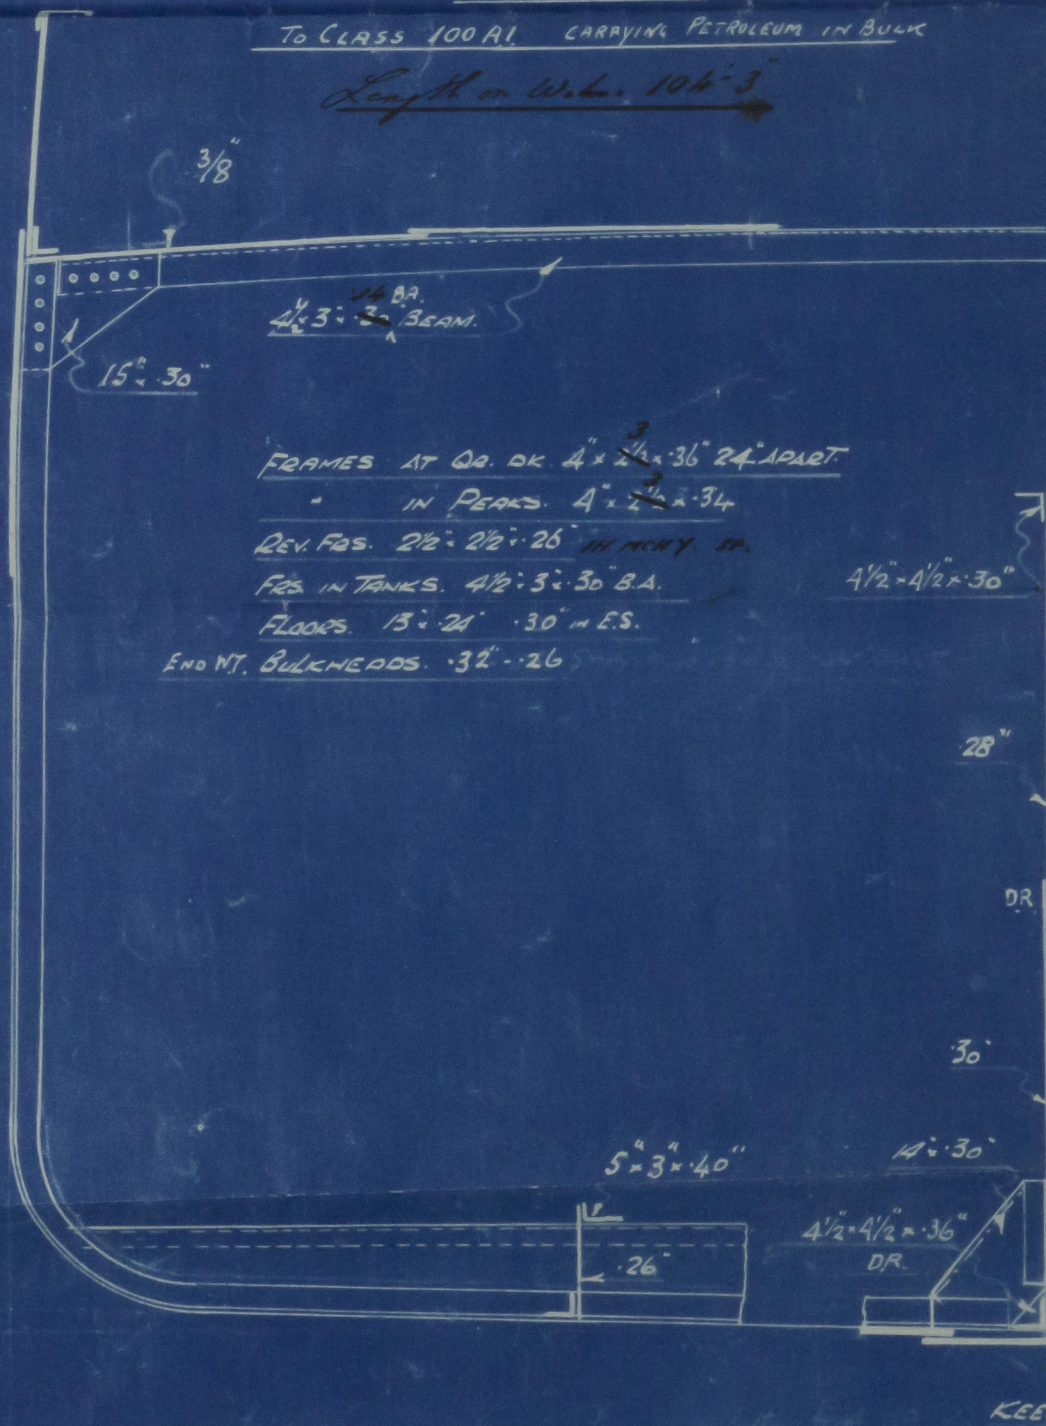

FRAMES AT 00. OK 4" x 36" 24" APART
IN PEAKS 4" x 34"
REV. FBS. 2 1/2" x 2 1/2" x 26" IN PEAKS
FBS IN TANKS. 4 1/2" x 3" x 30" B.A.
FLOORS. 13" x 24" x 30" IN E.S.
END NT. BULKHEADS. 32" x 26"

END SCANTLING

D = 9

d = 7.92

L x D = 945 938
L x (B + D) = 5560 2236

L / D = 11.67
L / d = 11.88

EQUIP. NO.

L x B + D = 5560

OR DR 32 x 3. 96

CASINGS 675 x 29. 98

FE. 14.8 x 14.3. 43
3593.

EQUIPMENT

2 BOWER ANCHORS 5 1/4 CWT. EACH STOCKLESS

1 STREAM - 1 1/4" EX. STOCK


120 FMS. 1 1/2" 16 STUD LINK CABLE

45 - 2" WIRE

75 - 2 1/4"

90 FMS 4" MANILLA

TEST HEAD 2'0" ABOVE TOP OF EXP. TRUNK.

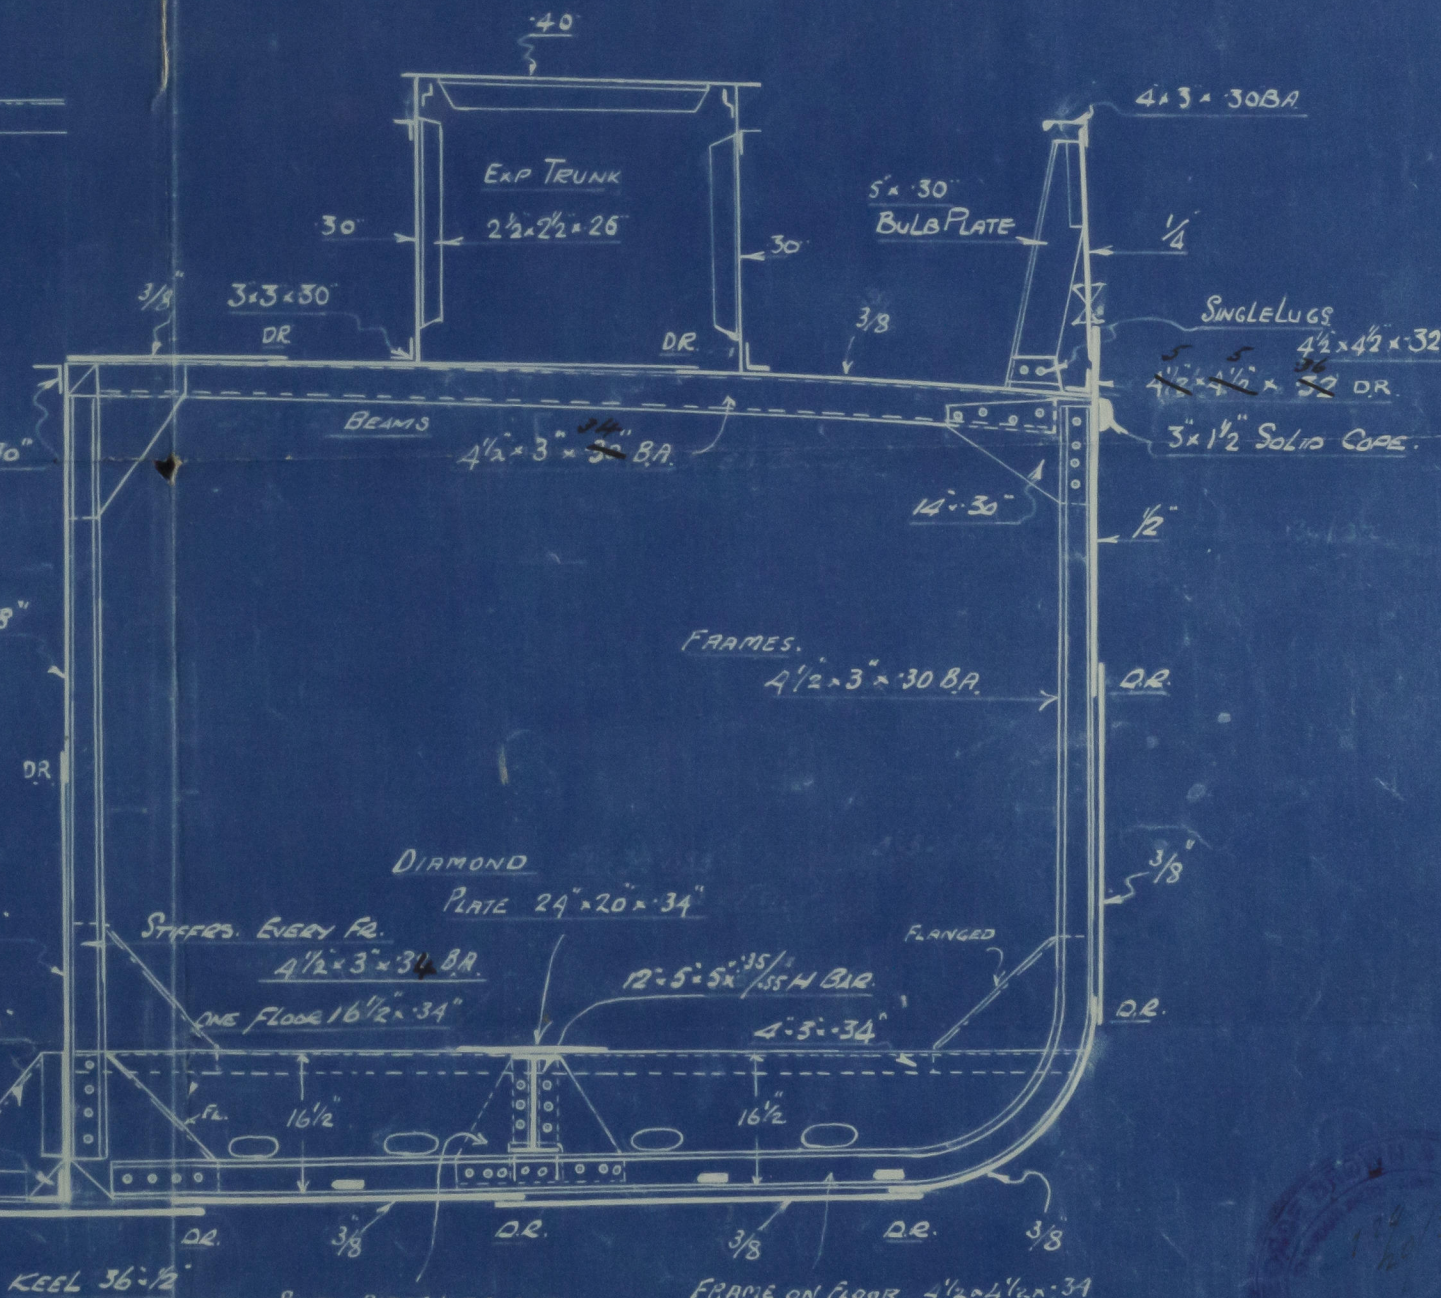

BKTS. ALTERNATE SIDES

TANK SCANTLING



Lloyd's Register
Foundation
003495-003502-0133

Geo. Brown & Co.

Motor Oil Tanker

"PROWESS"

Midships Section

as Built.

Gen. Reg. No. 18598.

© 2020

Lloyd's Register
Foundation

003495-003502-0133