

DIMNS: 142'-6" x 25'-6" x 10'-3" MLD


To Class 100 A.I. at Lloyds.

$L \times (B + D)$  ----- 5094

$$\frac{L}{D} = 13.9$$

$\frac{L}{\sigma}$  at Qr. DK ----- 10.36

## RIVETING

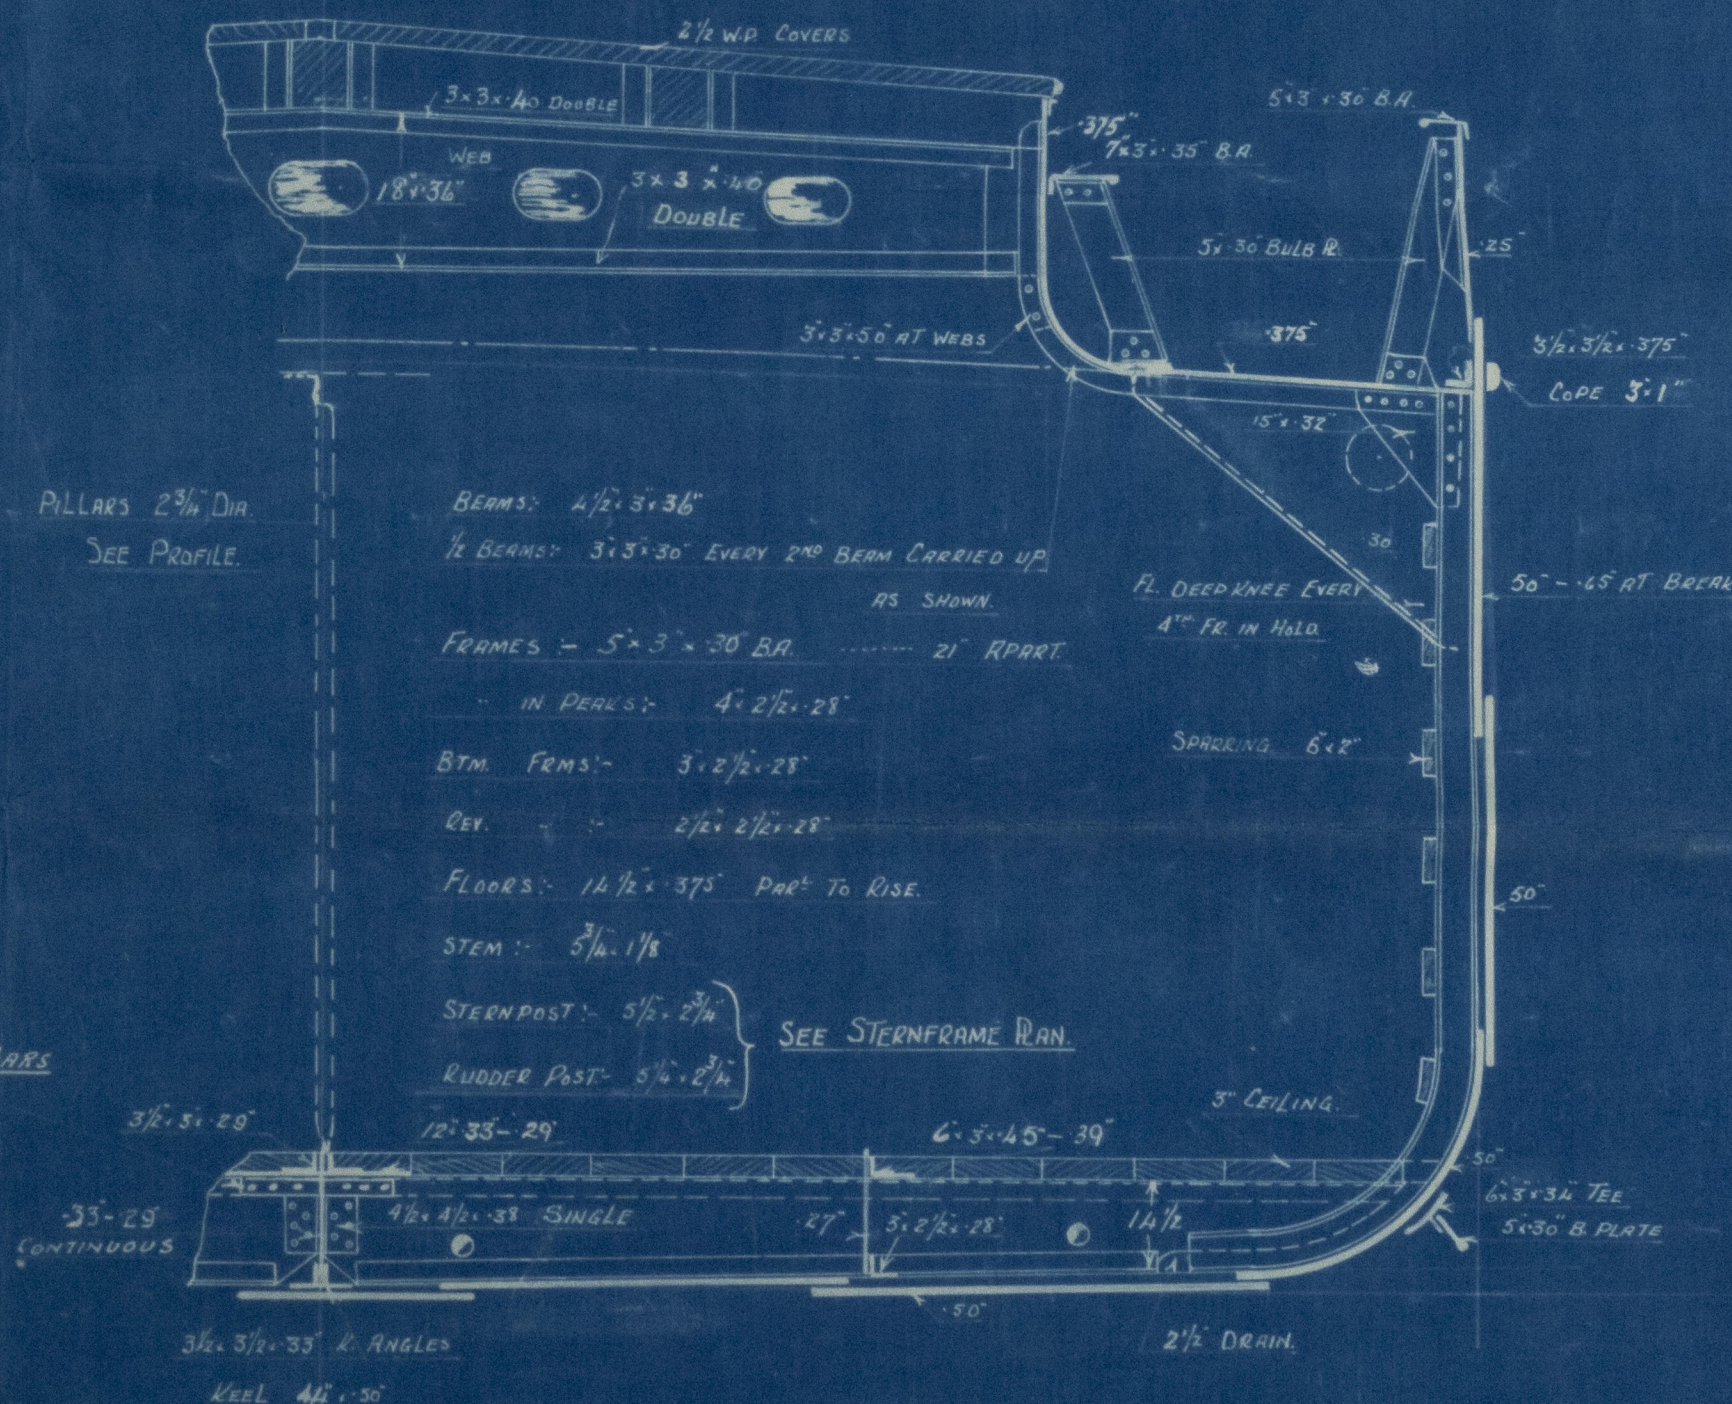

SEE STERNFRAME PLAN

10

10



GEO. BROWN & Co

No 185

M. V. ACRITY \*

MIDSHIP SECTION

AS BUILT

GREENOCK FIRT ENTRY

REPORT No. 19703

RETAIN

R

© 2020

Lloyd's Register  
Foundation

004009-004018-0002