



# 3/8 "KAMLOOPS" & 3/8 "LETHBRIDGE" TWEEN DECK PACKAGE FREIGHTER PROFILE & DECK PLANS.

DIMENSIONS LENGTH B.P. 250'-0". BREADTH M.O. 42'-9". DEPTH M.O. 26'-6".

ISHERWOOD SYSTEM.

SCALE 1" = 1 FOOT.

LLOYDS + WITH PROVISION  
 TO CLASS 100. A.I. FOR SERVICE IN THE GREAT LAKES  
 S.A.S. #  
 AND RIVER ST. LAWRENCE.

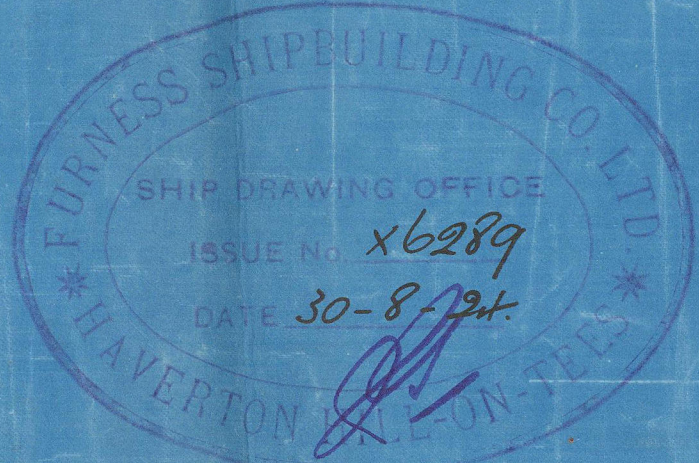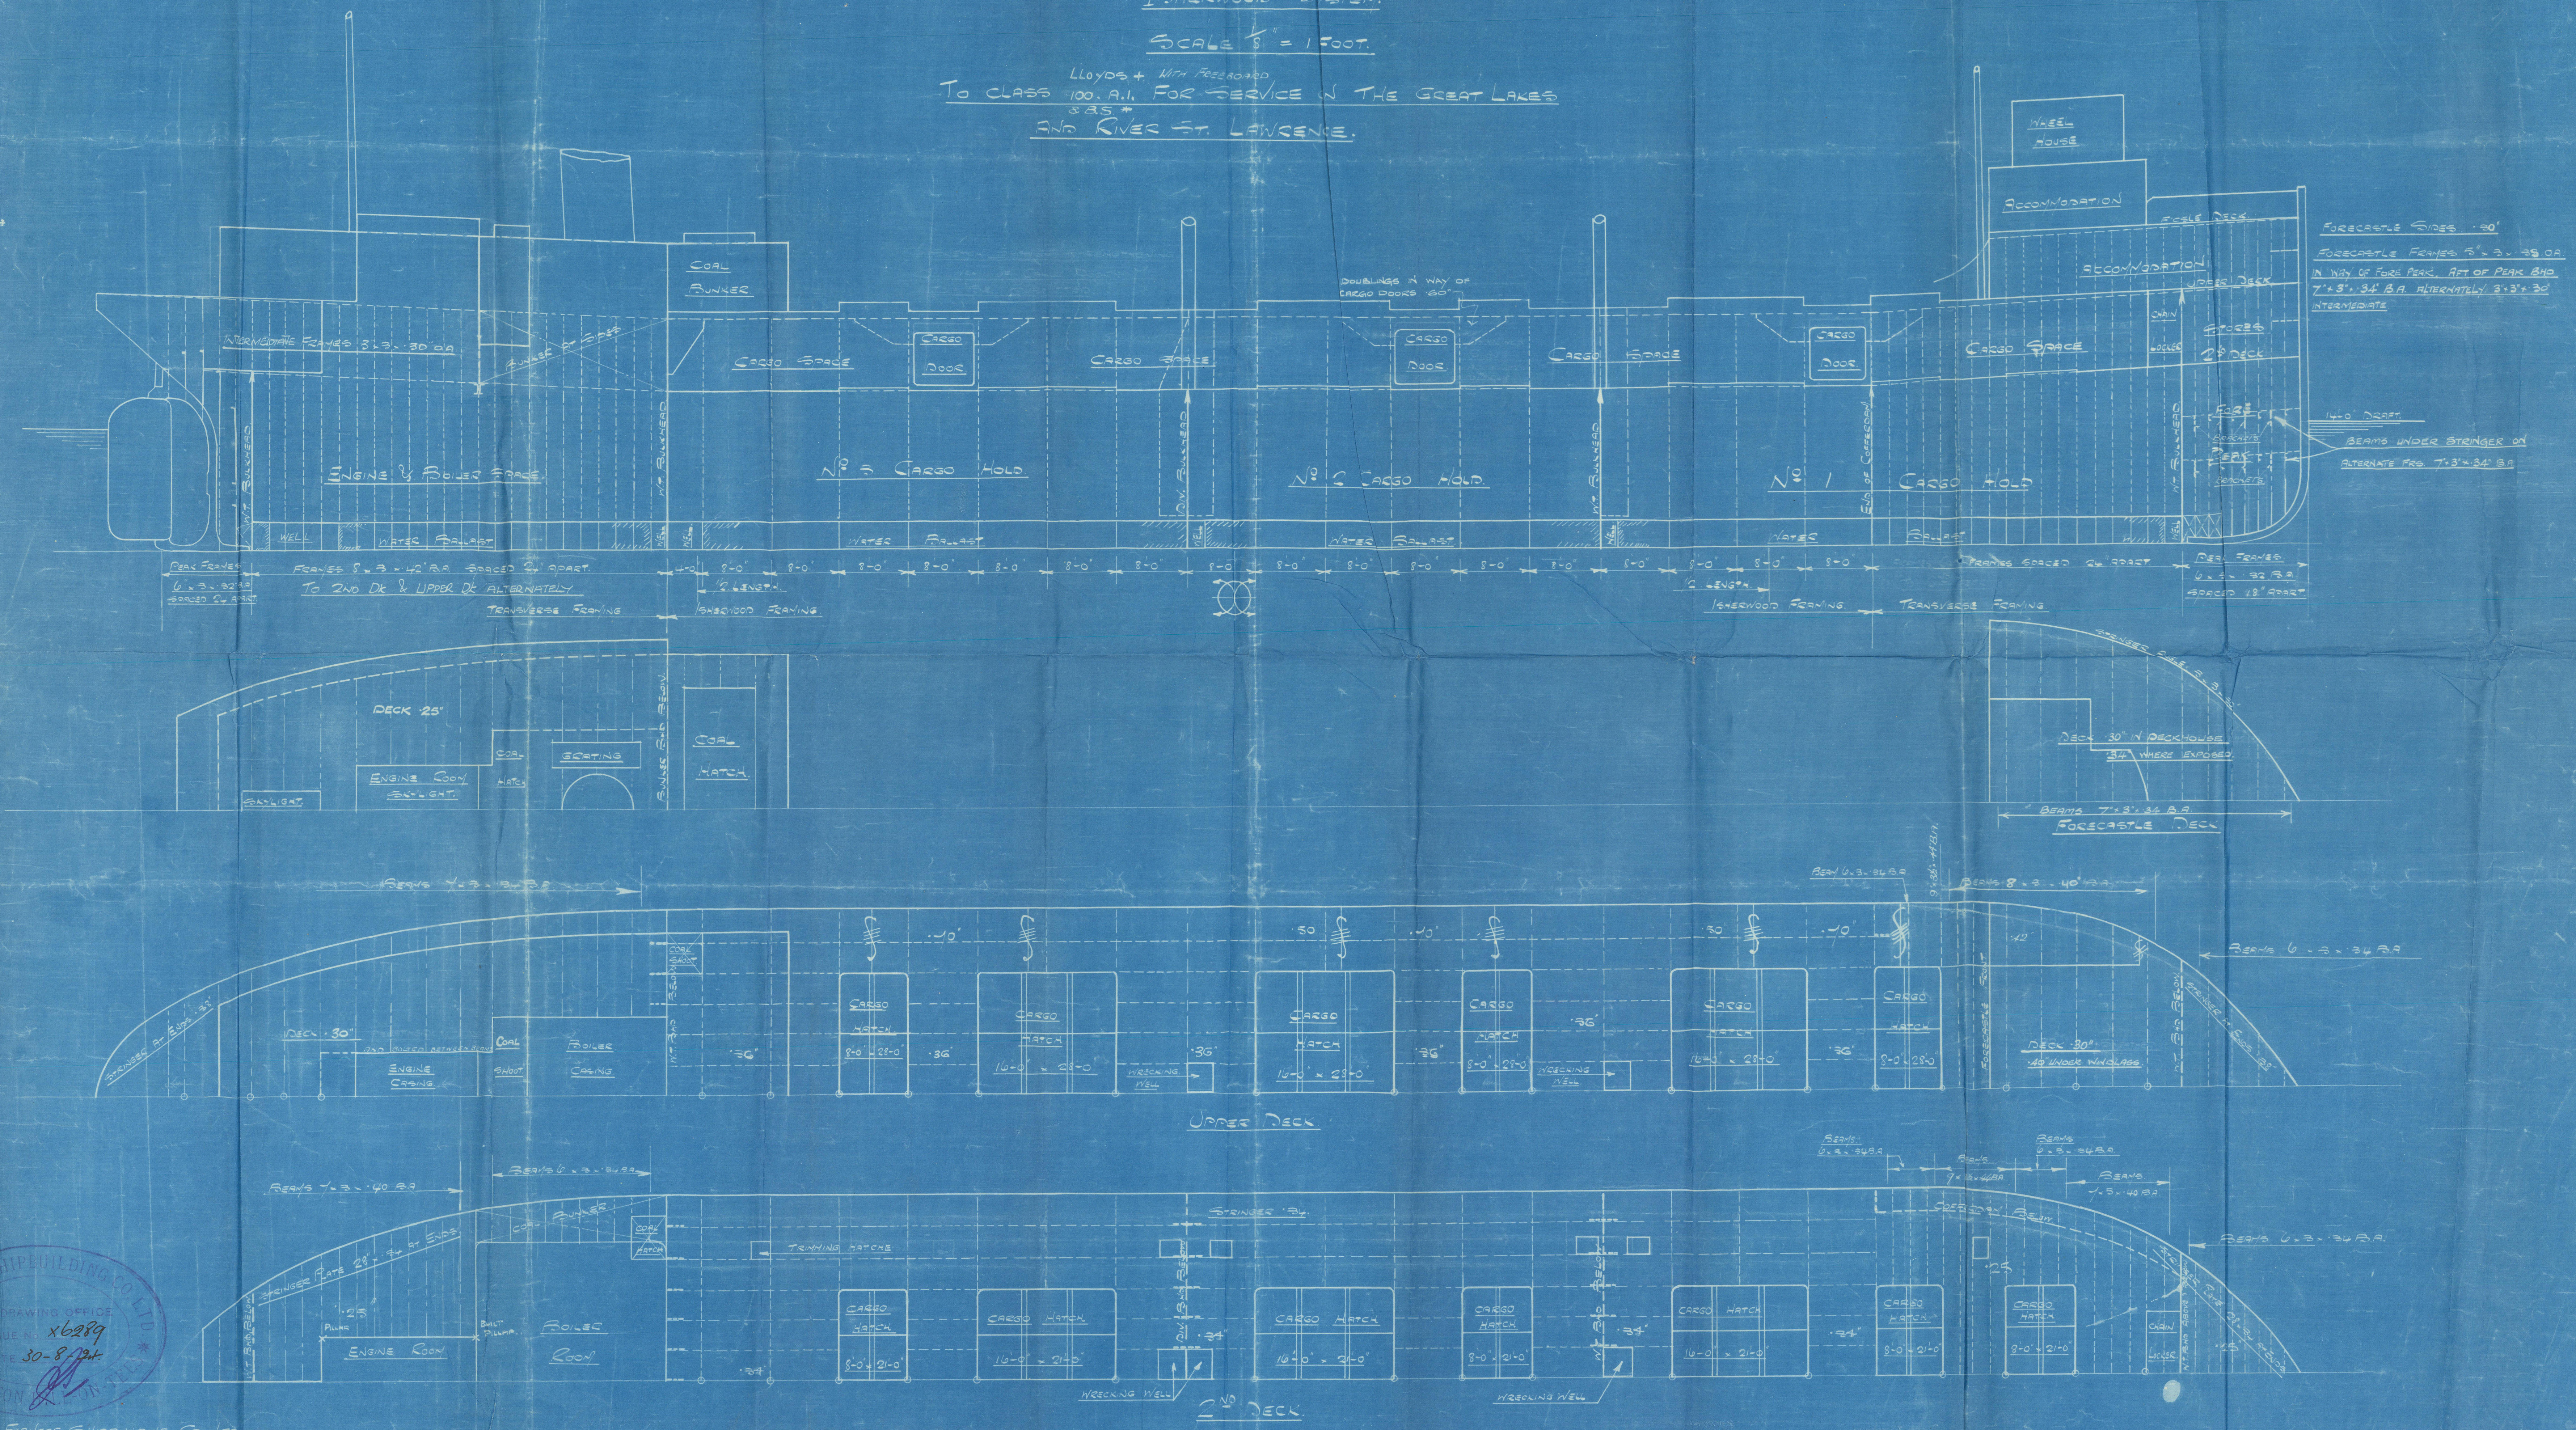

THE FURNESS SHIPBUILDING CO. LTD.  
 HAVERTON - HULL - ON - TEES  
 PLAN NO. 1886, I.N. 1440, 12.12.23



S.S. Lethbridge

Turnen Ship & Co. 1069

Profile & Decks

As Built.

S.S. Lethbridge

MDB. RPT. No. 12036

(See later)

RETAIN

© 2020

Lloyd's Register

004062-004066-0182

Foundation