

NUMERALS:
1ST NUMBER
26 + 12.25 = 38.25 $\frac{1}{5} = 13.05$
2ND NUMBER = 8120

EQUIPMENT 8120
Q.R. DECK 64 x 3.5 224
F/RLE 26.5 x 7 x 75 139
CAPINGS 59.5 x 7 x 50 208
6894


Nº 141 OIL TANK STEAMER MIDSHIP SECTION

DIMENS 160' x 26' x 12'-3" MLD
Scale 1/2" = 1 foot

TO CLASS 100.A.I. AT LLOYDS
CARRYING PETROLEUM IN BULK.

OUTFIT
2 BOWER ANCHORS 10 1/4 C.W.T.S STOCKLEON
1 " " 8 3/4 " " "
1 STREAM ANCHOR 3 1/2 " EX-STOCK
1 KEDGE 1 1/2 " " " "
185 FATHOMS 1 1/8" STUD LINK CABLE
60 " 2 1/4" STEEL WIRE ROPE
75 " 2 1/2 " " " "
90 " 5 1/2" MANILLA.

RIVETING
SEE SEPARATE SHEET.

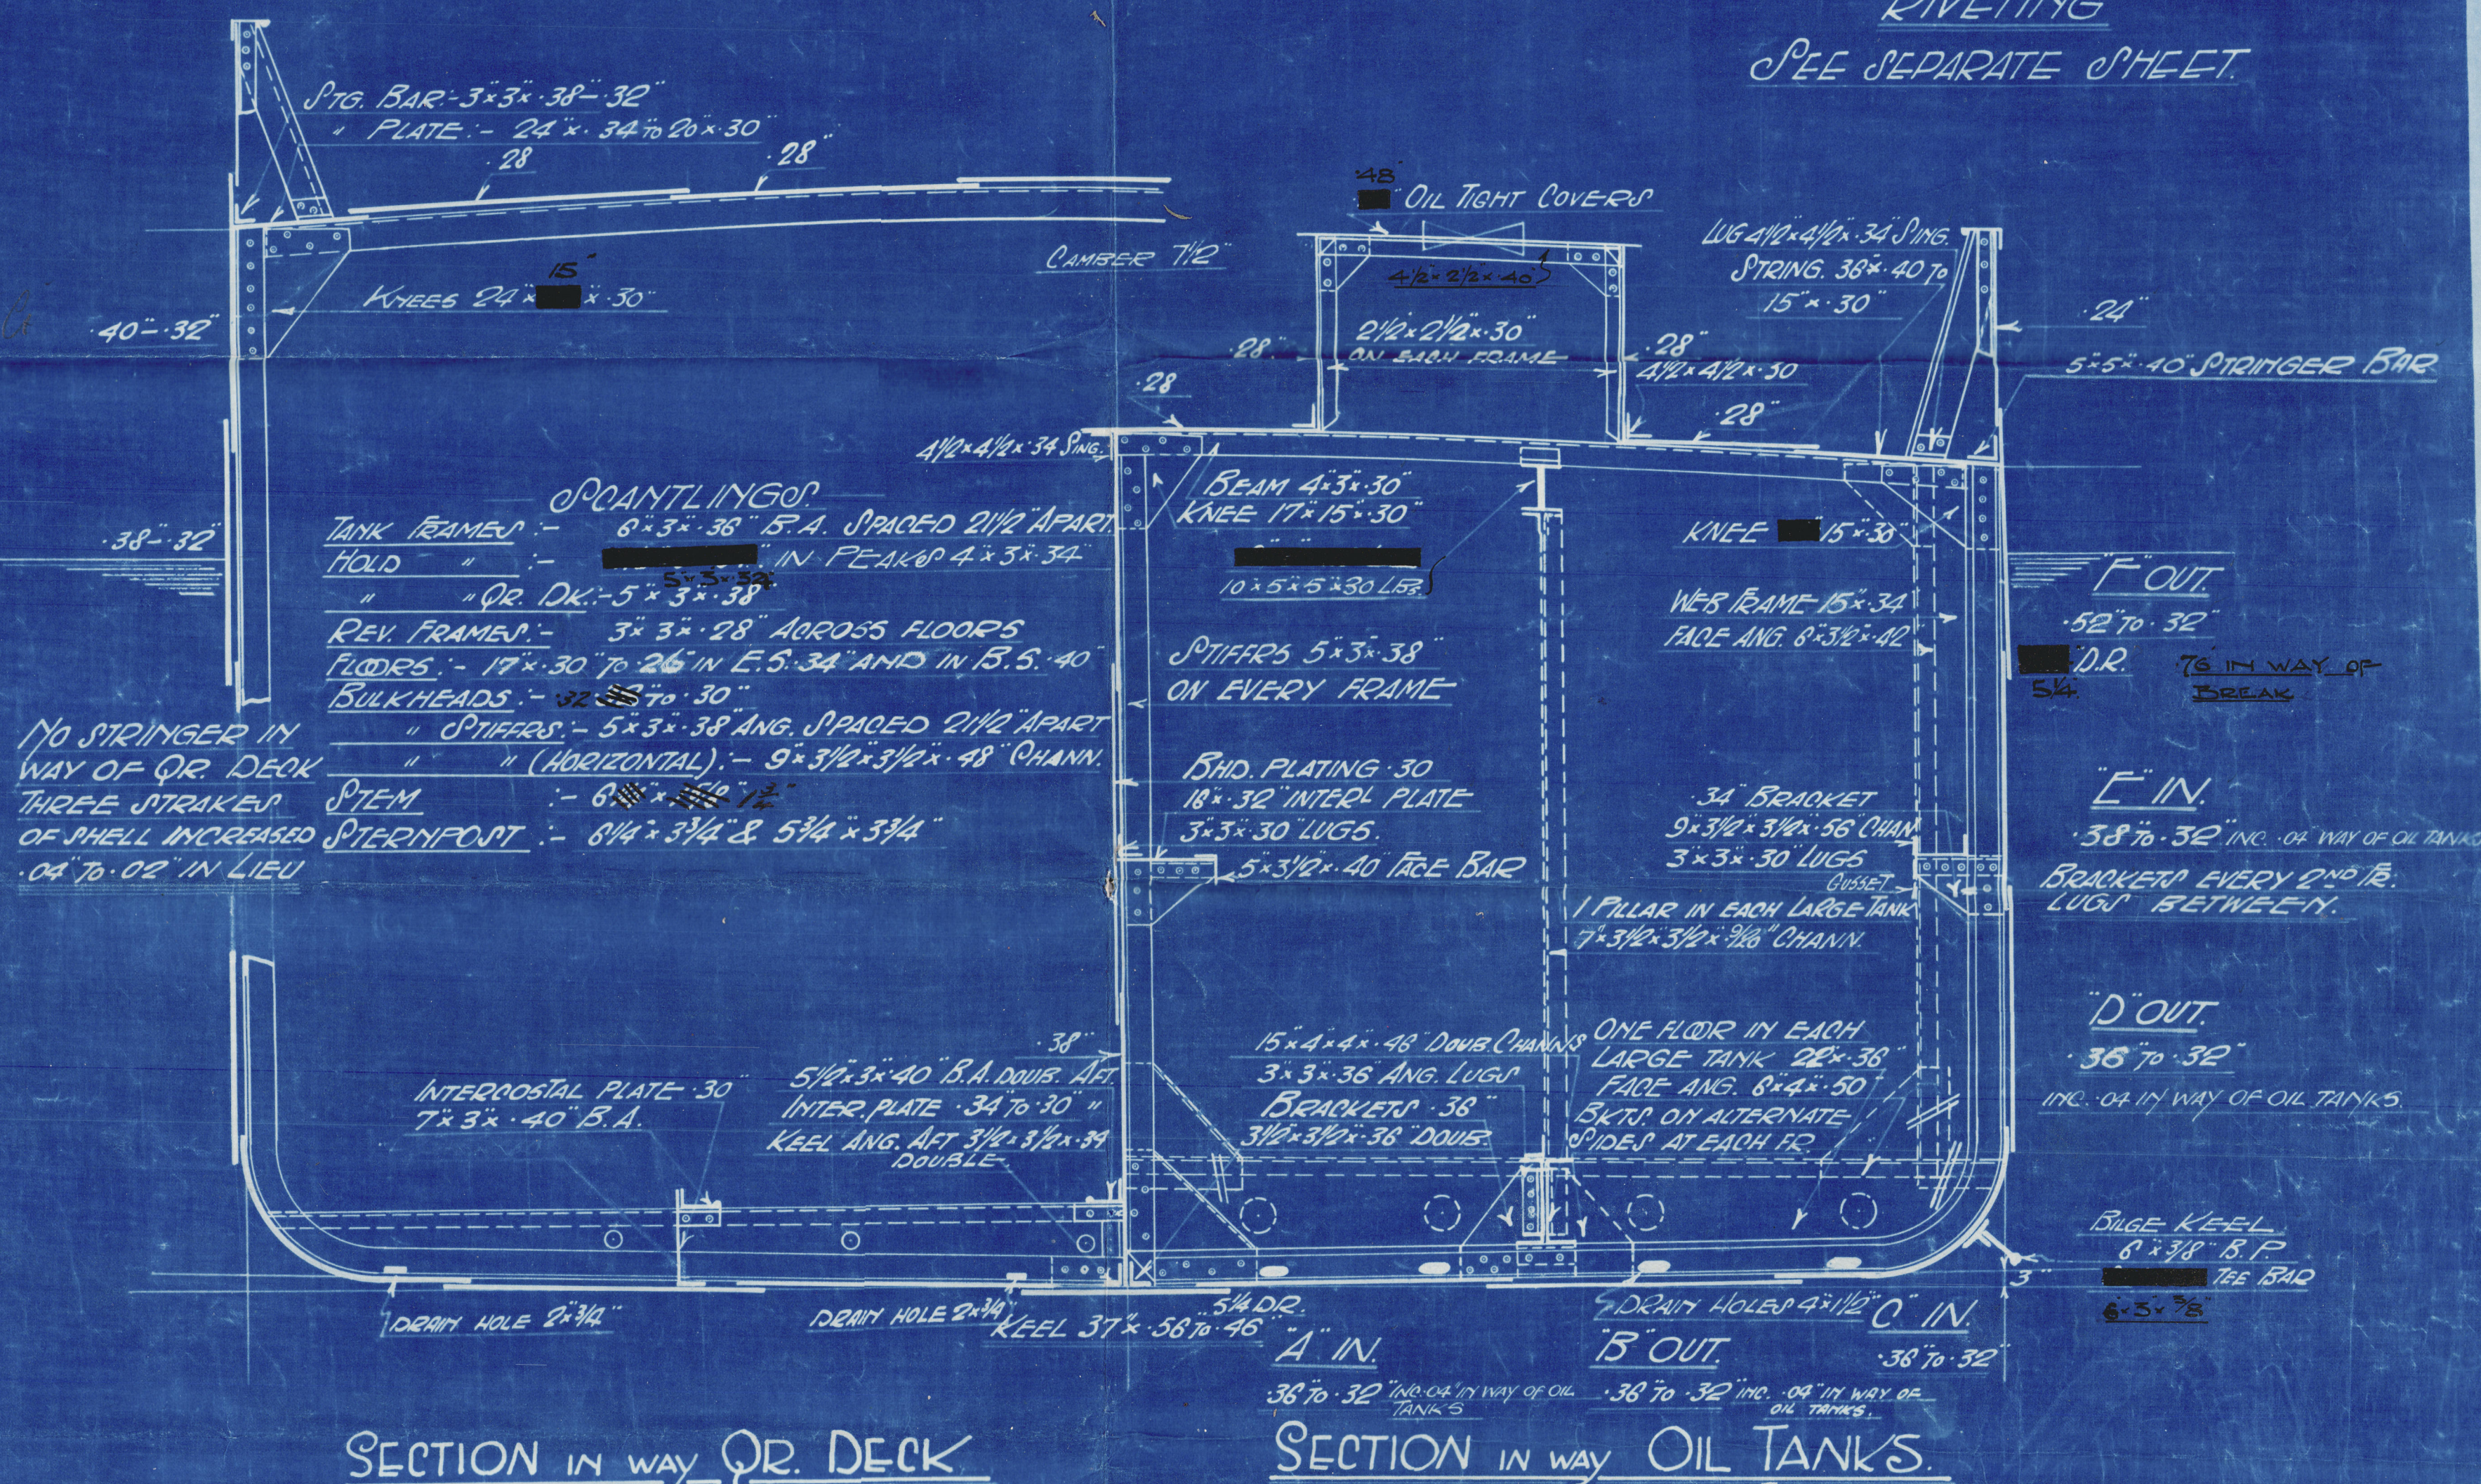

SECTION IN WAY Q.R. DECK

SECTION IN WAY OIL TANKS.



8120-1337-0100

R

Officer Geo. Brown &c.

S.S. Agility

N^o 141.

Midship Section
as Built

Grk. Ref^t. N^o 18210.



004332-004337-0146