

S. S. "ANDALUSIER"
EX. S.S. WAR VICTOR

MIDSHIP SECTION.


411' 6" B.P. x 55' 5 1/2" MLD. x 38' 1 1/2" MLD. TO SHELTER DECK.

TO CLASS 100 A1 LLOYDS "SHELTER DECK"

WITH SPECIAL NOTATION DESIGNATING TYPE OF BILGE

BS * BRITISH CORPORATION.

SCALE 1/2" = 1 FOOT.

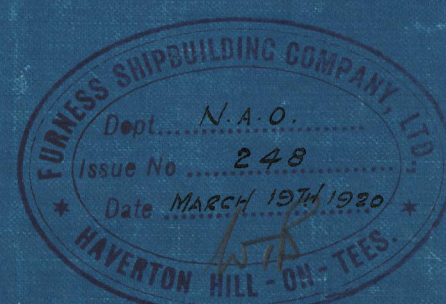

EQUIPMENT NUMBER.

HULL - 35216

TWEEN DECK 411' 5" x 8' 7 1/2" - 2276

CASING 65' 10" x 7' 5" - 2255

HOUSE 32' 11" x 8' 0" x 5" - 128

FCLF 40' 37" x 7' 5" x 7 1/2" - 2276

EQUIPMENT 40335

2 BOWER ANCHORS 68 CWTs STOCKLESS

1 58 1/2" STOCKLESS

1 STREAM 19" EX. STOCK

270 FATHOMS 2 3/16" STD CHAIN CABLE

90 1 3/16" STREAM CHAIN OR 5" S.W. ROPE

120 15" HEMP OR 5 1/4" S.W. ROPE TOWLINE

2 OFF 90 8" HEMP HAWSERS OR 2 3/4" S.W. ROPE

2 OFF 90 7" 2 1/2" S.W. ROPE

LLOYD'S NUMBERS.

B = 55' 5 1/2"

D = 30' 1 1/2"

85' 7" = 85.583 = TRANS. N°

L = 411' 6" = 411.5


35216 = LONG. N°

L { SHELTER DECK = 10' 7 1/2"
D { UPPER DECK = 14' 3"

d = 24' 5 1/2" { 38' 1 1/2" DEPTH MILD.
9' 4 3/4" TWEEN DECKS.
28' 8 3/4"
3' 7 3/4" TANK.
25' 1" { 1/2" DIFF. OF RULE
- 7 1/2" { 3" APP'D TANK BRACKET.
24' 5 1/2"

SECTIONS USED.

0.4	B.A.
7' x 7'	10' x 3 1/2"
5' x 5'	9' x 3 1/2"
4 1/2' x 4 1/2'	
9' x 4'	
4' x 4'	
6' x 3 1/2"	
3 1/2' x 3 1/2"	
3' x 3'	

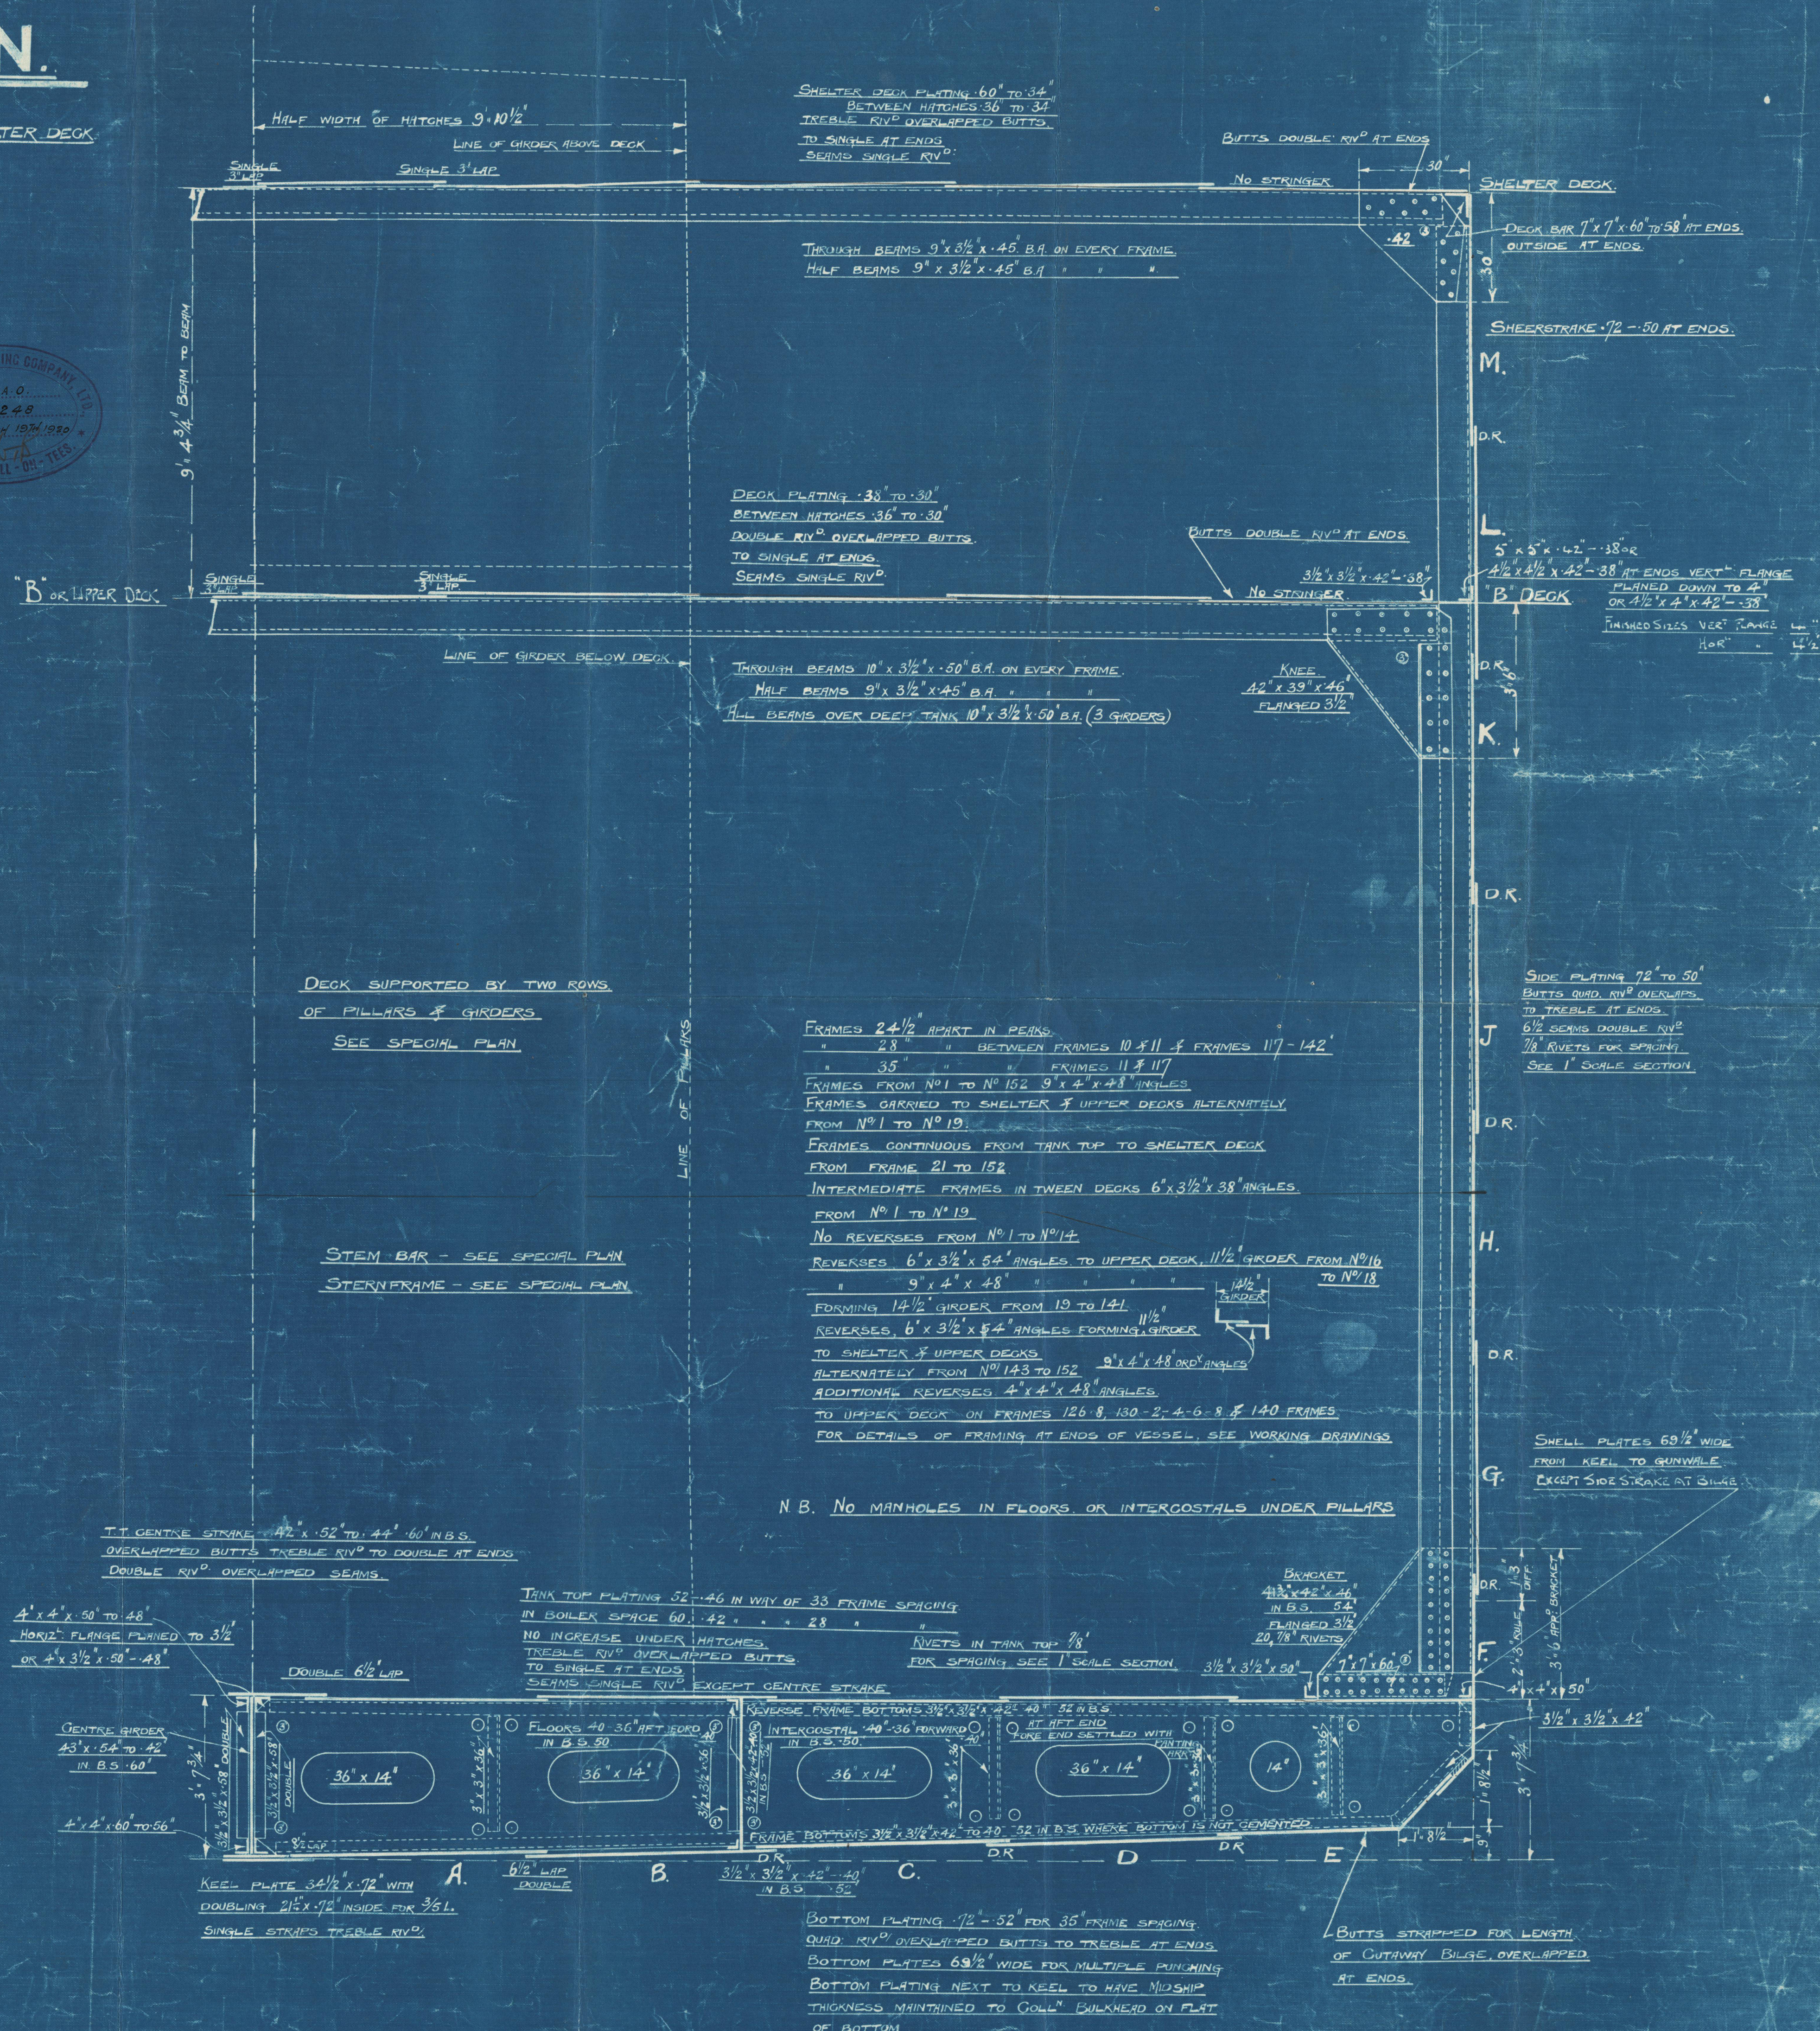

Now named "African Marine"

^{ex}
S. S. "WAR VIGOUR"

^{ex}
~~NOW NAMED~~
"ANDALUSIER"

Invent. Furness S.B. 6th N°10

No. Type Standard

MIDSHIP SECTION

(as built)

Invent. Rpt. 10622

~~W.S. 434~~

Castillo Montpuch

RETAIN



© 2020

Lloyd's Register
Foundation

004382-004386-0123