


MIDSHIP SECTION.

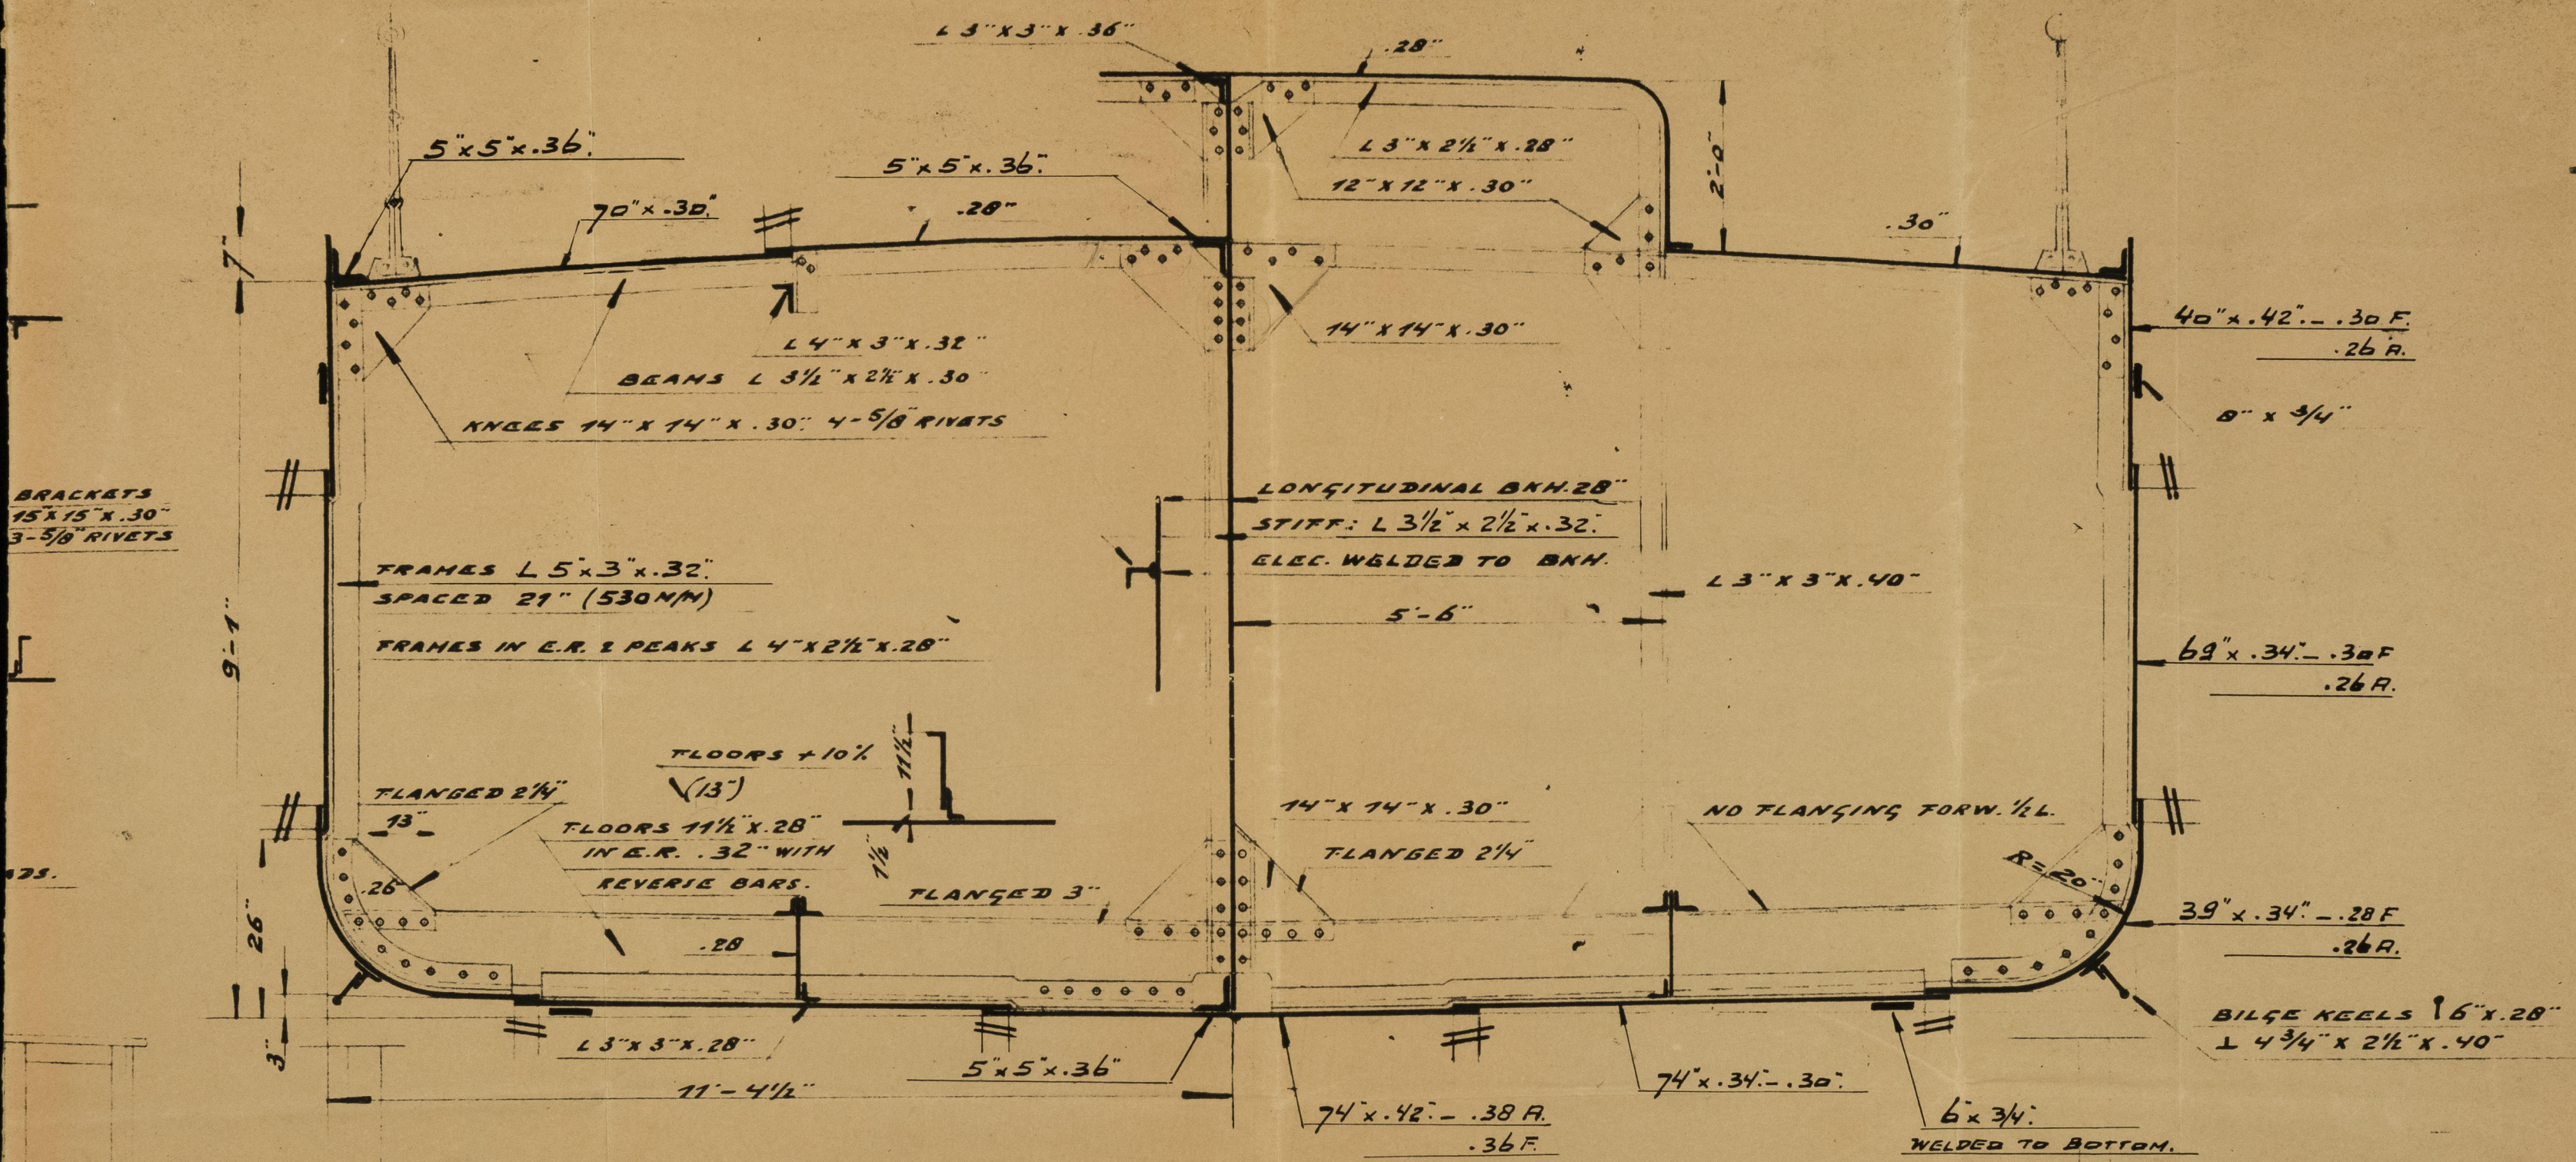

SCALE 1:40 & 1:20.

No 571

De Noord



© 2020
Lloyd's Register
Foundation

004394-004404-0254

LONDON.

N.V. INDUSTRIEEL MAATSCHAPPIJ

"DE NOORD"

YARD N° 571.

M/S "GUIDESMAN"

ROT. REPT. N° 27252^a

MIDSHIP SECTION

(AS BUILT.)



© 2020

Lloyd's Register
Foundation

004394-004404-0254