


30 MAY 1945

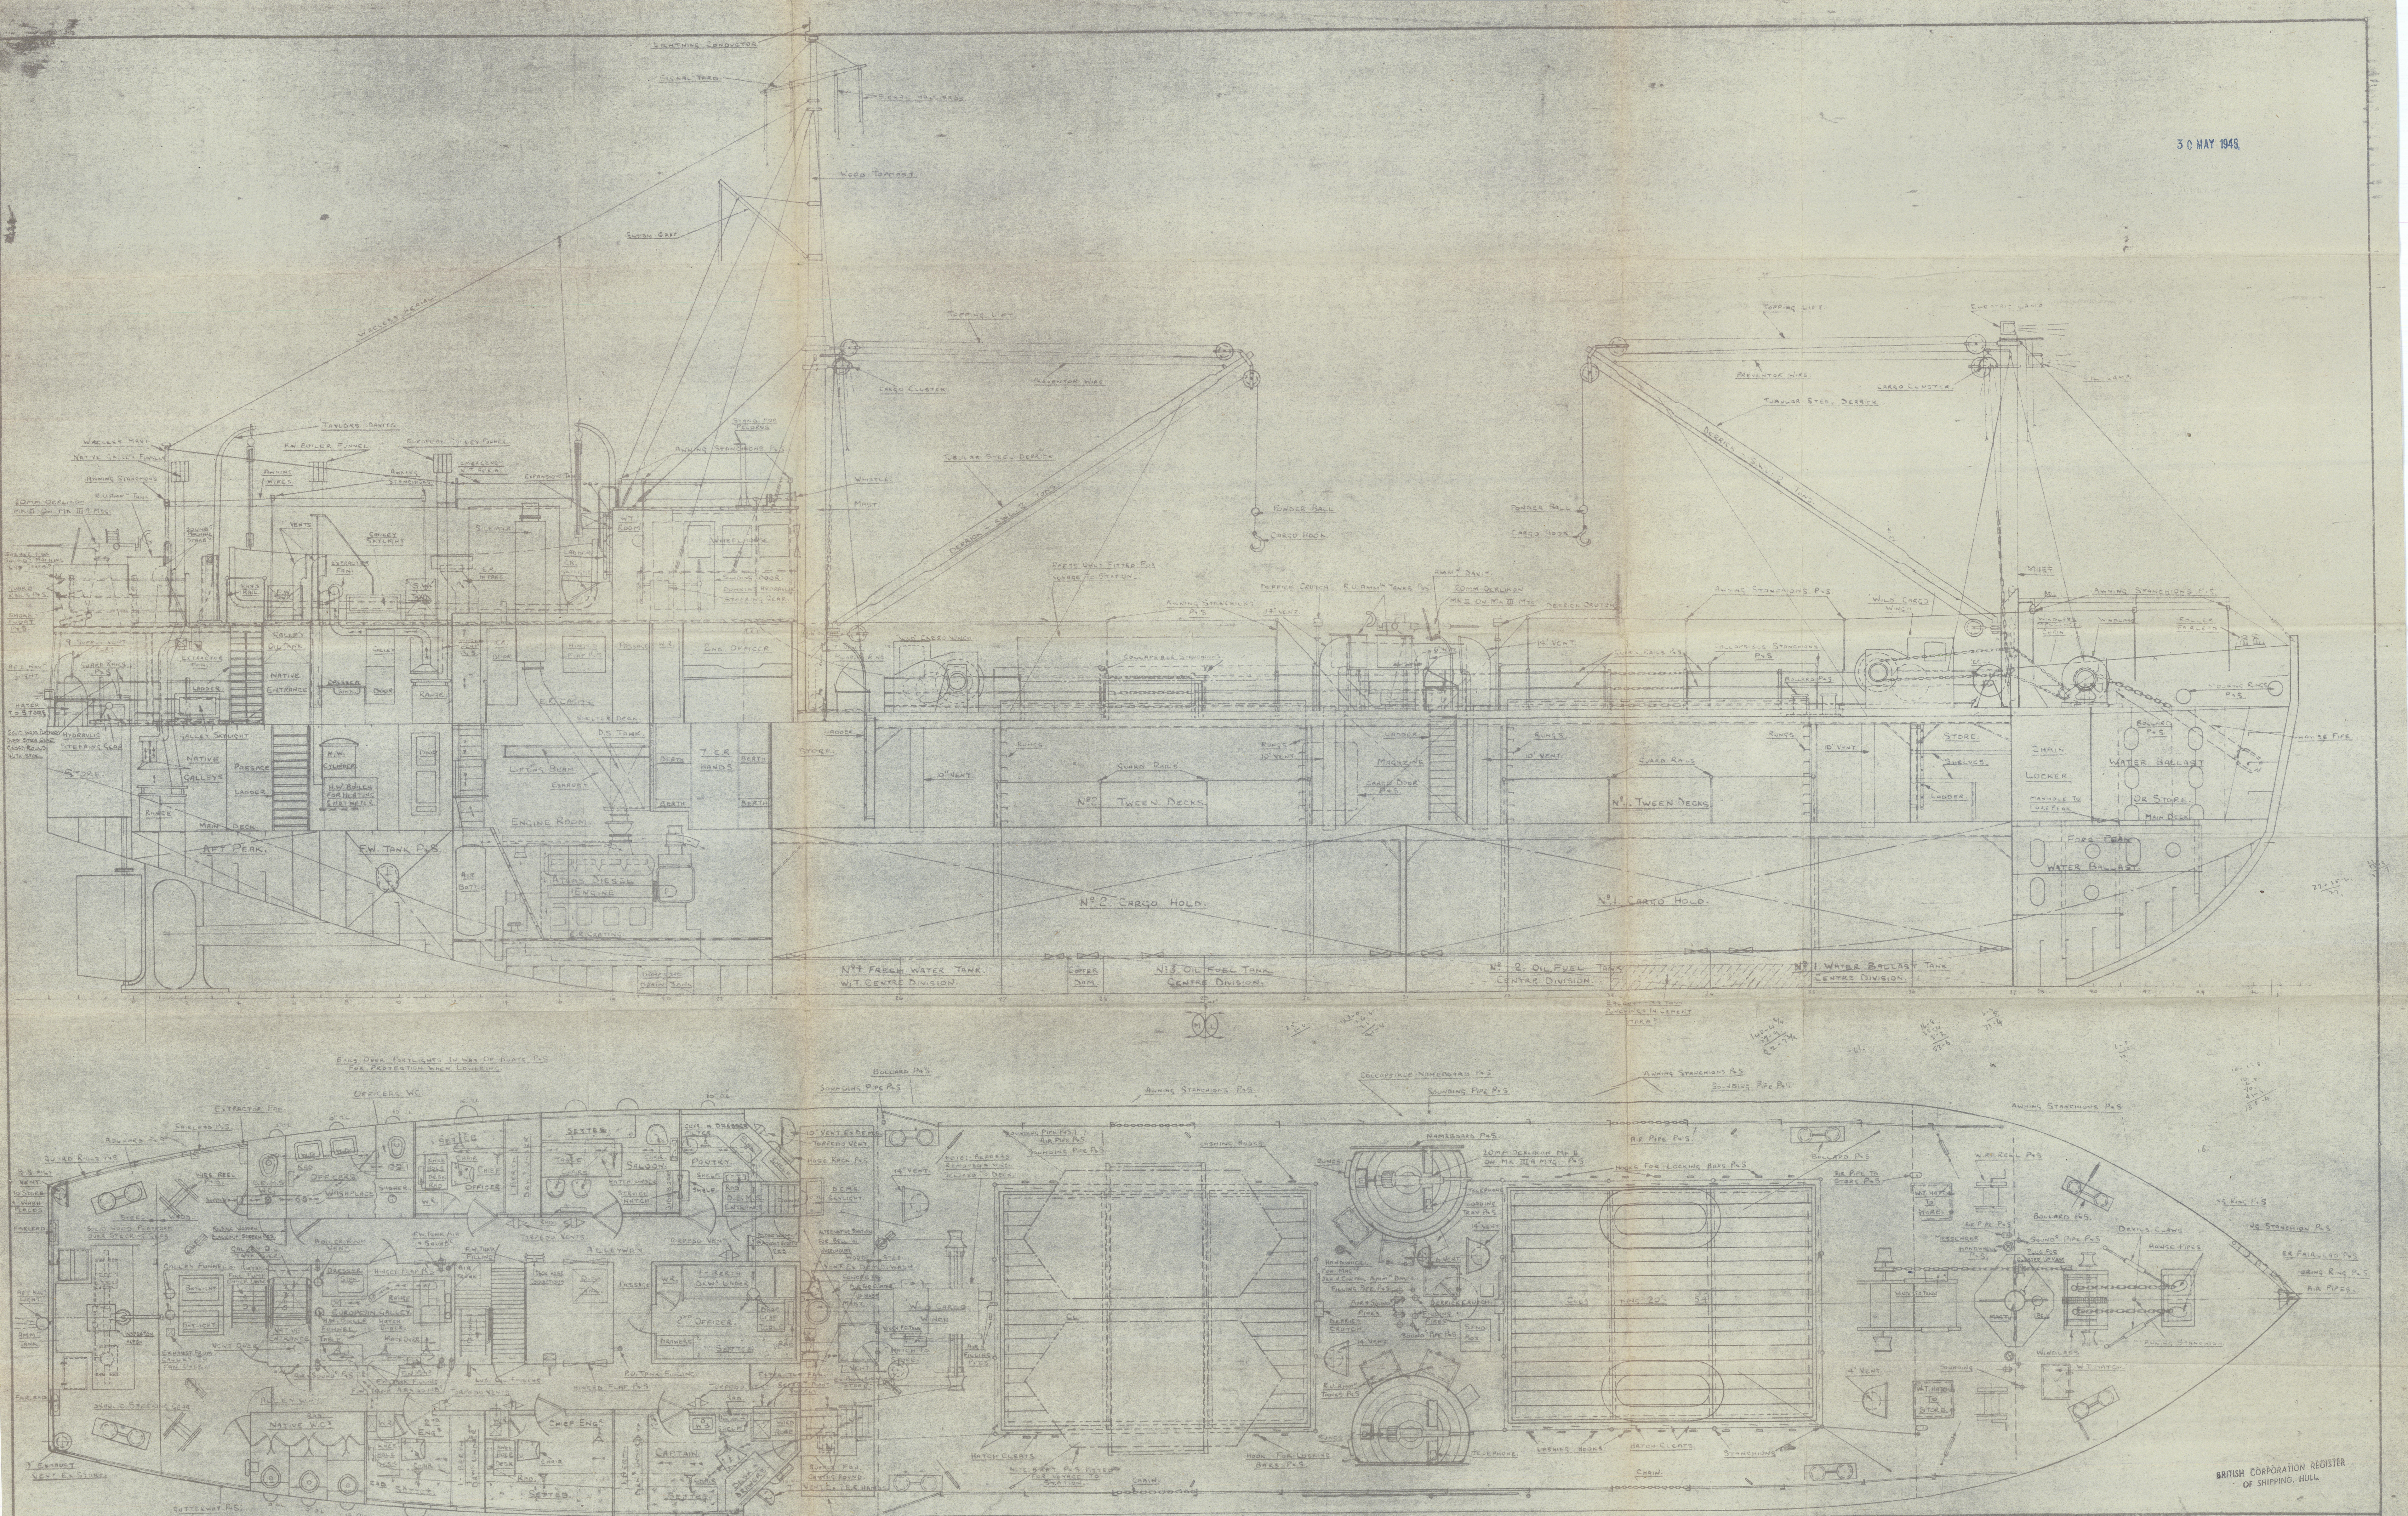

"EMPIRE SEAHAWK"  
AMS NO 112

DIMENSIONS.  
LENGTH O.A. 145' - 1"  
LENGTH B.P. 141' - 0"  
BREADTH MLD. 27' - 0"  
DEPTH MLD. 11' - 0"

RICHARD DUNSTON LTD.  
SHIPBUILDERS,  
THORNE, YORKSHIRE

DRAWN BY DH DATE 15-3-45  
TRACED BY DA DATE 20-5-45  
CHECKED BY KWA DATE 21-3-45  
REVISIONS  
DATE PARTICULARS

This Drawing and the information it contains are the Property of RICHARD DUNSTON LTD. It is not to be Traced, Copied or Published without their Written Consent, nor is the information thereon to be misused in any way.

ARD No. S466 DRG. No. 4500/278/2

TITLE: GENERAL ARRANGEMENT (AS FITTED)

SCALE: 1/4" TO ONE FOOT

004418-004425-0016

BRITISH CORPORATION REGISTER  
OF SHIPPING, HULL

Part 1  
Lloyd's Register  
Foundation



RECEIVED

1

General Arrgt [Sheet 1]

Sh Qunston Ltd

No 1166.

AS BUILT

30 MAY 1945

EMPIRE SEAHAWK now SEREMBAN

GA(1)  
#66.

004418-004425-0016



© 2020

Lloyd's Register  
Foundation