
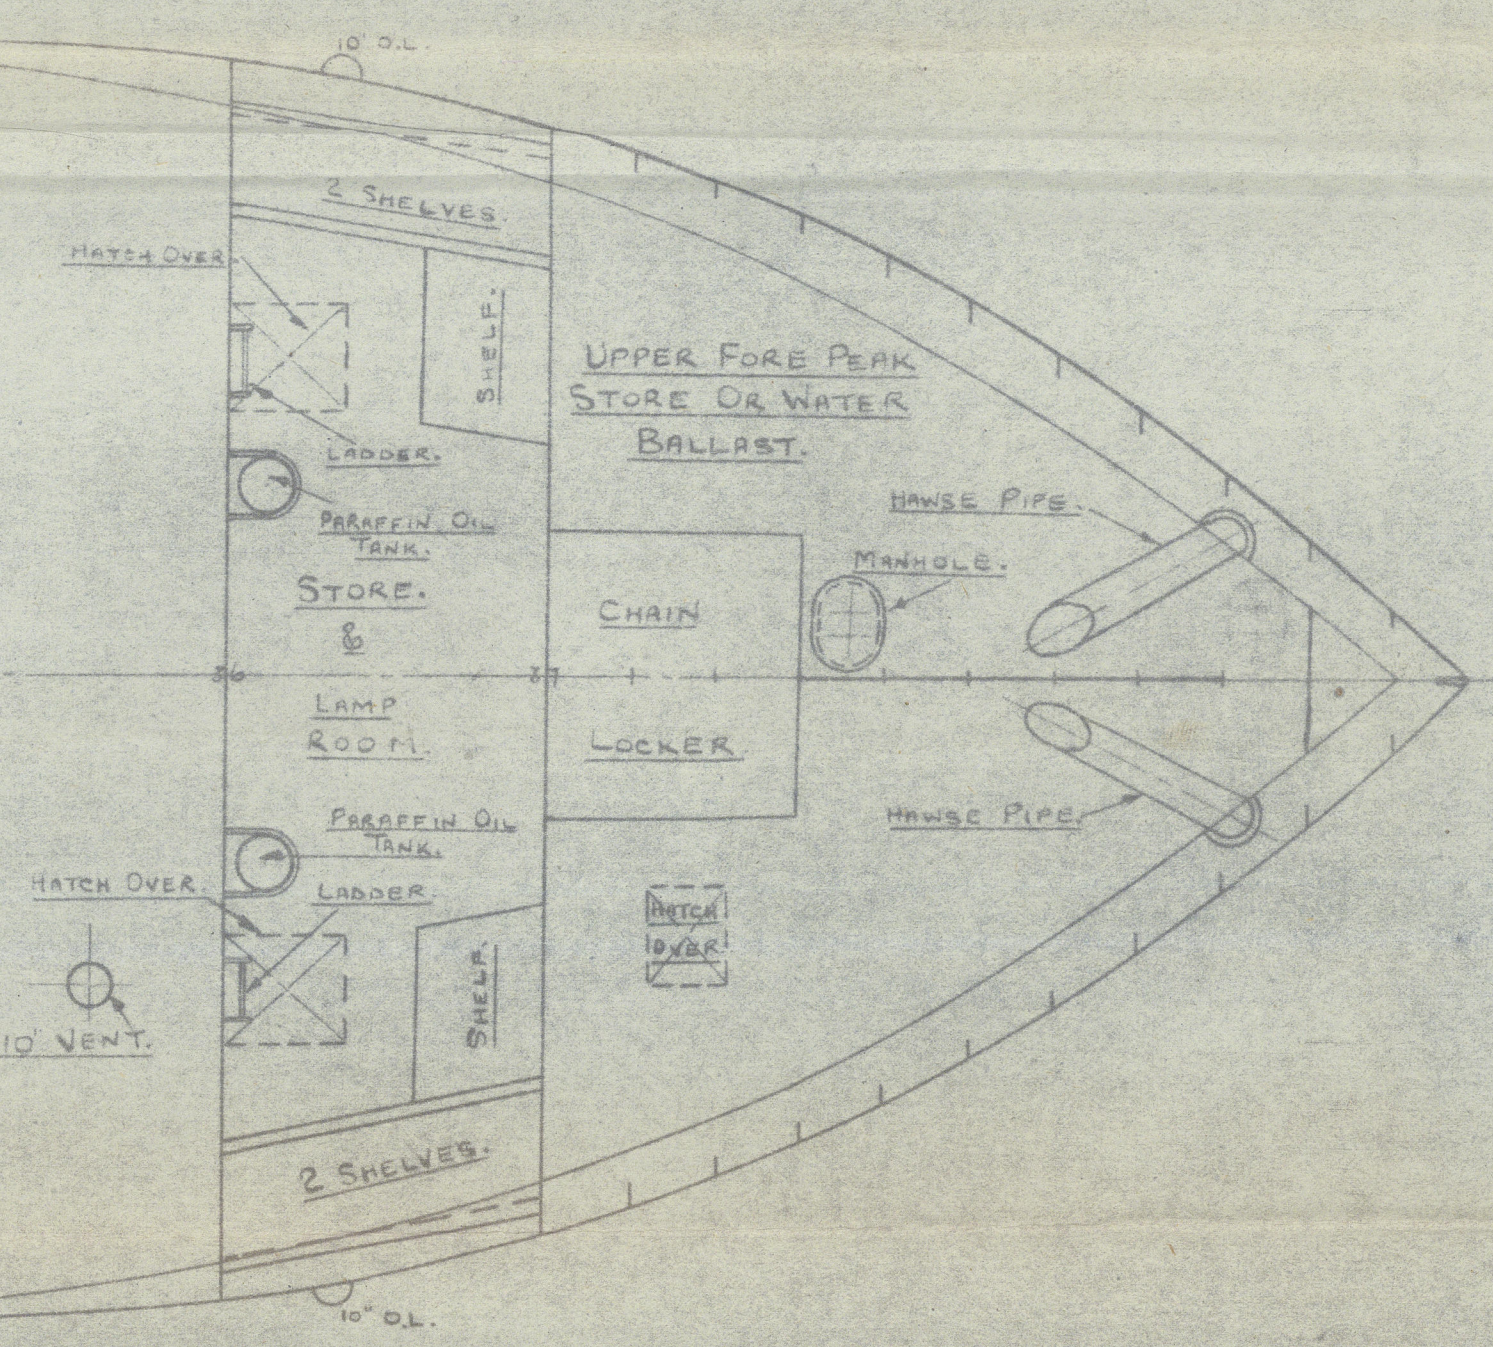
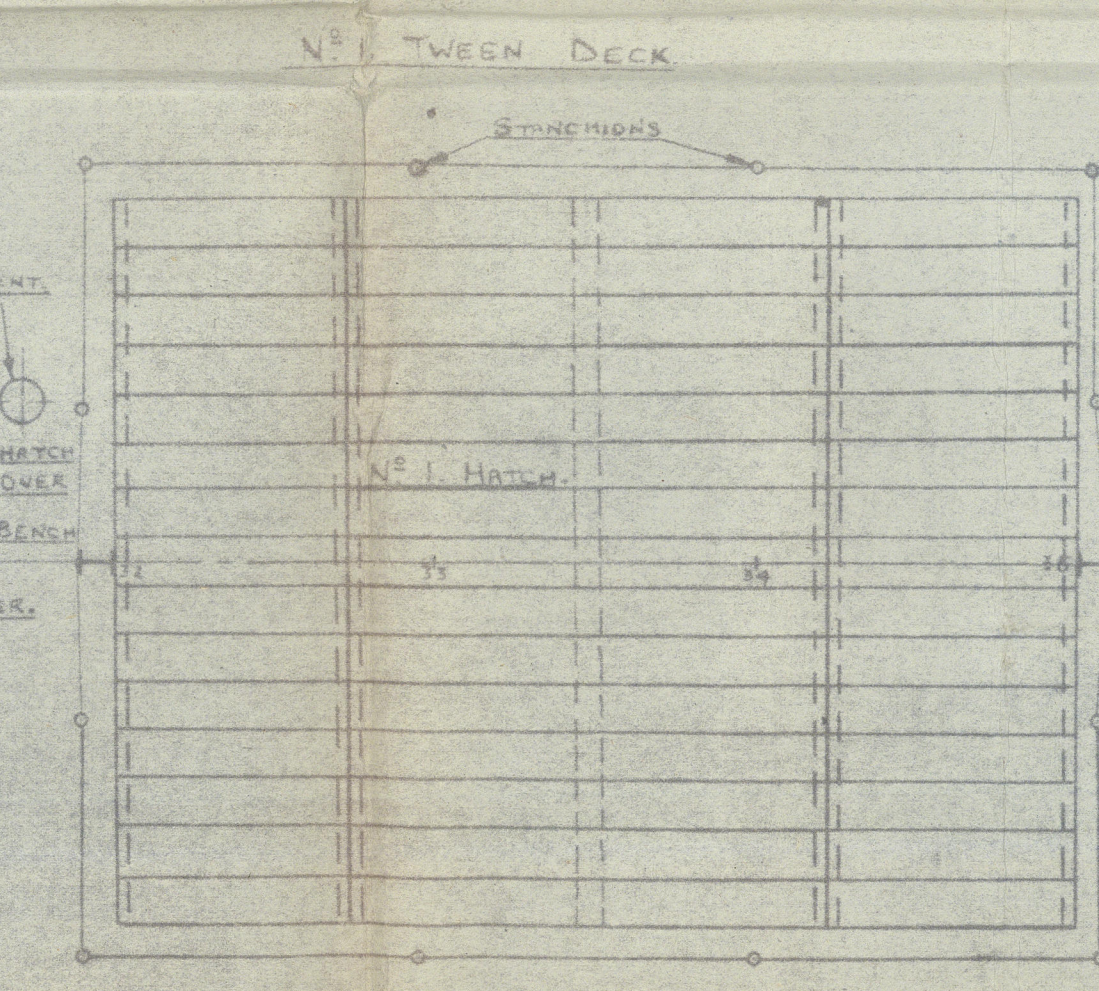
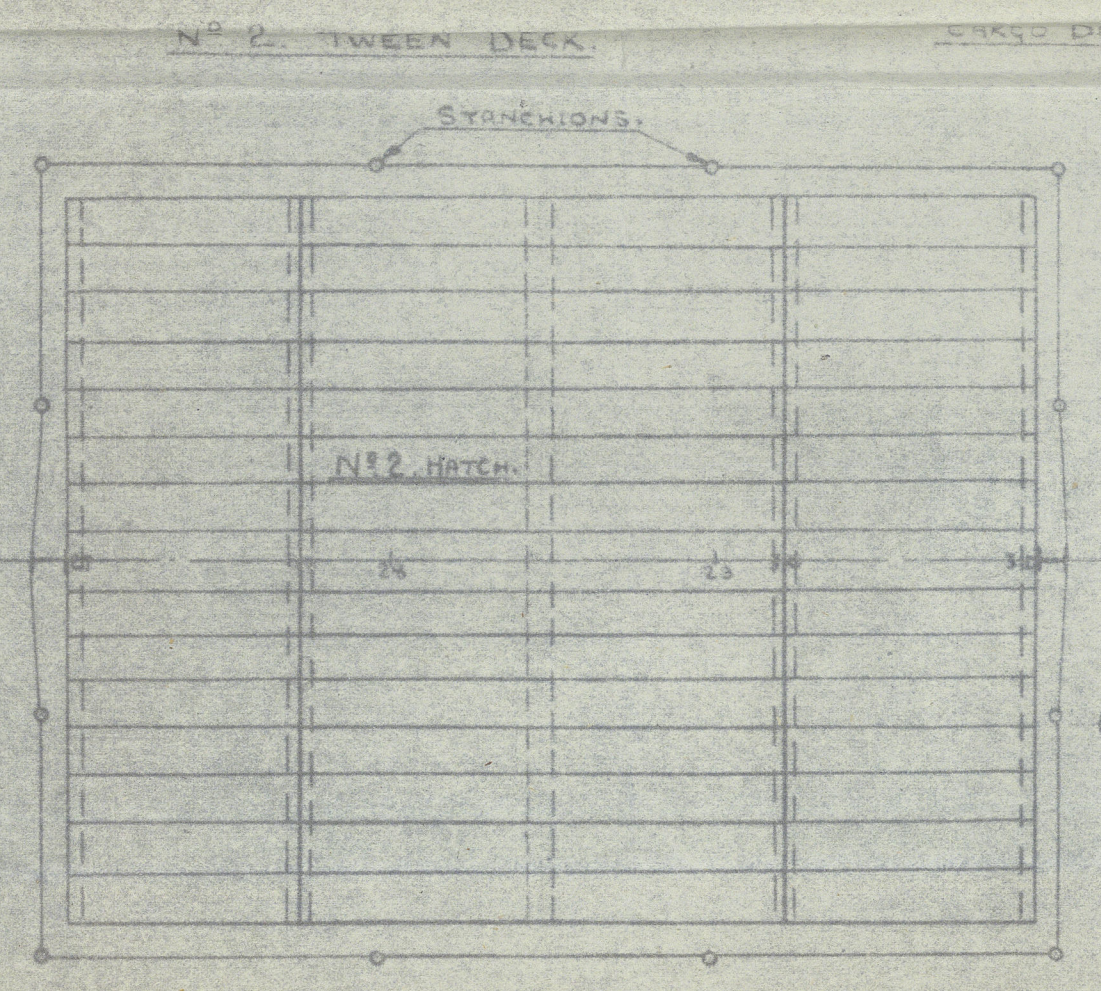


Hand-drawn floor plan of the USS Intrepid (MCMC-1) showing various compartments and equipment. The plan includes labels for areas like the Bridge, Main Deck, and various storage and utility spaces. Key features include the 24'0" x 8'0" x 3'4" Lifeslot, the 24'0" x 8'0" x 3'4" Motor Boat, and the 24'0" x 8'0" x 3'4" Lifeslot. The plan also shows the location of various equipment, including the Main Deck, Main Deck, and Main Deck. The plan is titled "PLAN OF USS INTREPID (MCMC-1)" and is dated "1964".

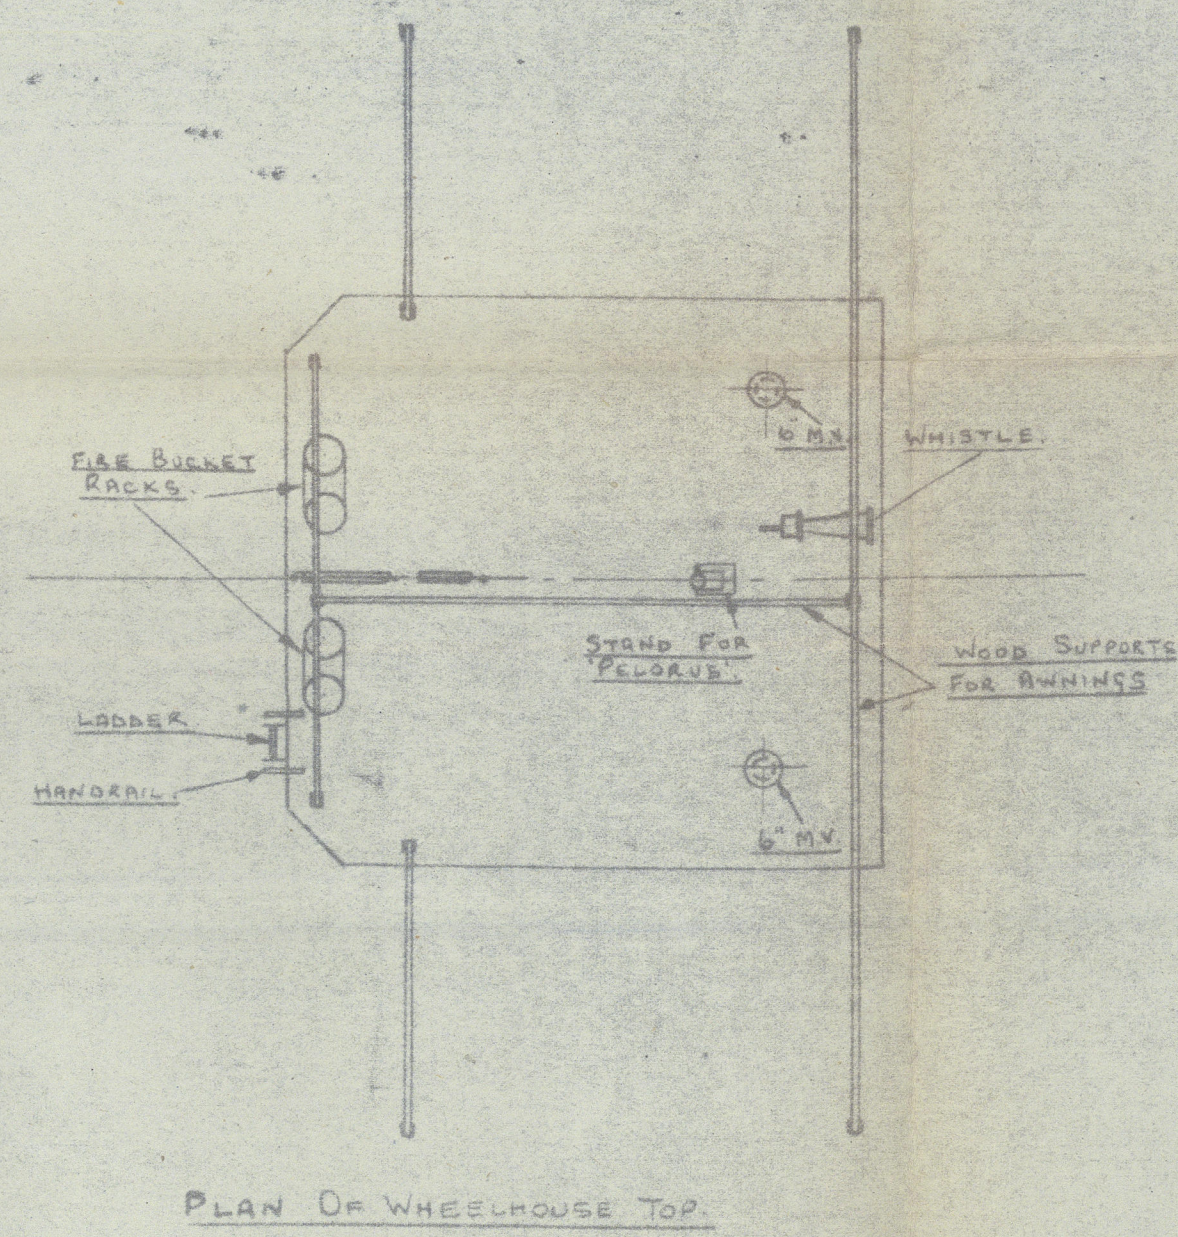

BRITISH CORPORATION REGISTER
OF SHIPPING, HULL.

"EMPIRE SEAHAWK"
A/M.S. NO. 112.

<h1>RICHARD DUNSTON LTD.</h1> <p>SHIPBUILDERS, THORNE, YORKSHIRE</p>	DRAWN BY <u>D.H.</u> DATE <u>12-3-95</u> TRACED BY <u>D.H.</u> DATE <u>20-3-95</u> CHECKED BY <u>A.K.B.</u> DATE <u>27-3-95</u>	This Drawing and the Information it contains are the Property of RICHARD DUNSTON LTD. It is not to be Traced, Copied or Published without their Written Consent, nor is the Information thereon to be misused in any way.												
	REVISIONS <table border="1"> <thead> <tr> <th>NR.</th> <th>DATE</th> <th>PARTICULARS</th> </tr> </thead> <tbody> <tr><td> </td><td> </td><td> </td></tr> <tr><td> </td><td> </td><td> </td></tr> <tr><td> </td><td> </td><td> </td></tr> </tbody> </table>	NR.	DATE	PARTICULARS										YARD No. <u>S.466</u> DRG. No. <u>4500/2782</u>
	NR.	DATE	PARTICULARS											
TITLE: <u>GENERAL ARRANGEMENT (AS FITTED)</u> SCALE: <u>1/4"</u> TO ONE FOOT	© 2020 Lloyd's Register Foundation													
001110-001115-0017														

RETAIN

2

General Arrgt

Mr Dunston Ltd

No 5166

AS BUILT

EMPIRE SEAHAWK NOW SEREMBAN.
30 MAY 1945

Ga(2)
#66

004418-004425-0017



© 2020

Lloyd's Register
Foundation